


SECTION A-A

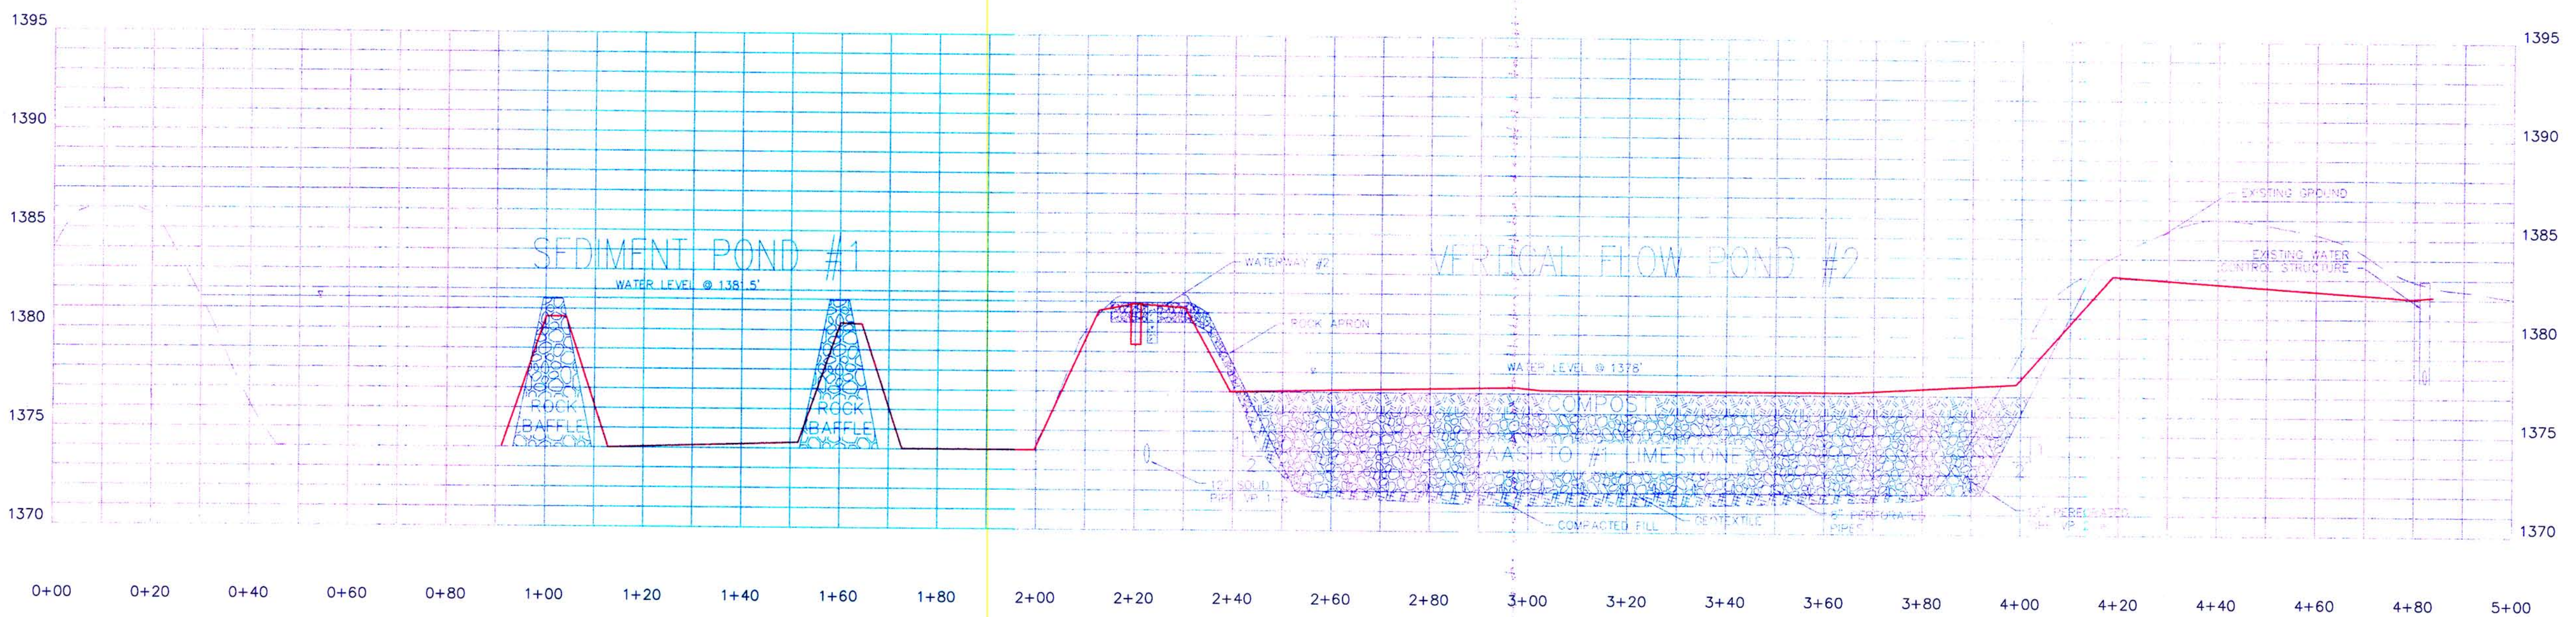


SECTION B-B

Date 1/8/08  
 Designed by D. LOPES  
 Drawn by D. LOPES  
 Checked by R. DECKI  
 Approved by \_\_\_\_\_

**SOMERSET TECHNICAL OFFICE**  
 6024 GLADES PIKE SUITE 105  
 SOMERSET, PENNSYLVANIA 15501  
 (814) 445-8979

**INDIAN CREEK WATERSHED-CALLENTINE SITE**  
**PL-566**  
 FALETTE COUNTY, PENNSYLVANIA  
**ASBUILT SECTIONS AA, BB**

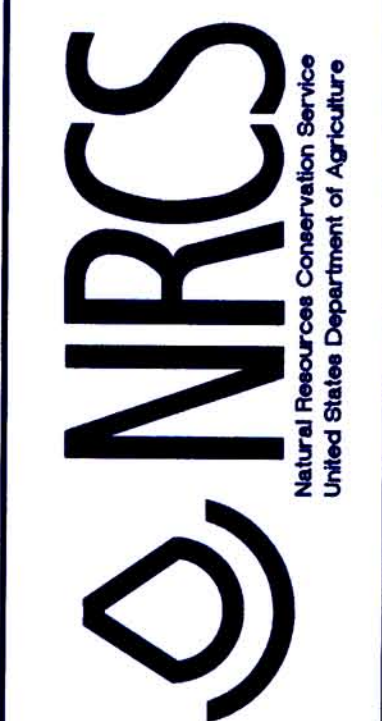

File No. \_\_\_\_\_  
 Drawing No. \_\_\_\_\_  
 Sheet No. 2 of 4