


SECTION C-C

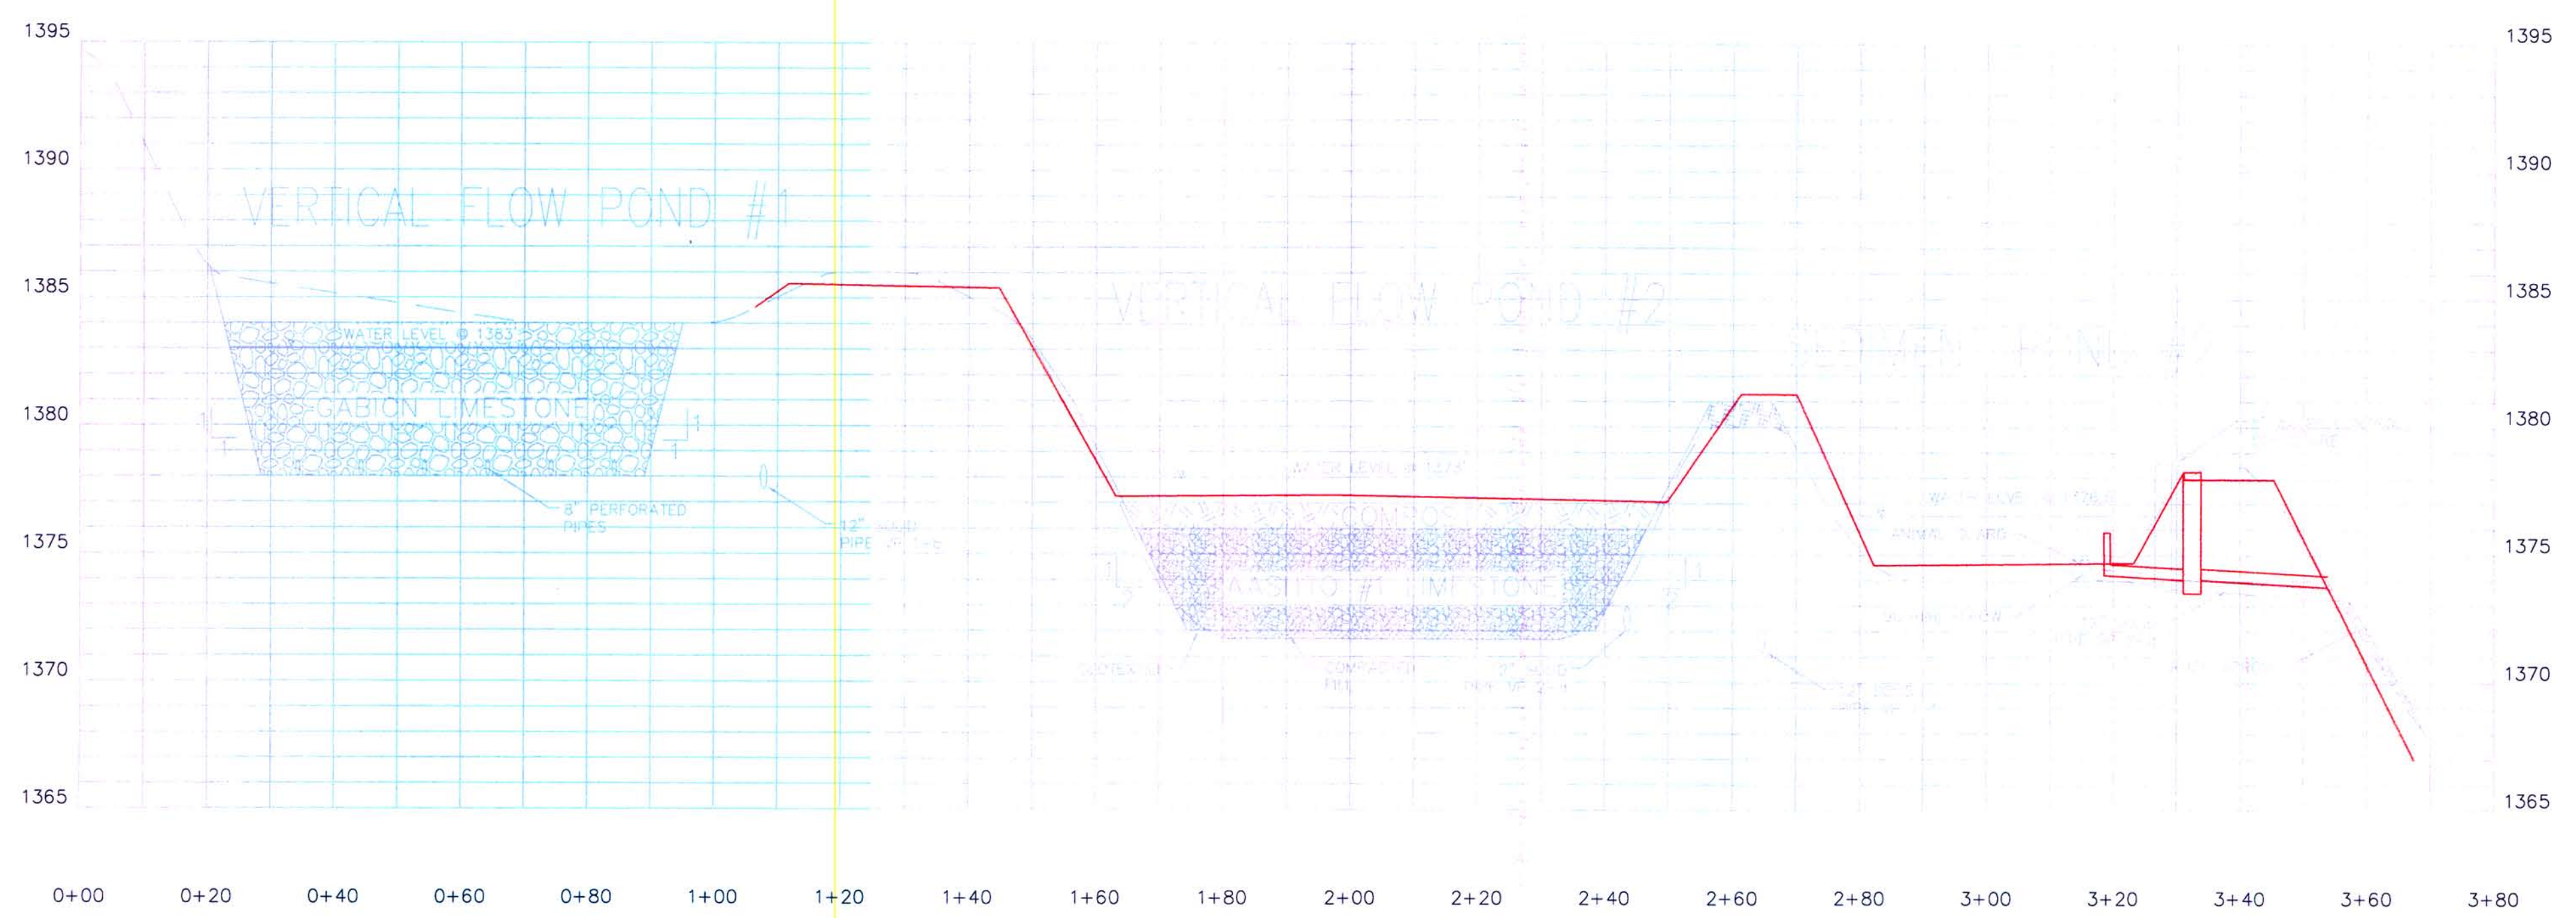


SECTION D-D

Date 1/8/08
 Designed by D. LOPES
 Drawn by D. LOPES
 Checked by R. DEECKI
 Approved by _____

SOMERSET TECHNICAL OFFICE
 6024 GLADES PIKE SUITE 105
 SOMERSET, PENNSYLVANIA 15501
 (814) 445-8979

INDIAN CREEK WATERSHED-CALLENTINE SITE
 PL-566
 FAYETTE COUNTY, PENNSYLVANIA
ASBUILT SECTIONS CC, DD

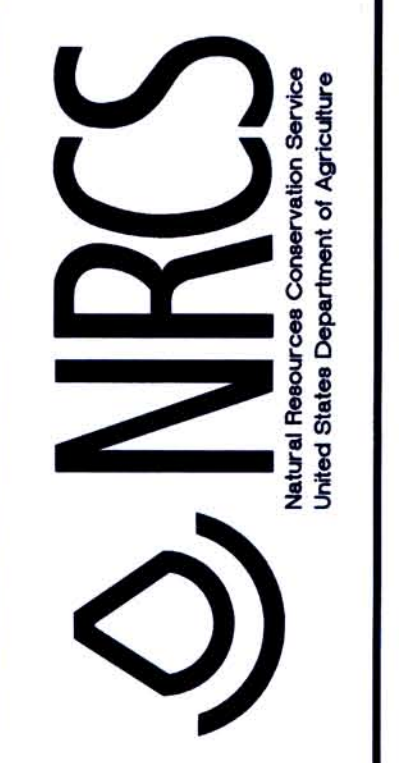

File No. _____
 Drawing No. _____
 Sheet No. 3 of 4