

O&M INSPECTION REPORT

Weather (circle one): Snow Heavy Rain Rain Light Rain Overcast Fair/Sunny **Temp(°F):** <32 33-40 41-50 51-60 60+

A. Site Vegetation

B. Site Access and Parking

C. Vandalism and Housekeeping

D. Spillways (check if Yes)

E. Passive Treatment Components (Check if Yes)

Describe Maintenance Performed or Needed:


Depth to Water in Siphon Vault.: _____ ft *Before* monitoring _____ feet *After* monitoring Did the Siphon Flush during inspection? _____

[illegible]


O&M SCHEMATIC
MONTGOMERY RUN
WATERSHED ASSOCIATION
MCCASLIN ROAD
MINE DRAINAGE TREATMENT

WEST FORK ENLOW RUN SUBWATERSHED
MONTGOMERY RUN WATERSHED
FINDLAY TOWNSHIP, ALLEGHENY COUNTY, PA
Scale: As Shown June 2010
BioMost, Inc., Mining and Reclamation Services
Mars, Pennsylvania www.biomost.com

LEGEND

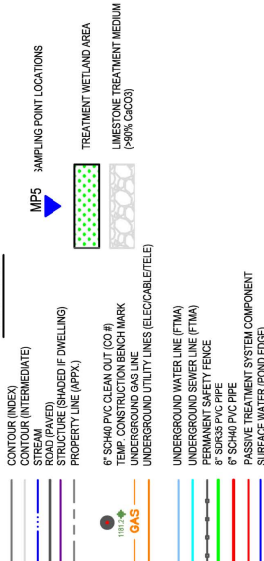


ELEVATION SCHEMATIC

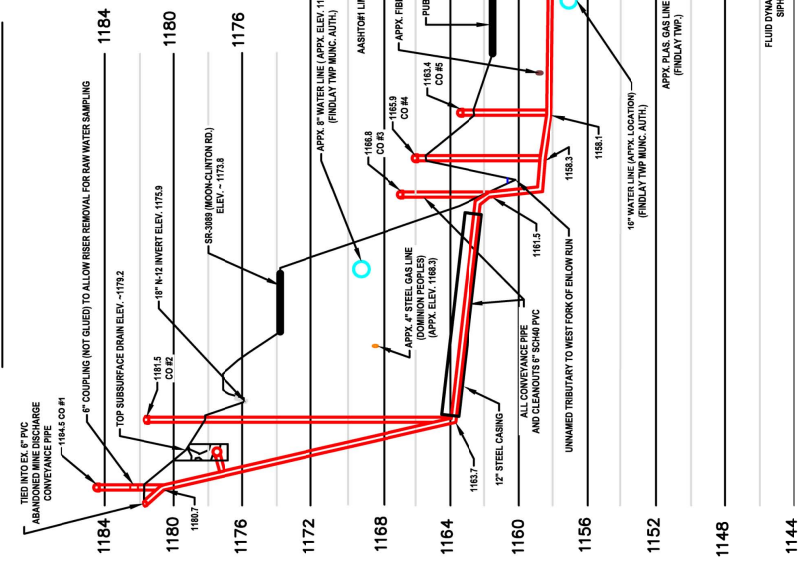


VERTICAL SCALE: AS SHOWN
HORIZONTAL SCALE: NONE

PLAN VIEW

**FOR BETTER QUALITY IMAGE
SEE: AS-BUILT SCHEMATIC**

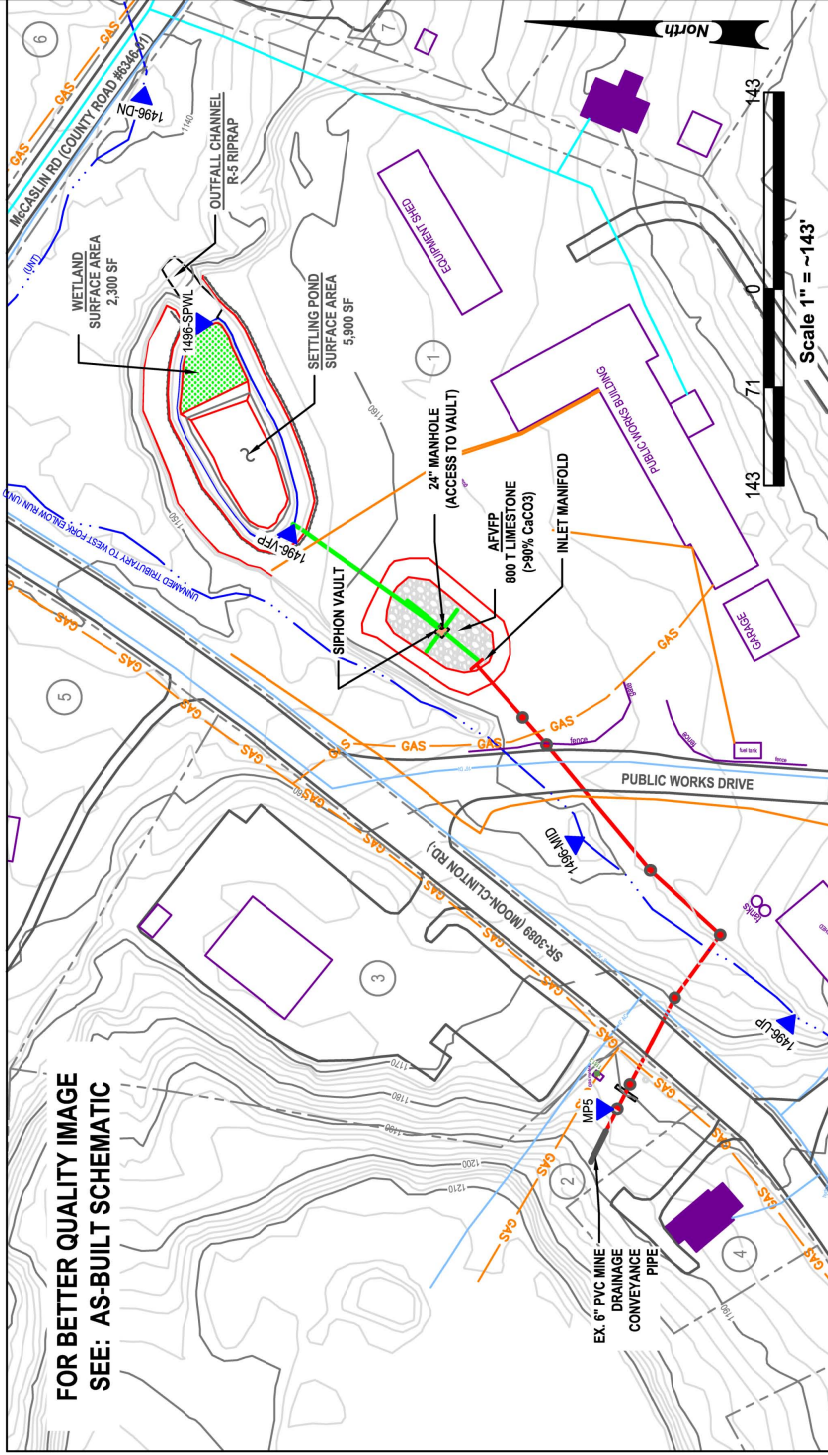

AUTO FLUSHING VERTICAL FLOW POND (AFVFP)

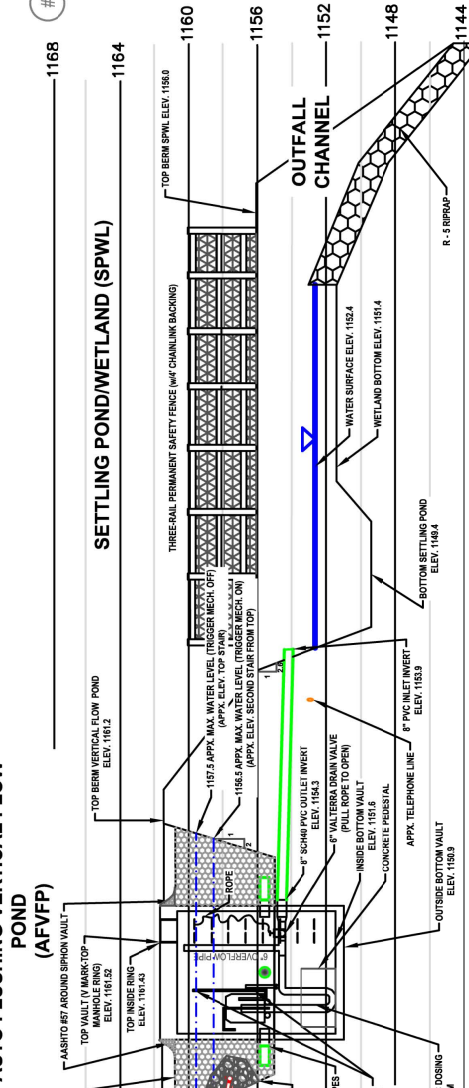

- PROPERTY OWNERS**
1. TOWNSHIP OF FINDLAY
 2. PRECISION KNOX STEEL CO. INC.
 3. MONTGOMERY RUN WATERSHED ASSOCIATION
 4. MONTGOMERY RUN WATERSHED ASSOCIATION
 5. MONTGOMERY RUN WATERSHED ASSOCIATION
 6. MONTGOMERY RUN WATERSHED ASSOCIATION
 7. MONTGOMERY RUN WATERSHED ASSOCIATION

NOTES:
As-built information from 06/24/10 field inspection by Biomost, Inc. using 1\"/>