

THESE SYMBOLS WILL BE
USED IN THE DRAWING.

— — — CURTAIN DRAIN

 GATE VALVE LOCATION

 UTILITY POLE

○ — ○ GUIDE RAIL

LIVE STAKES SPACED AT 1-3'
1,482 LIVE STAKES INCLUDE

ARROWWOOD
SILKY DOGWOOD
NANNY BERRY
SANDBAR WILLOW

BM NO.	ELEVATION	DESCRIPTION	N. COORDINATE	E. COORDINATE
DEP-1	1410.72	5/8" REBAR WITH CAP	263939.90	1505869.85
DEP-2	1404.83	5/8" REBAR WITH CAP	264686.33	1507677.21
T-1002	1429.69	HUB & TACK	264677.18	1507268.82
T-1007	1413.11	HUB & TACK	264565.85	1507450.90
HVP1-2	1407.59	LONE TREE	263659.13	1505652.35


CONTRACT # AG-2D37-C-06-0004

CONSTRUCTION DATES; SEPT. 8 2006 TO DEC. 10 2007

CONTRACTOR; STOY EXCAVATING INC.

DOLLAR AMOUNT; \$1,794,726.17

COR; DAVID LOPES

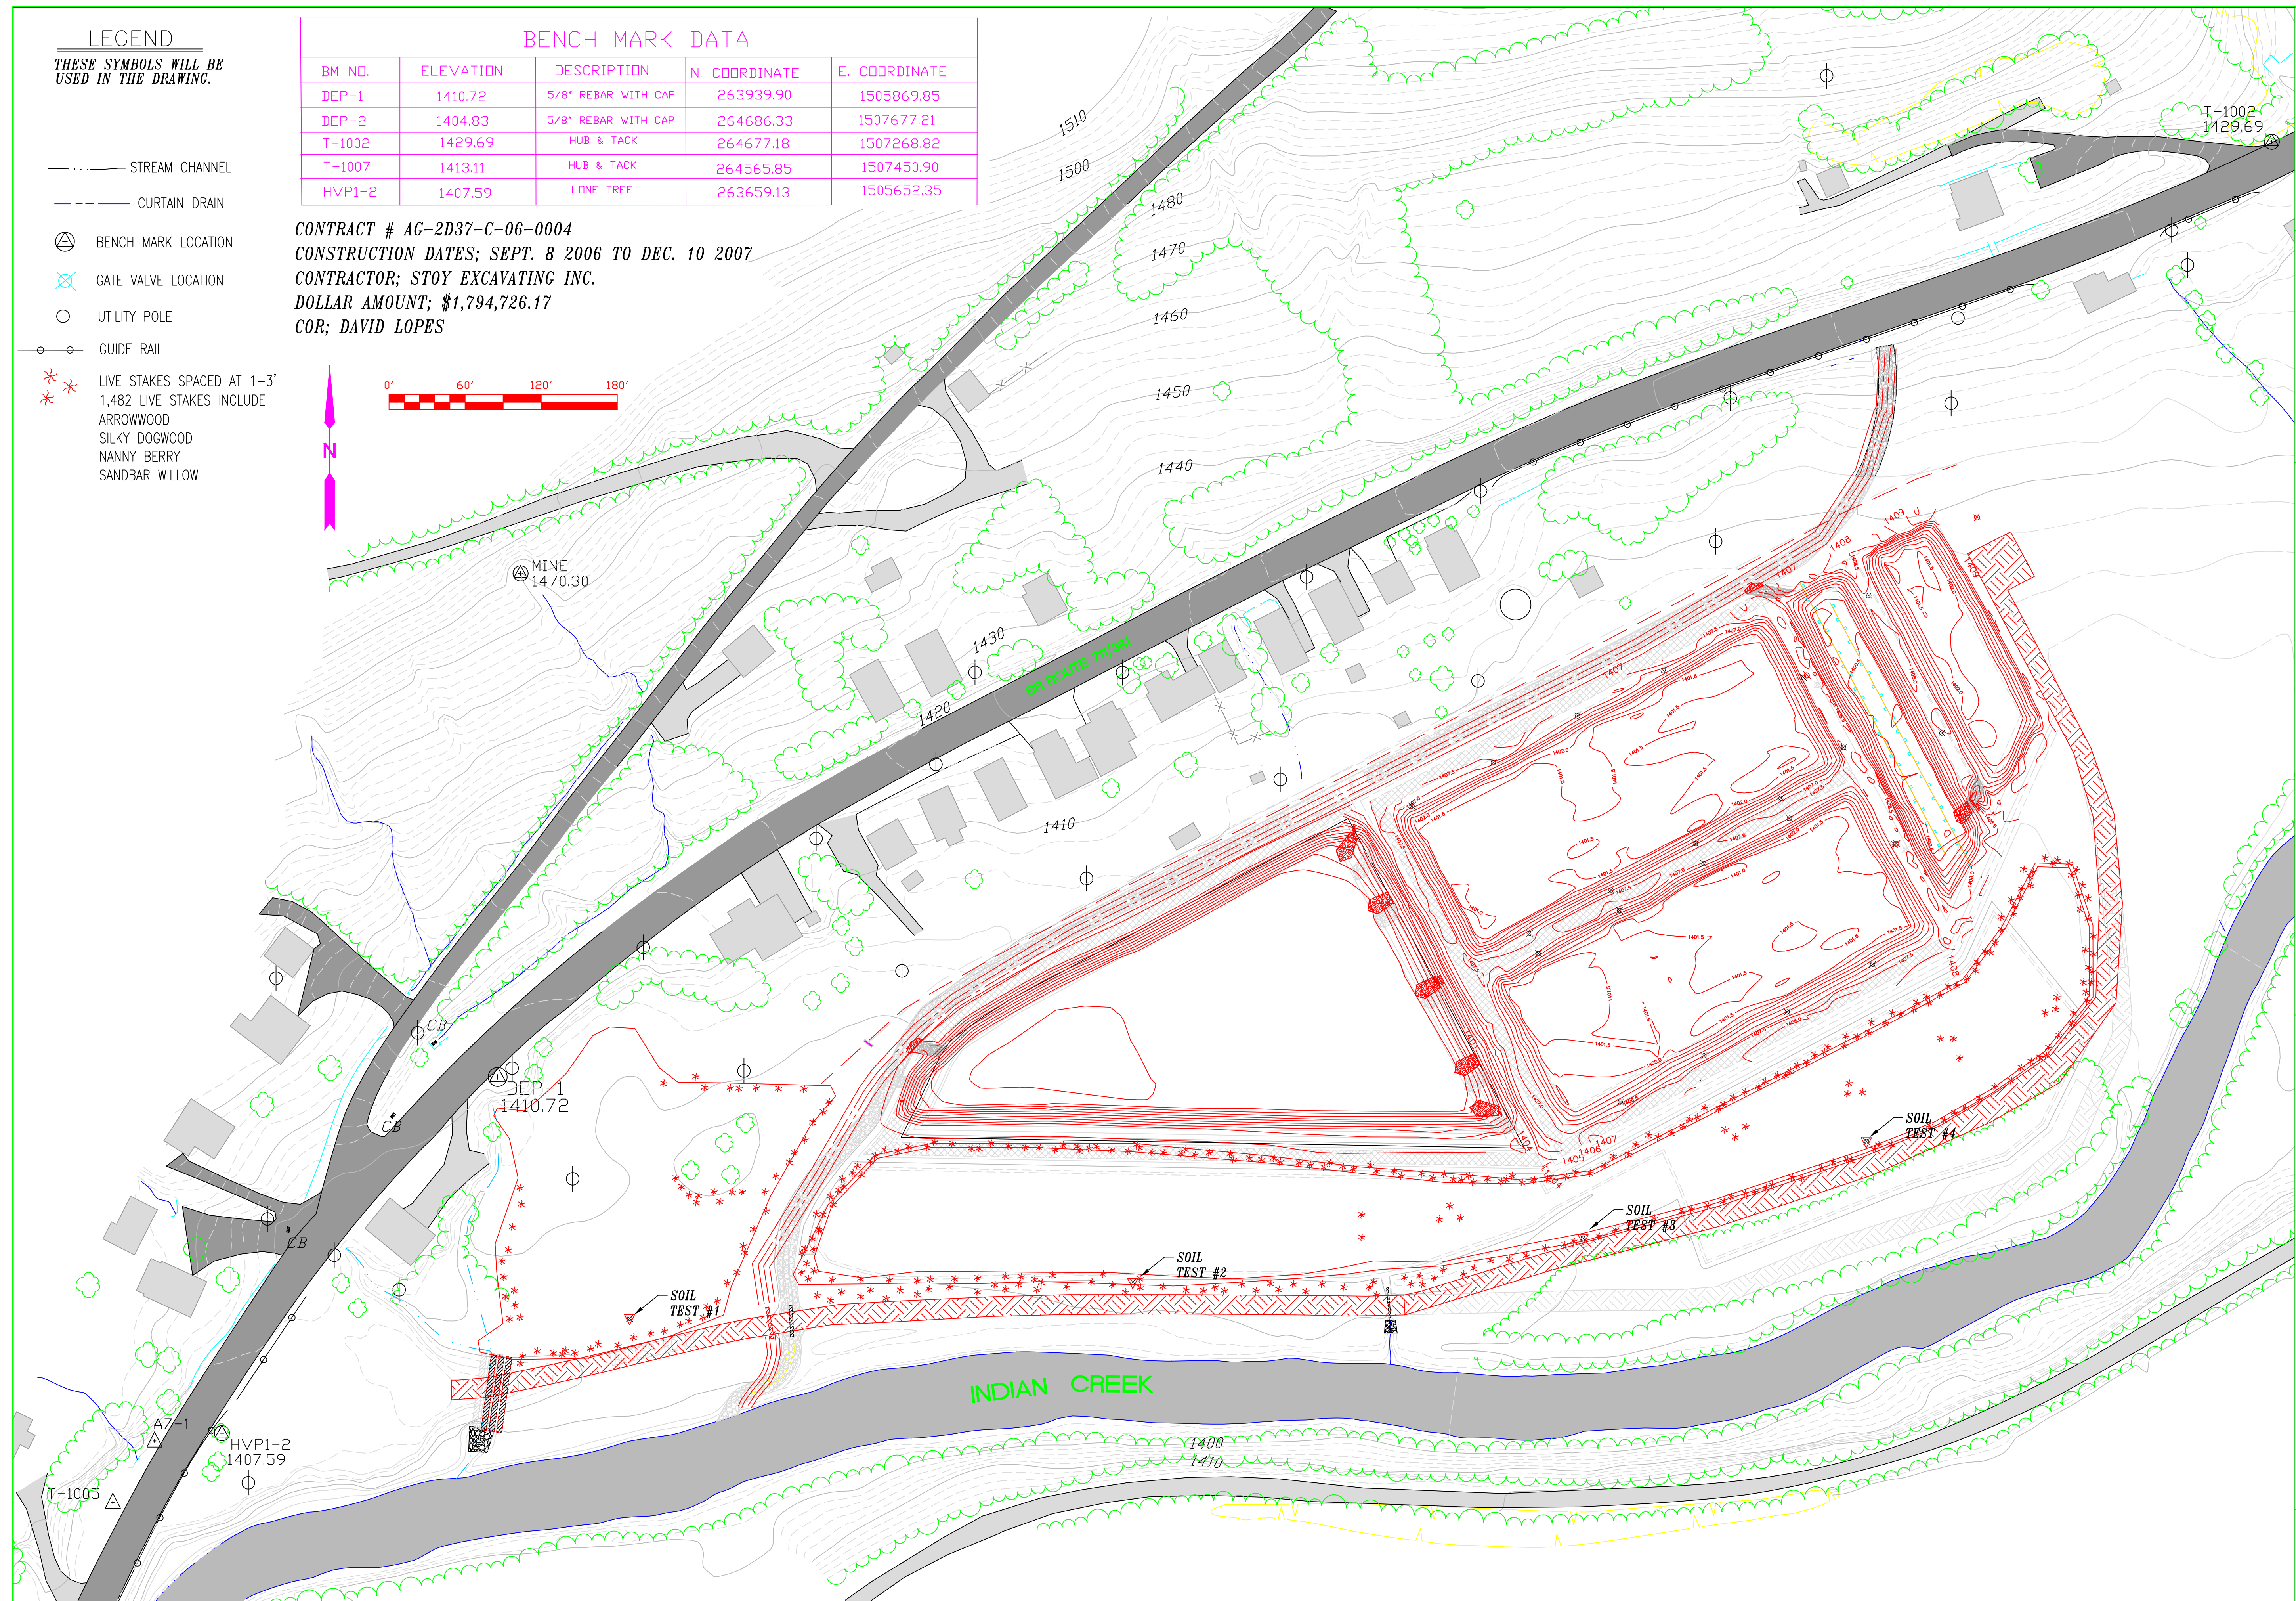


INDIAN CREEK WATERSHED-KALP SITE

PL-566

FAYETTE COUNTY, PENNSYLVANIA

AS-BUILT PLAN VIEW

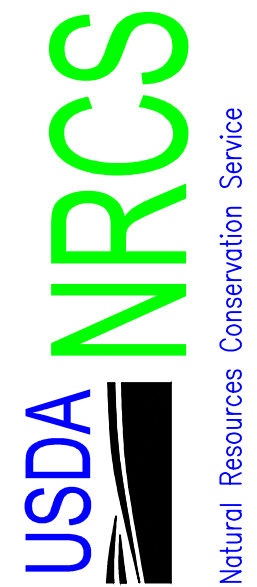

SOMERSET TECHNICAL OFFICE

6024 GLADES PIKE, SUITE 105
SOMERSET, PENNSYLVANIA 15501

Designed	Date	Approved by	Date
Drawn <i>D. LOPES</i>		<i>11/25/08</i>	
Revised			
Checked		Title	