


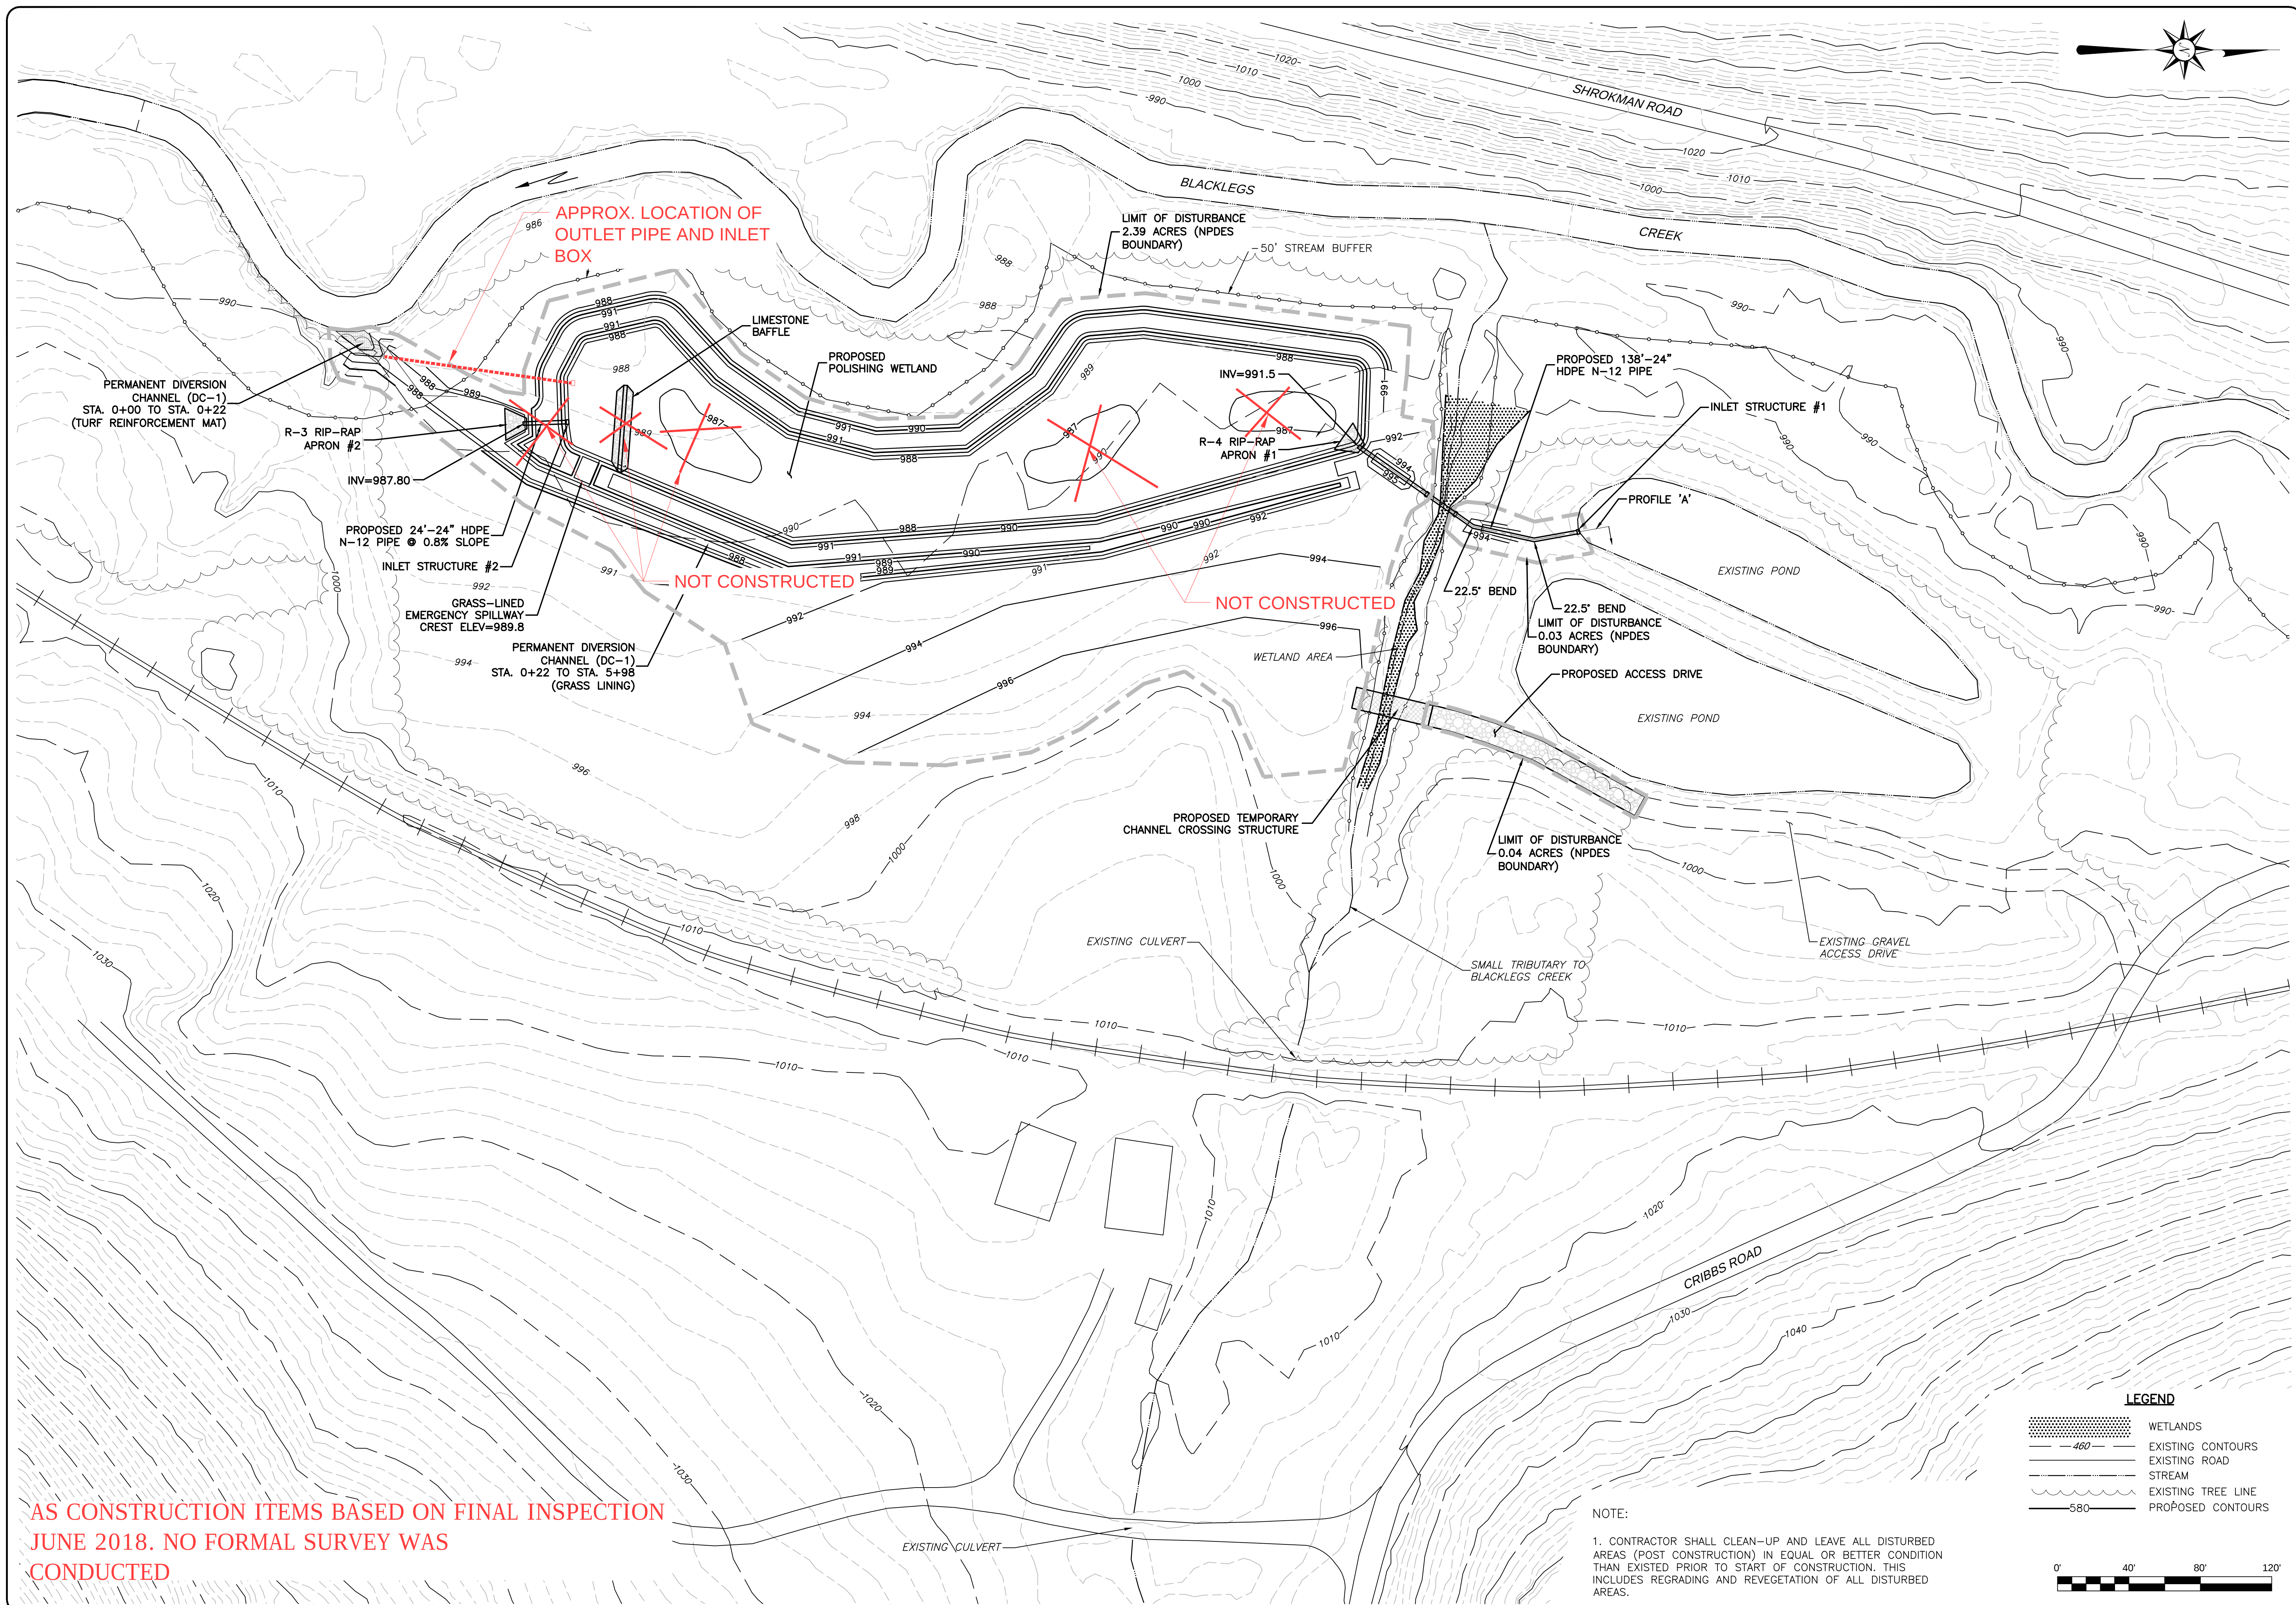

AS CONSTRUCTION ITEMS BASED ON FINAL INSPECTION
JUNE 2018. NO FORMAL SURVEY WAS
CONDUCTED

NOTE:

1. CONTRACTOR SHALL CLEAN-UP AND LEAVE ALL DISTURBED AREAS (POST CONSTRUCTION) IN EQUAL OR BETTER CONDITION THAN EXISTED PRIOR TO START OF CONSTRUCTION. THIS INCLUDES REGRADING AND REVEGETATION OF ALL DISTURBED AREAS.

LEGEND

	WETLANDS
	EXISTING CONTOURS
	EXISTING ROAD
	STREAM
	EXISTING TREE LINE
	PROPOSED CONTOURS

FILE:W:\Projects\2013 Projects and Proposals\IR13-0420.000 Blackleggs Creek - Kolb Wetland\CADD\BLACKLEGGS WETLAND PLANS as-built construction notes.dwg

DRAWING NO. **C-1**

SHEET 1 OF 5

KOLB POLISHING WETLAND PROJECT
FOR
BLACKLEGGS CREEK WATERSHED ASSOCIATION
BLACKLEGS CREEK
YOUNG TOWNSHIP
INDIANA COUNTY, PA

AS-CONSTRUCTED PLAN

DGN	DATE
B.A.S.	4/28/15
DFTSWN	
B.A.S.	4/28/15
CHKR	
T.W.S.	4/28/15
APPV	
SCALE	1"=40'

1	ADJUSTED GRADING	A/B	F/G	9/23/15	
REV					
	DESCRIPTION	BY	APPLY	DATE	

SKELLY AND LOY, INC.
ENGINEERS-ENVIRONMENTAL CONSULTANTS
449 EISENHOWER BOULEVARD, SUITE 300
HARRISBURG, PENNSYLVANIA 17111
(717)232-0593 (800)892-6532 FAX (717)232-1799

JOB NUMBER: R13-0420.000	DATE: APRIL 28 2015
------------------------------------	----------------------------------