


**NOTES:**

1. BASE MAPPING PREPARED BY LAND & MAPPING SERVICES, CLEARFIELD, PA. FROM MAPPING COMPILED BY PHOTOGRAMMETRIC METHODS FROM AERIAL PHOTOGRAPHY EXPOSED 04/16/09.
2. TOPOGRAPHY FOR THE LITTLE D AMD TREATMENT PROJECT AREA WAS COLLECTED 11/20/15 BY JOHN BLESCH, PLS. OF CLINTON COUNTY SOLID WASTE AUTHORITY.


**LEGEND**

- EXISTING CONTOURS (C.I.=1')
- EXISTING CONTOURS (C.I.=5')
- DESIGN GRADE (C.I.=1')
- DESIGN GRADE (C.I.=5')
- ASBUILT GRADE (C.I.=1')
- ASBUILT GRADE (C.I.=5')
- TREELINE
- STREAMS / CHANNELS
- SEEPAGE COLLECTION TRENCH

**LITTLE D PLAN VIEW**  
SCALE: 1" = 25'

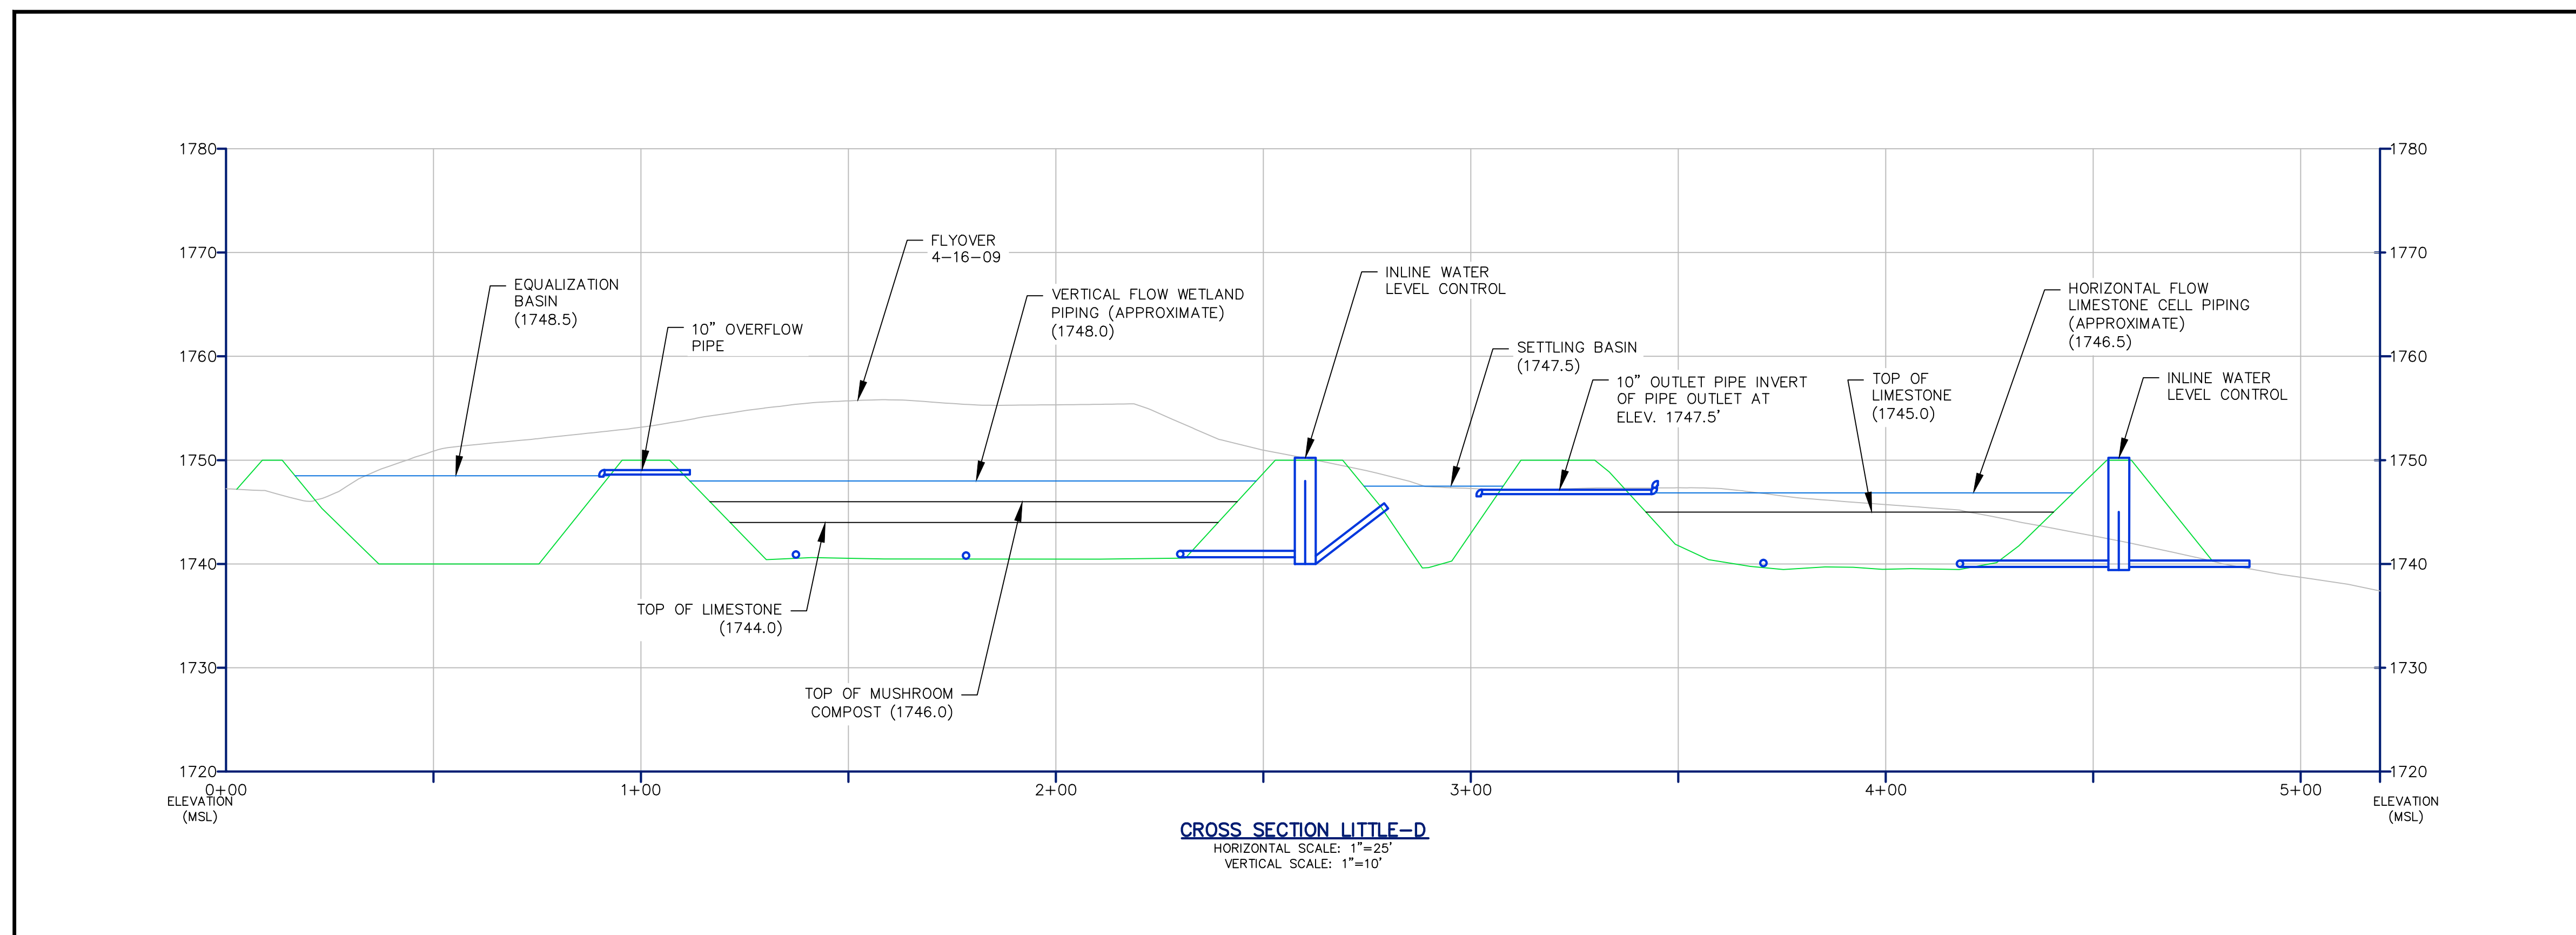

**CROSS SECTION LITTLE-D**  
HORIZONTAL SCALE: 1" = 25'  
VERTICAL SCALE: 1" = 10'

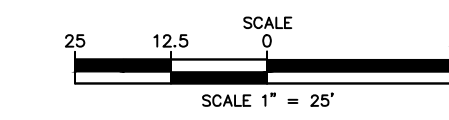

**DRAFT**

REVISIONS	

<p>Balanced Environmental Solutions</p>	<p><b>CLEARFIELD COUNTY</b> <b>CONSERVATION DISTRICT</b> <b>LITTLE D AMD TREATMENT PROJECT</b></p> <p>BOGGS TOWNSHIP CLEARFIELD COUNTY PENNSYLVANIA</p> <p><b>RECORD DRAWING</b></p>	<p>DATE: <b>8/30/16</b></p> <p>DRAWN BY: <b>SWH</b></p> <p>CHECKED: <b>PW</b></p> <p>BAI DRAWING NO: <b>CLFD-001D001</b></p>	
	<p>State College Office (814) 238-2060</p>	<p>Delaware Valley Office (610) 495-5585</p>	<p>SHEET NO. <b>1 OF 1</b></p>