


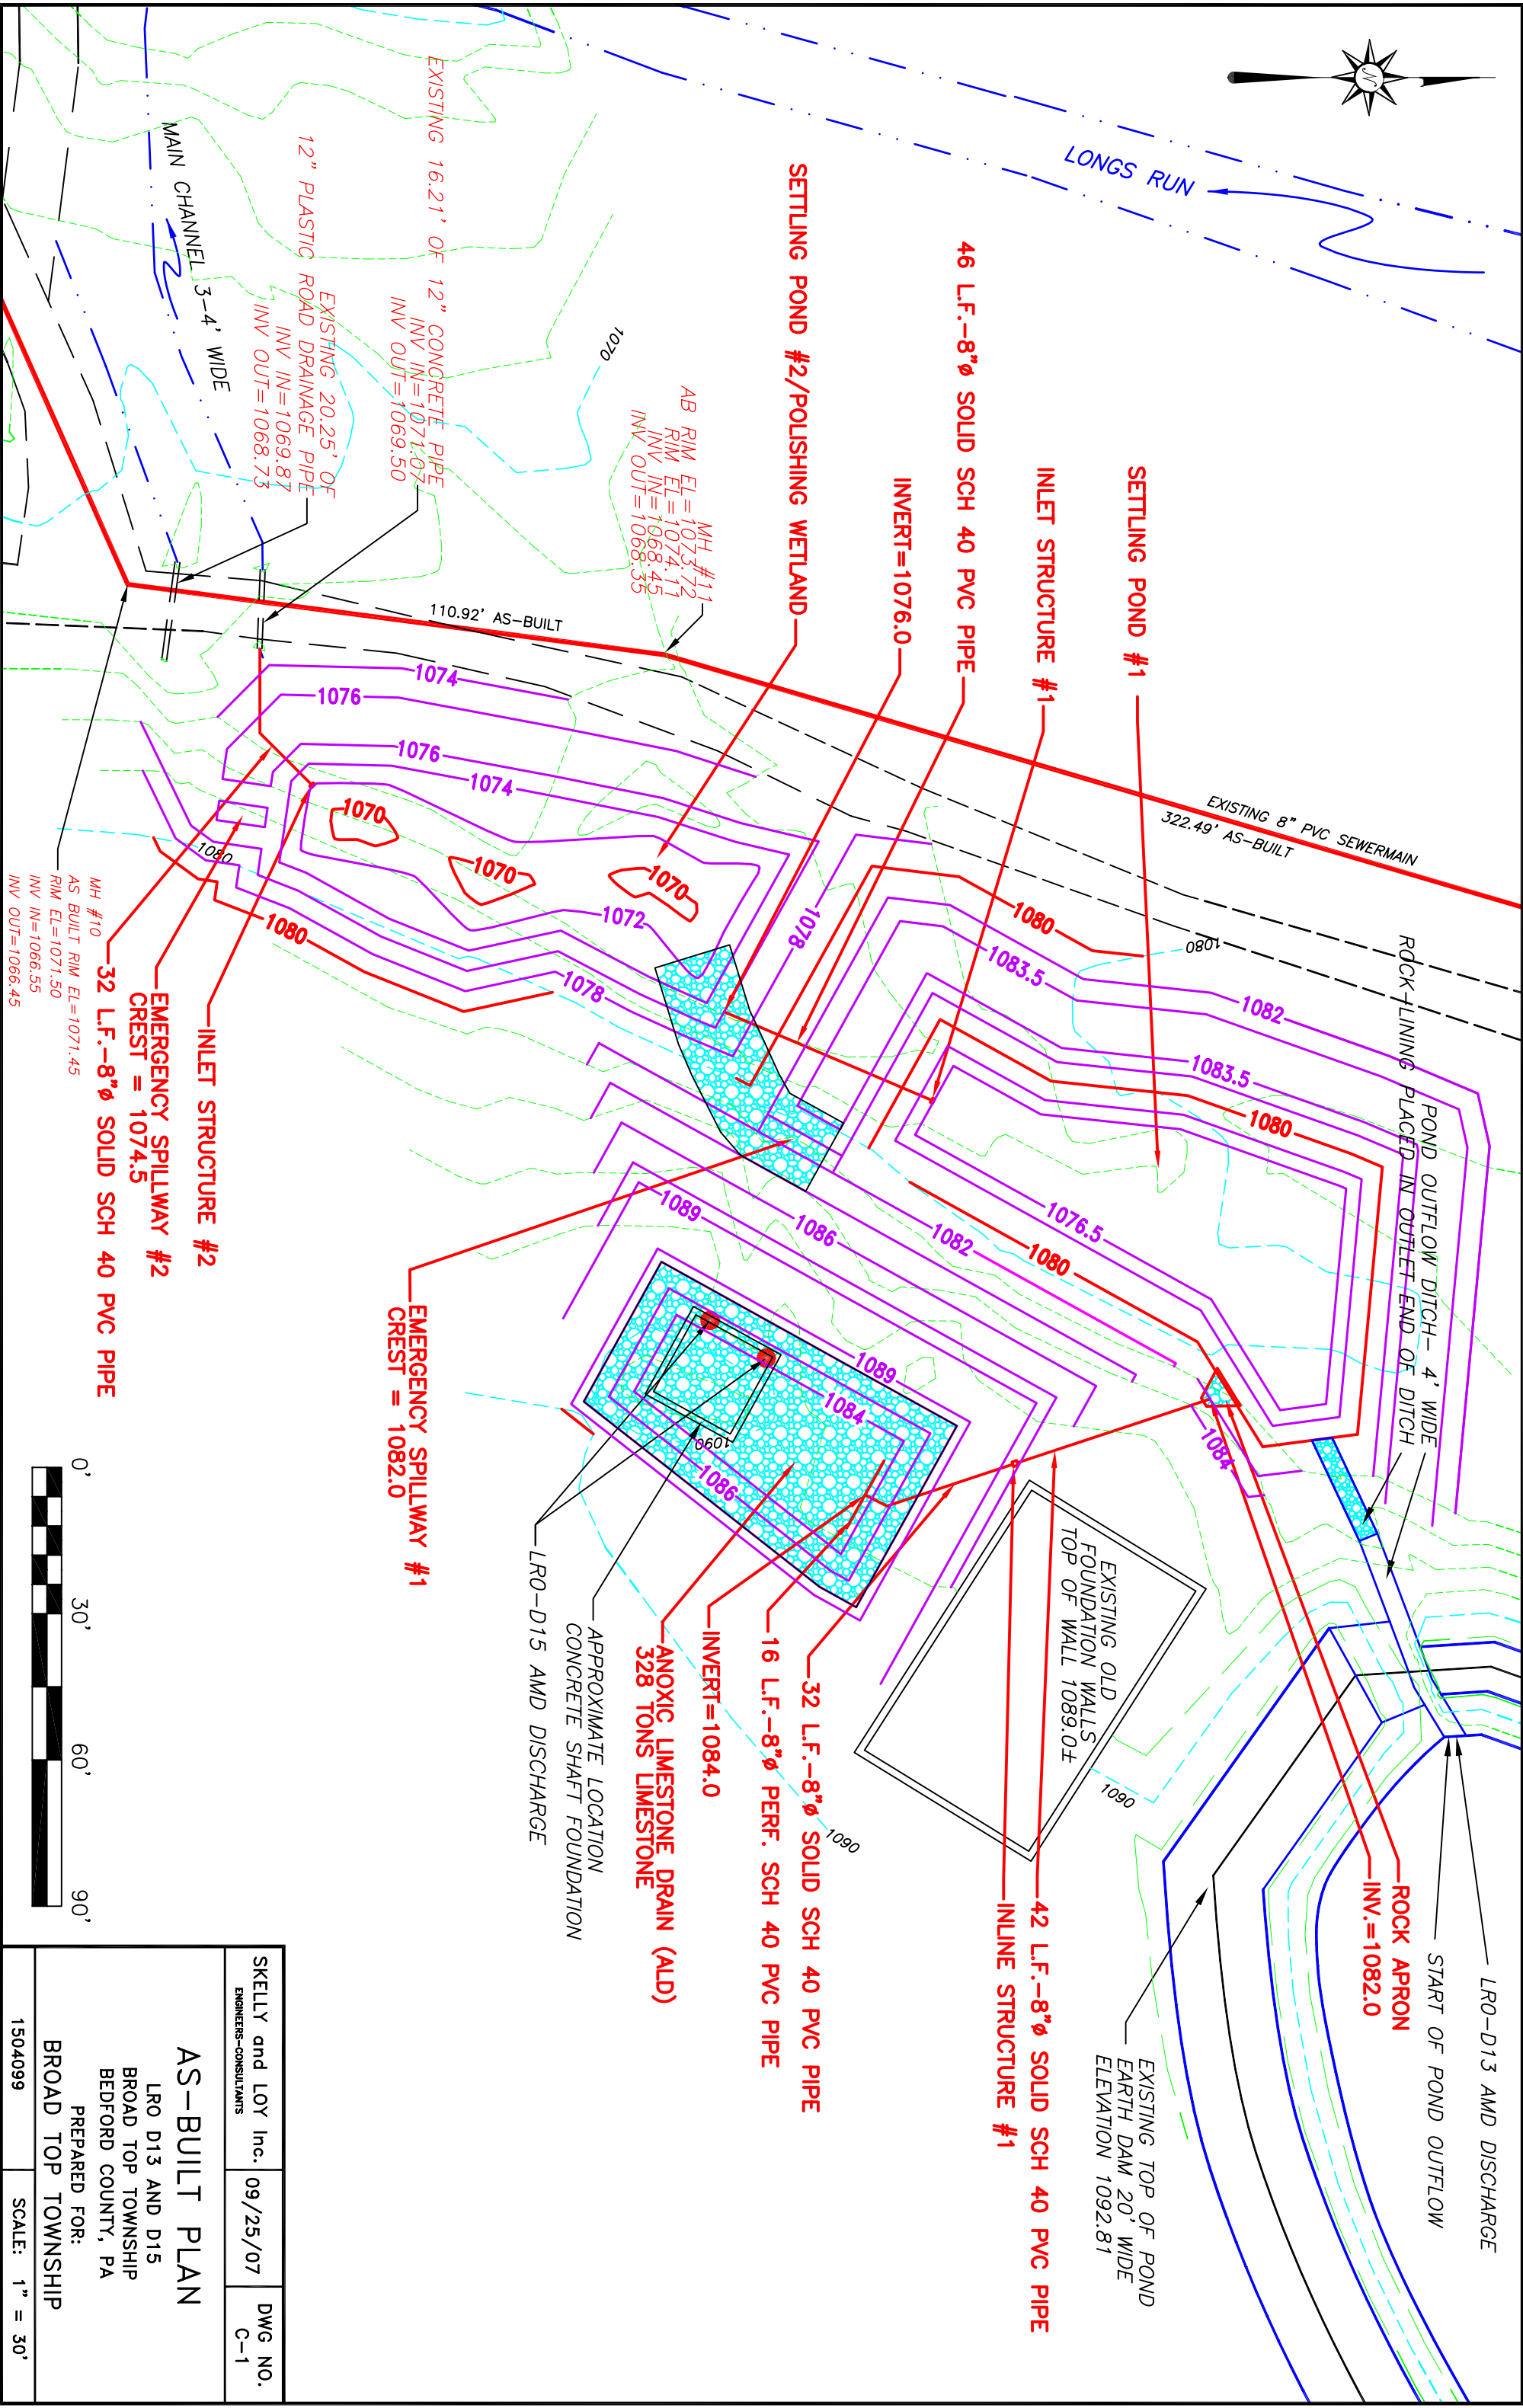

SKELLY and LOY Inc. ENGINEERS-CONSULTANTS	09/25/07	DWG NO. C-1

AS-BUILT PLAN

LR0 D13 AND D15
BROAD TOP TOWNSHIP
BEDFORD COUNTY, PA

PREPARED FOR:
BROAD TOP TOWNSHIP

1504099

SCALE: 1" = 30'