


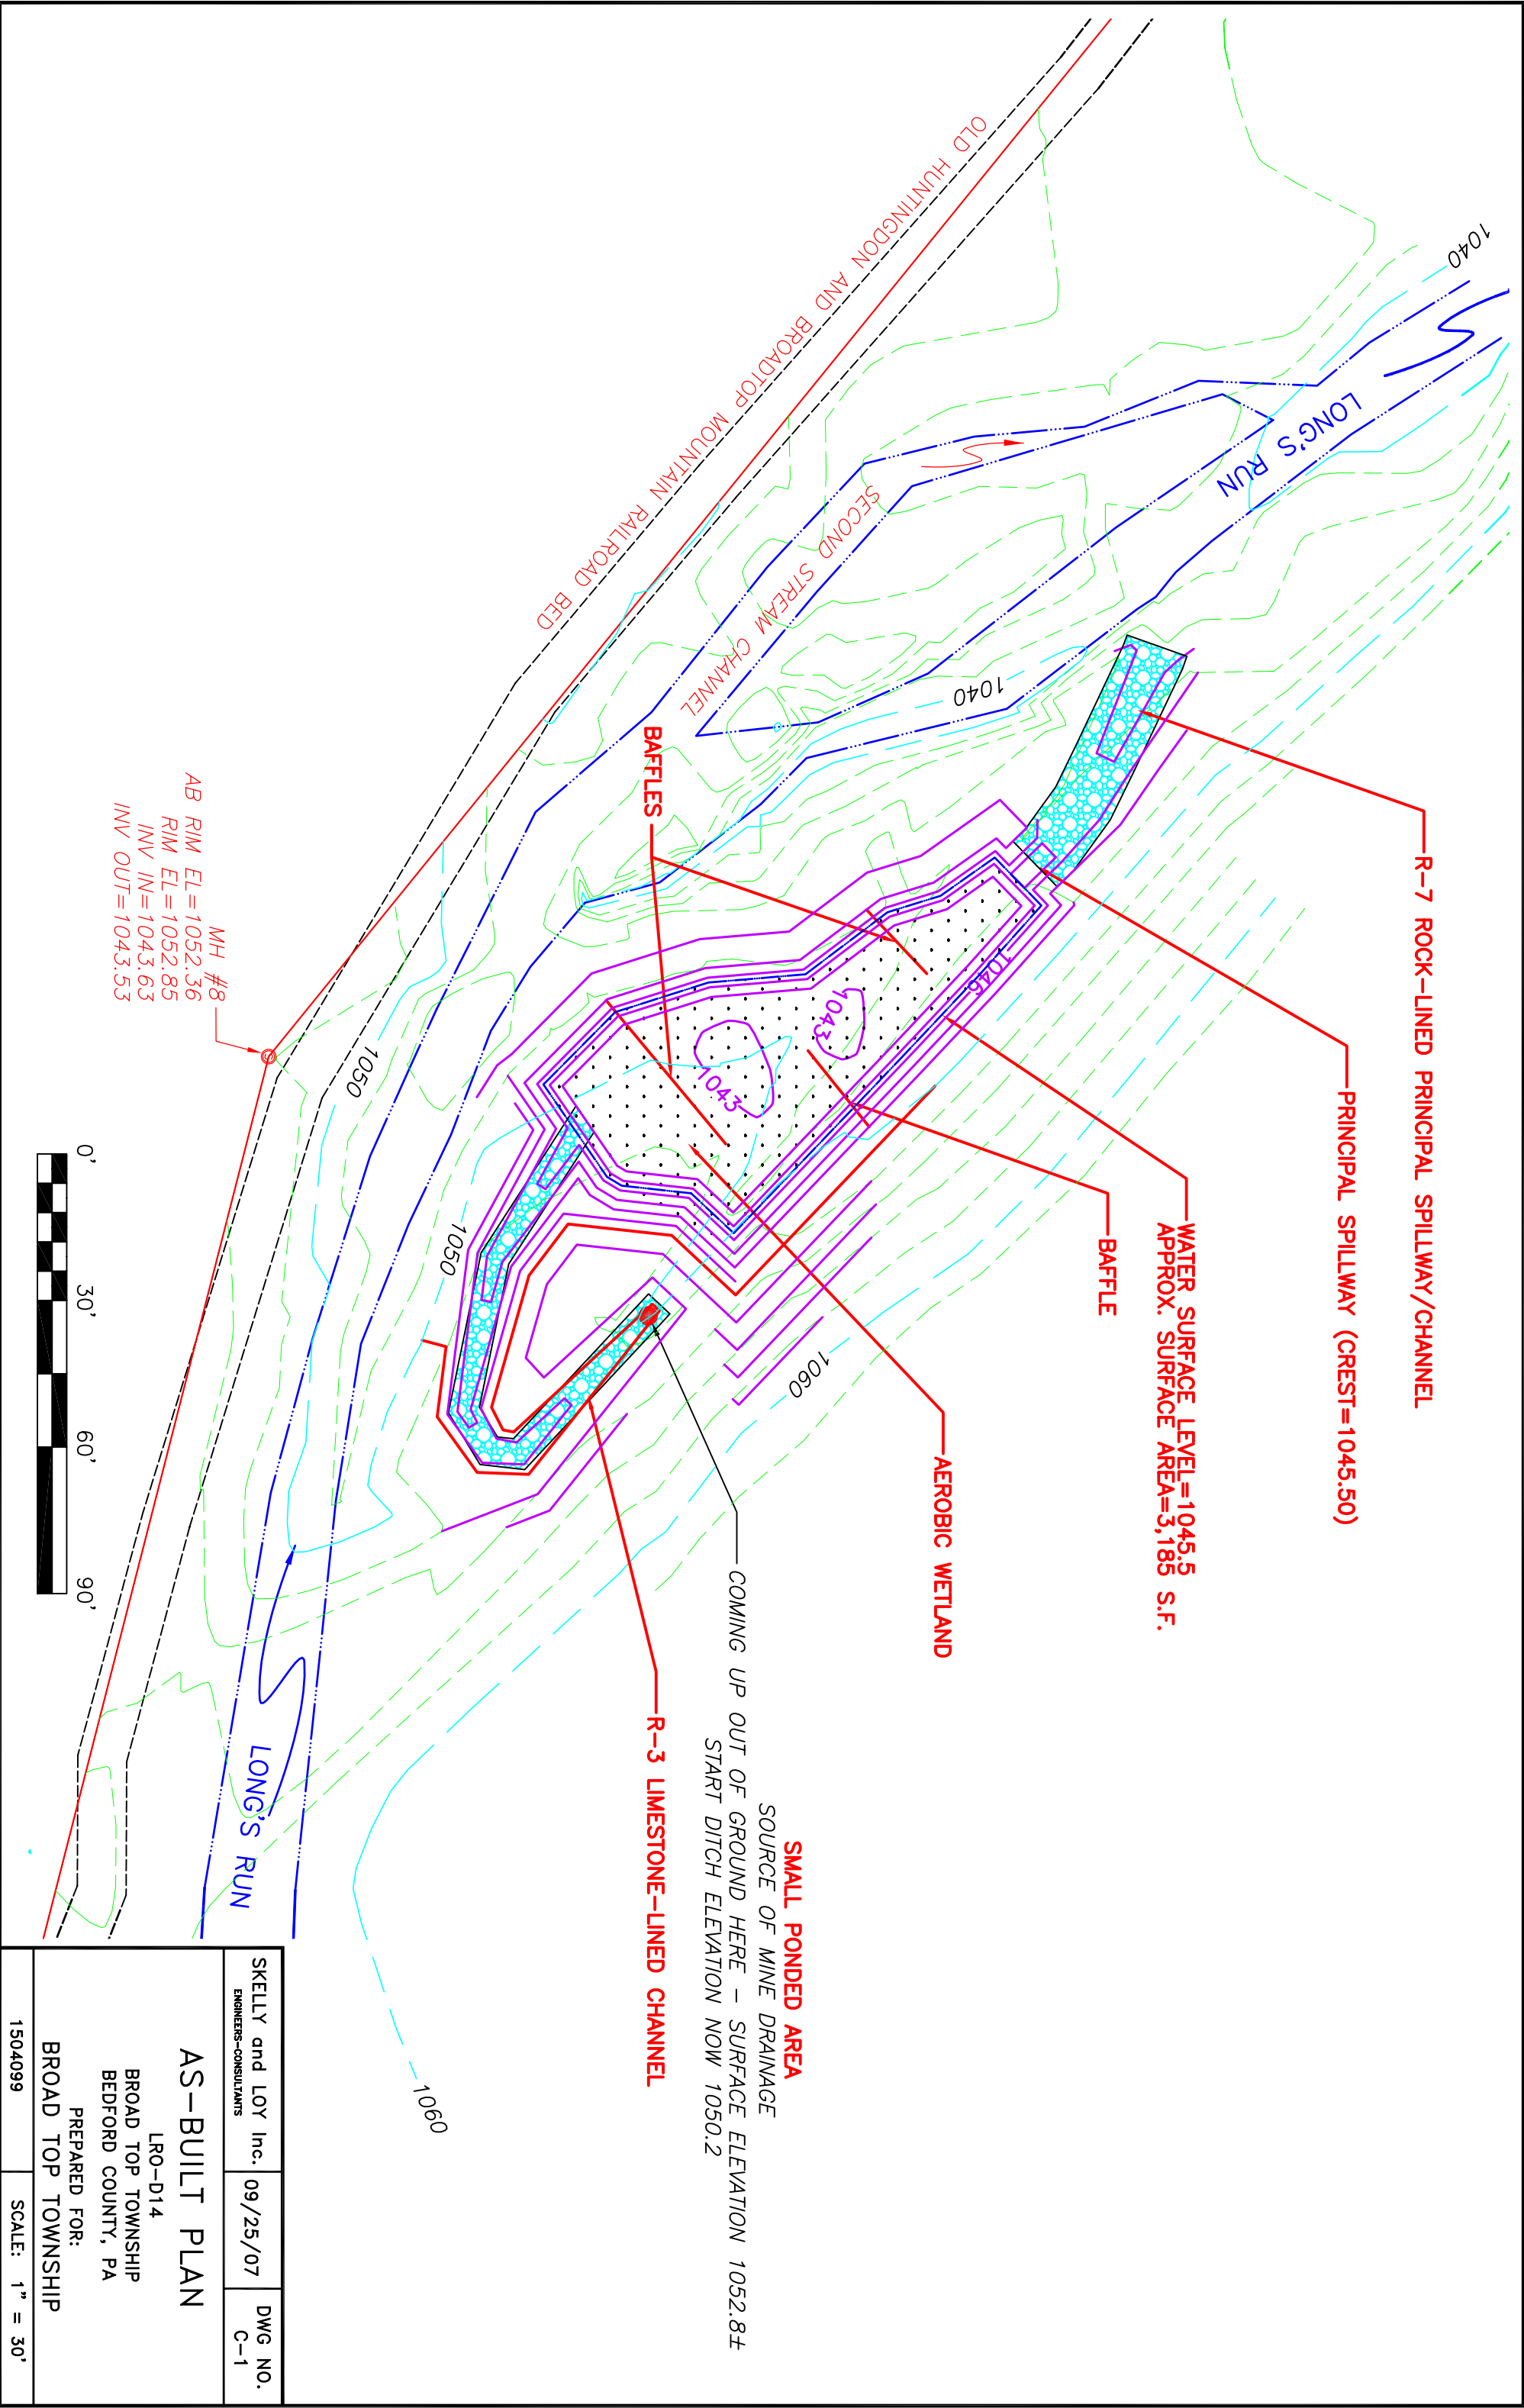

SKELLY and LOY Inc. 09/25/07 DWG NO. C-1
ENGINEERS-CONSULTANTS

AS-BUILT PLAN

LRO-D14

BROAD TOP TOWNSHIP
BEDFORD COUNTY, PA

PREPARED FOR:
BROAD TOP TOWNSHIP

1504099

SCALE: 1" = 30'