


**NOTES:**

1. BASEMAP TOPOGRAPHY DOWNLOADED FROM PENNSYLVANIA SPATIAL DATA ACCESS WEBSITE, LIDAR TILE NUMBER 32001760PAN DATED APRIL 2007.
2. RECORD DRAWING TOPOGRAPHY OBTAINED BY JOHN BLESCH, P.L.S. OF CLINTON COUNTY SOLID WASTE AUTHORITY. SURVEY WAS PERFORMED FOLLOWING PLACEMENT OF LIMESTONE IN THE CELLS.

**LEGEND**

- EXISTING CONTOURS (C.I.=2')
- EXISTING CONTOURS (C.I.=10')
- AS-BUILT GRADE (C.I. = 2')
- AS-BUILT GRADE (C.I. = 10')
- SOIL BOUNDARY
- TREELINE
- EXISTING ACCESS ROAD
- STREAM THALWAG
- AMD DISCHARGE
- ROCK SPILLWAY
- UTILITY POLE FOR OVERHEAD ELECTRIC LINE

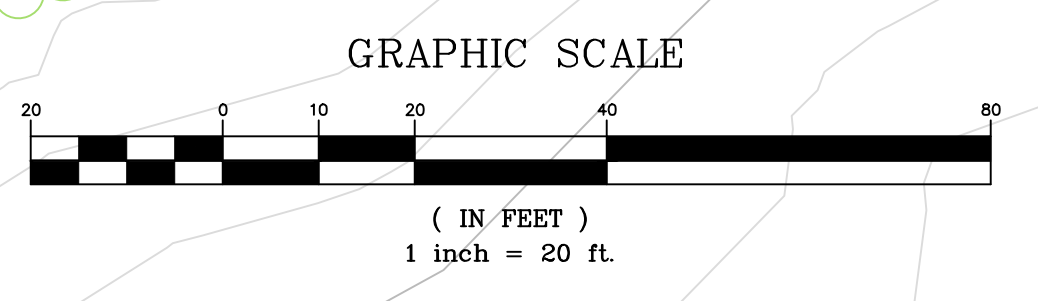

| REVISIONS |  |
|-----------|--|
|           |  |
|           |  |
|           |  |
|           |  |

|  |  |                                     |
|--|--|-------------------------------------|
| <b>LAWRENCE TOWNSHIP</b><br><b>MON 71</b><br><b>DANVIRS CISTERN</b><br><small>LAWRENCE TOWNSHIP CLEARFIELD COUNTY PENNSYLVANIA</small> |  | DATE: <b>9/07/16</b>                |
|  |  | DRAWN BY: <b>SWH</b>                |
| <b>MON 71 CONSTRUCTION RECORD DRAWING</b>  |  | CHECKED: <b>PW</b>                  |
|  |  | BAI DRAWING NO: <b>LAWR-001D001</b> |
| <small>State College Office (814) 238-2060</small>   | <small>Delaware Valley Office (610) 495-5585</small> | SHEET NO.<br><b>1 OF 1</b>          |