

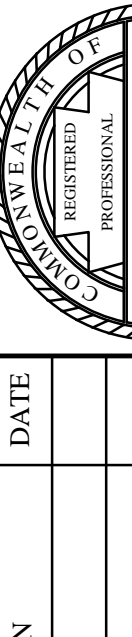


PREPARED FOR: 	PROJECT: <p style="text-align: center;">MORGAN RUN ROSS AMD TREATMENT SYSTEM CONSTRUCTION AS BUILT</p> DECATUR TOWNSHIP, CLEARFIELD TOWNSHIP, PA	PREPARED BY:  <p style="text-align: center;">107 COAL STREET OSCEOLA MILLS, PENNSYLVANIA 16666 PHONE: (814) 339-6998</p>	SCALE: <p style="text-align: center;">1" = 40'</p>	DATE: <p style="text-align: center;">JANUARY 7, 2013</p>	THE INFORMATION CONTAINED HEREON MAY NOT BE USED OR COPIED WITHOUT WRITTEN PERMISSION OF THE SIGNING ENGINEER.	REVISIONS <table border="1"> <thead> <tr> <th>NO.</th> <th>DESCRIPTION</th> <th>DATE</th> </tr> </thead> <tbody> <tr><td> </td><td> </td><td> </td></tr> <tr><td> </td><td> </td><td> </td></tr> <tr><td> </td><td> </td><td> </td></tr> <tr><td> </td><td> </td><td> </td></tr> <tr><td> </td><td> </td><td> </td></tr> <tr><td> </td><td> </td><td> </td></tr> </tbody> </table>	NO.	DESCRIPTION	DATE																			SEAL: 	SHEET NO. <div style="text-align: center; font-size: 2em; font-weight: bold;">AB-3</div>	3 OF 3
NO.	DESCRIPTION	DATE																												