




**GENERAL NOTES**

1. BASE MAPPING PREPARED BY LAND & MAPPING SERVICES, CLEARFIELD, PA. FROM MAPPING COMPILED BY PHOTOGRAMMETRIC METHODS FROM AERIAL PHOTOGRAPHY EXPOSED 03/07/12.
2. N.Y.S.E.G. RIGHT OF WAY AGREEMENT HAS BEEN OBTAINED TO WORK UNDER UTILITY LINE. FOLLOW PROPER PROCEDURES FOR WHEN CONDUCTING ACTIVITIES UNDER UTILITY LINE.
3. PROPERTY AND RIGHT-OF-WAY INFORMATION PROVIDED BY GEOTECH ENGINEERING, INC. FROM PLOT PLAN DATED AUGUST 20, 2013, UPDATED AUGUST 28, 2013.

**LEGEND**

- PROPERTY BOUNDARY
- LEGAL RIGHT-OF-WAY
- AS-BUILT FINAL GRADE (C.I.=5')
- AS-BUILT FINAL GRADE (C.I.=1')
- TREELINE
- EXISTING ROAD
- EXISTING WATERLINE
- AS-BUILT WATERLINE
- AS-BUILT CULVERT
- STREAMS / CHANNELS
- EXISTING GUIDE RAIL
- OVER HEAD WIRES (O.H.W.)
- FRENCH MATRESS
- SURVEY CONTROL POINTS

**DRAFT**

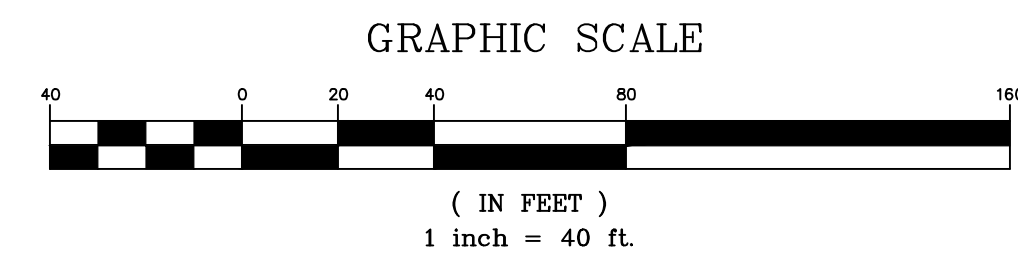

		REVISIONS	
		NO.	DESCRIPTION
<b>CLEARFIELD COUNTY CONSERVATION DISTRICT</b> <b>DEER CREEK AMD PASSIVE TREATMENT SYSTEM</b> <small>GIRARD TOWNSHIP CLEARFIELD COUNTY PENNSYLVANIA</small>		DATE:	12/21/17
		DRAWN BY:	RHM
<b>RECORD PLAN</b>		CHECKED:	KMC/PW
		BAI DRAWING NO:	CLDF-002D007
State College Office <small>(814) 238-2060</small>	Delaware Valley Office <small>(610) 495-5585</small>	Delaware Office <small>(302) 449-4961</small>	SHEET NO. <b>1 OF 1</b>