


GENERAL NOTES

1. Base map contours derived from a bare-earth digital elevation model constructed from LiDAR data (QL2) collected in Fall 2019/Spring 2020 by US Geologic Survey [PA State Plane - South (US Survey Foot) NAD83, Vertical datum - NAVD83]. Select topographic and cultural features from 2018 Pennsylvania Emergency Management Agency (PEMA) 0.5-foot orthoimagery obtained from [www.pasda.psu.edu](http://www.pasda.psu.edu). Additional information by BioMost, Inc. from limited 2021-2022 site investigations.
2. All dimensions are in feet unless otherwise noted. All slope designations are H:V.
3. All As-Built topographic lines are based off of GPS points taken by BioMost, Inc. using a Sub-Centimeter Grade, dual frequency JAVAD GPS unit.
4. Maintenance Pond and BC-19/19B cleanup work completed June 2022.

LEGEND

- EX. INDEX CONTOUR
- EX. INTERMEDIATE CONTOUR
- AS-BUILT INDEX CONTOUR
- AS-BUILT INTERMEDIATE CONTOUR
- AS-BUILT N-12 8" PIPE
- AS-BUILT MAINTENANCE POND
- AS-BUILT SDR35 6" PIPE
- GRAVEL ROAD
- ACCESS ROAD
- BC-16
- WATER MONITORING LOCATION
- BENCHMARK
- PROPERTY LINES (APPROX.)
- BUILDINGS
- STREAM WATER BODY
- VEGETATED DIVERSION CHANNEL
- DWELLINGS
- EXTENTS OF SLUDGE REMOVAL (JUNE 2022)

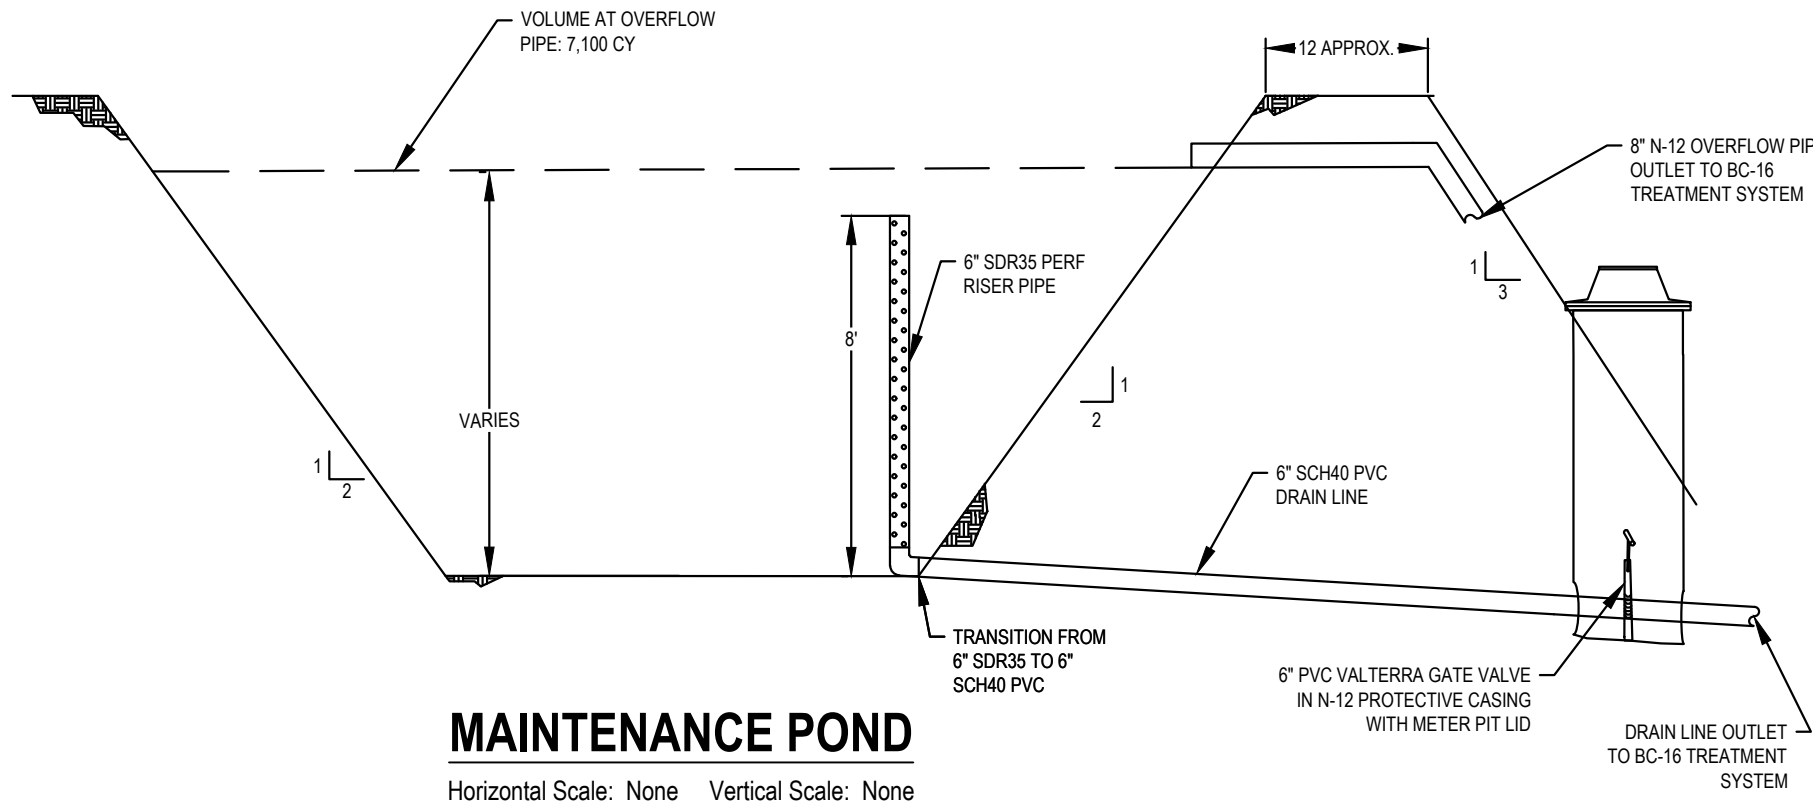

**MAINTENANCE POND**  
Horizontal Scale: None Vertical Scale: None

SHEET 1 OF 1

As-Built

As-Built Plan View & Details

**BLACKS CREEK MAINTENANCE POND**

for  
**STREAM RESTORATION INCORPORATED**

Butler County, Pennsylvania

Scale: As Shown June 2022  
**BioMost, Inc. Mining and Reclamation Services**  
Mars, PA [www.biomost.com](http://www.biomost.com)

**Center of Maintenance Pond**  
Latitude: 41.165278  
Longitude: -79.916667