






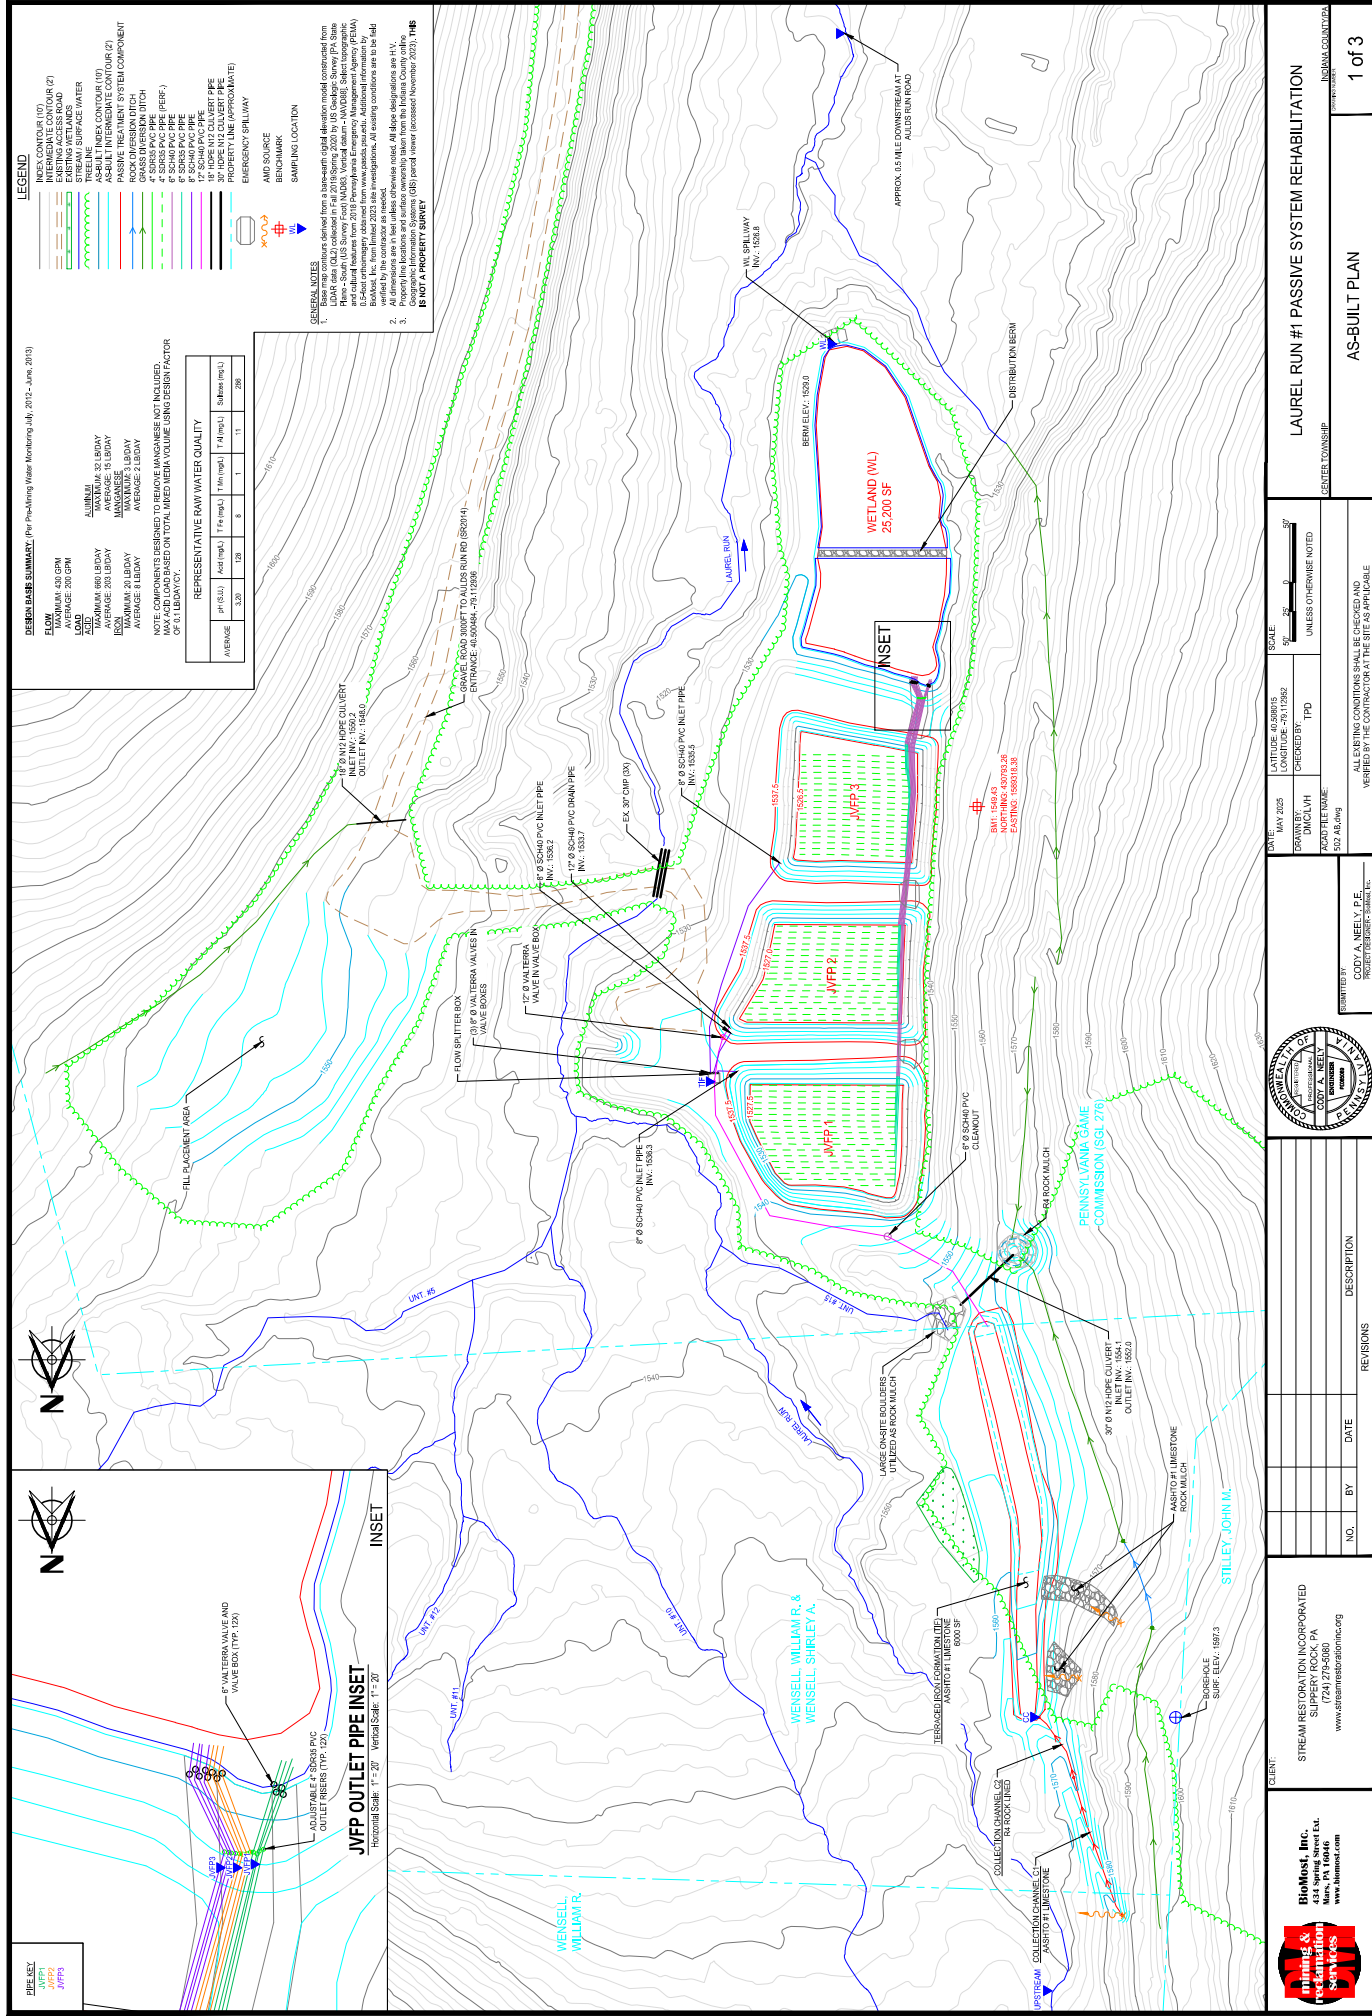

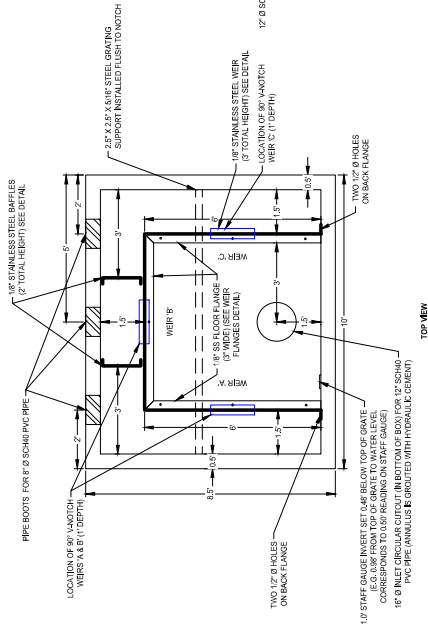


FLOW SPLITTER

Horizontal Scale: None Vertical Scale: None

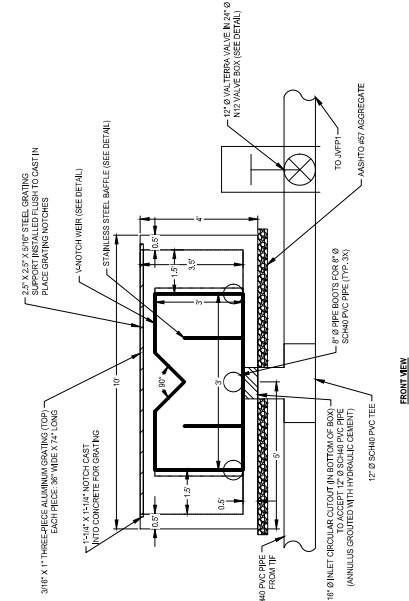


FRONT VIEW

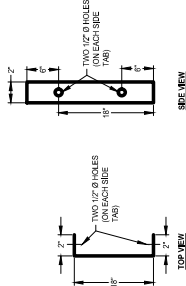


SIDE VIEW

STAINLESS STEEL BAFFLES

Horizontal Scale: None Vertical Scale: None

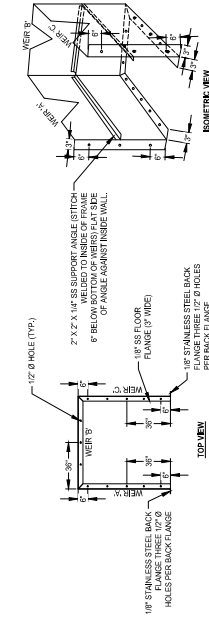


TOP VIEW

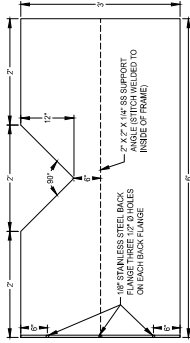

SIDE VIEW

WEIR FLANGES

Horizontal Scale: None Vertical Scale: None

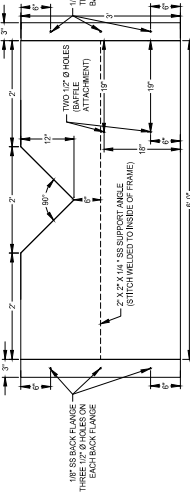

FRONT VIEW

V-NOTCH WEIR CUTOUTS (90°)

Horizontal Scale: None Vertical Scale: None

 BioMost, Inc. 434 Spring Street East Mars, PA 16646 www.biomost.com	CLIENT STREAM RESTORATION INCORPORATED 434 Spring Street East SUITE 200 Mars, PA 16646 www.streamrestorationinc.org														DATE: MAY 2025 DRAWN BY: DMCLVH CHECKED BY: TPD ROAD FILE NAME: 502 AB/awg	NO SCALE		LAUREL RUN #1 PASSIVE SYSTEM REHABILITATION	
											LATTITUDE: 40.268013 LONGITUDE: -79.112862 UTM ZONE: 18Q UTM X: 650000 UTM Y: 4500000								
										DESIGNED BY CODY A. NEELY, P.E. PROJECT NUMBER: 15-00000000						CENTER TOWNSHIP		INDIANA COUNTY, PA	
										AS-BUILT DETAILS						3 of 3			