




SECTION A - A' SCALE 1" = 2'

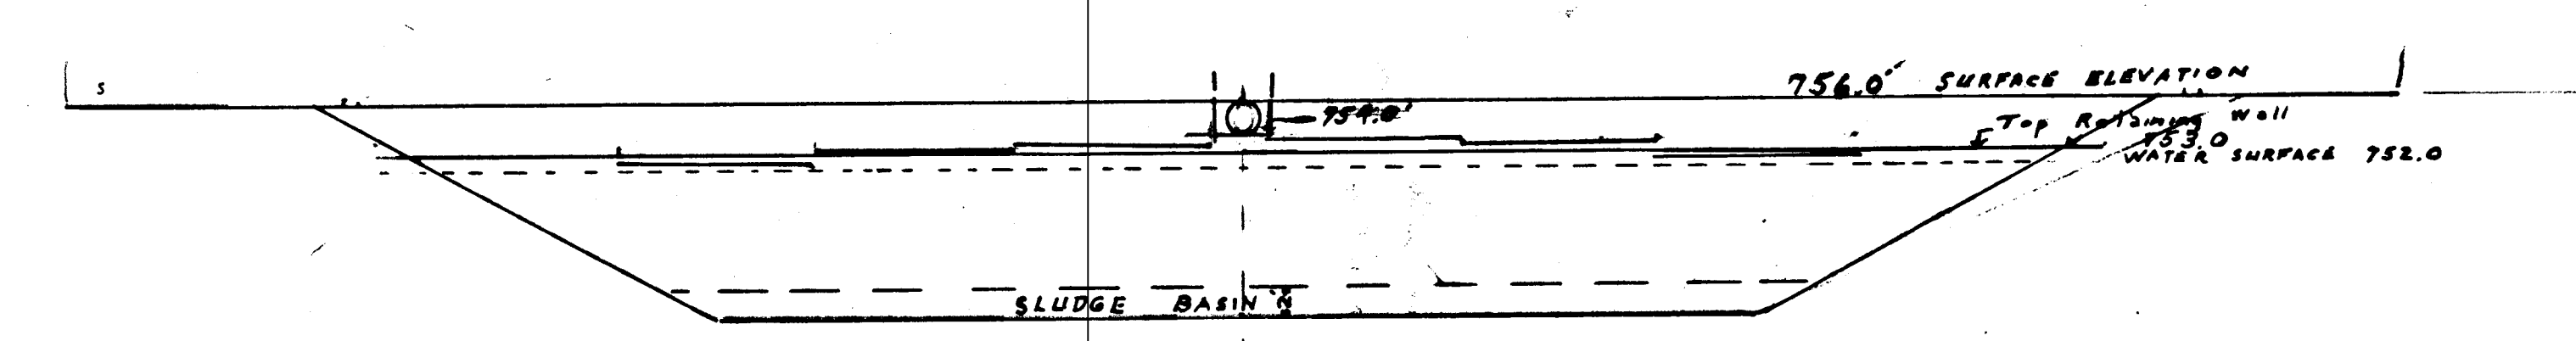


SECTION E - E' SCALE 1" = 10'

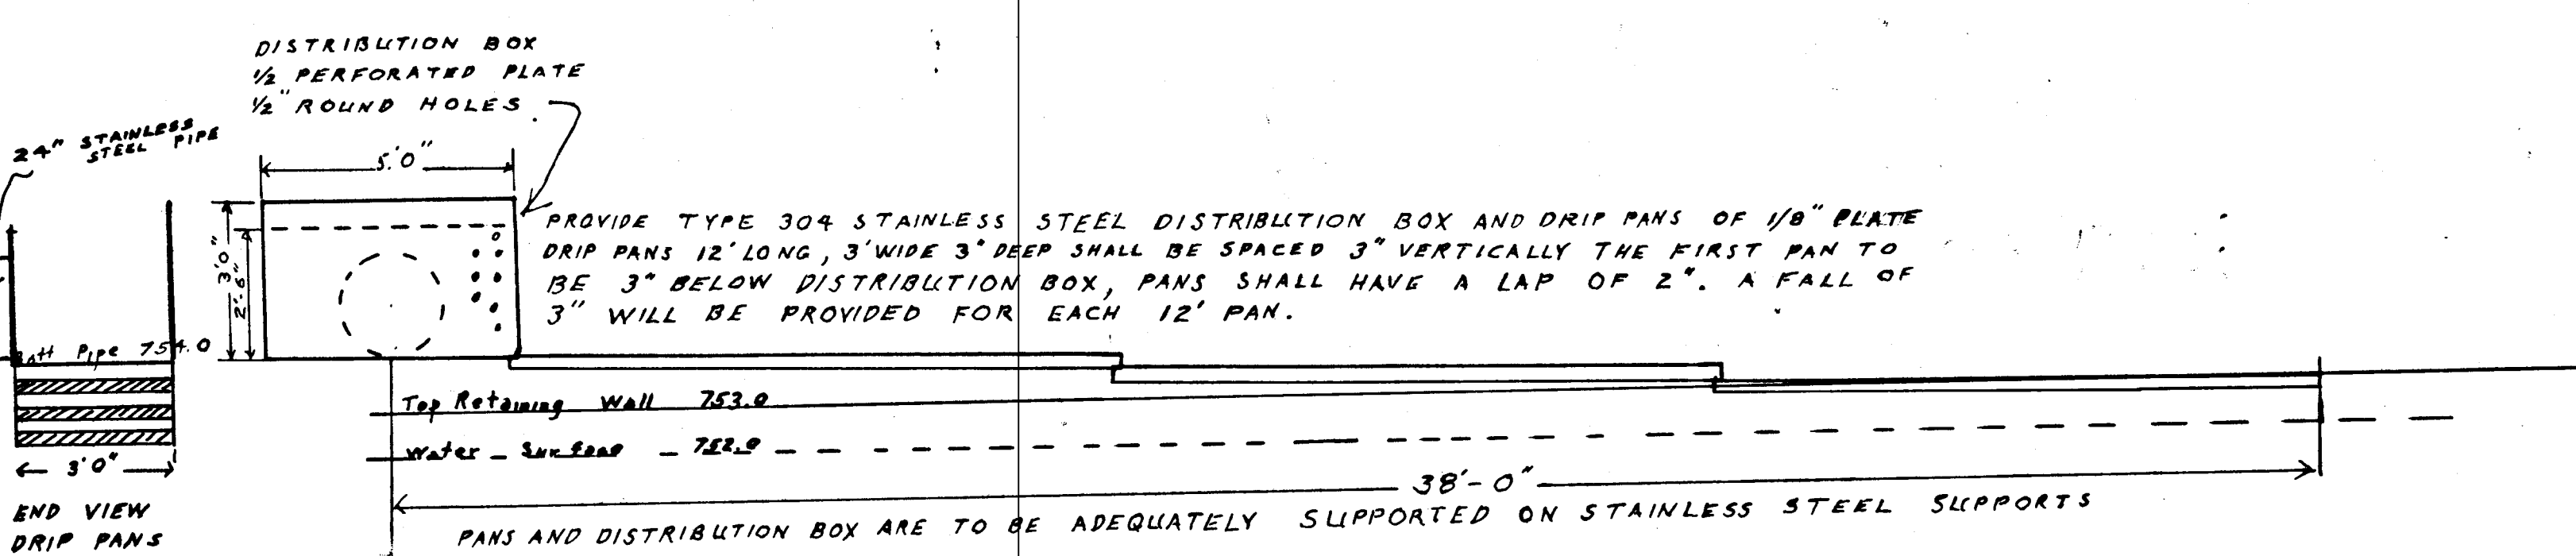


SCALE 1" = 3' SKETCH SHOWING DRIP PAN DETAIL

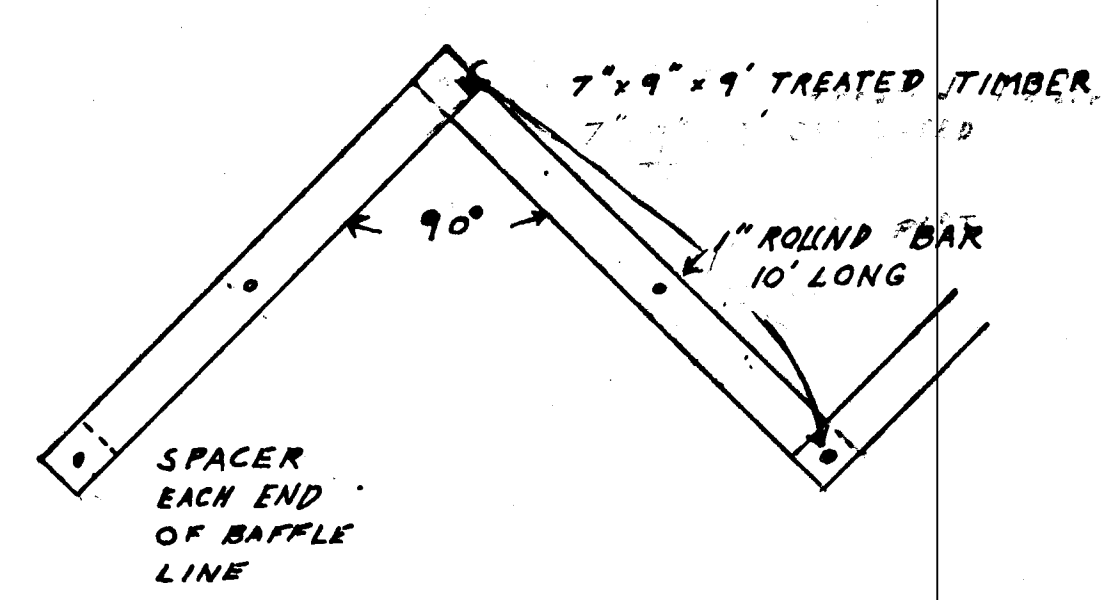

SKETCH OF BAFFLE DETAIL

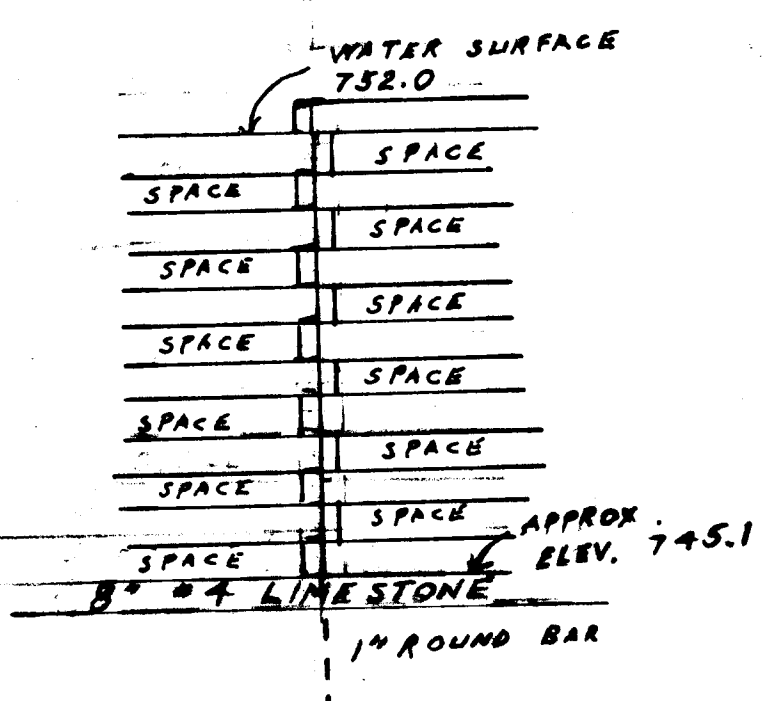

- EXHIBITS
- A RETAINING WALL - INLET
  - B RETENTION DAM
  - C SLUDGE PIT WALL
  - D WALL AT MINE DISCHARGE
  - E MANHOLE - HEADWALL
  - F LOCATION MAP

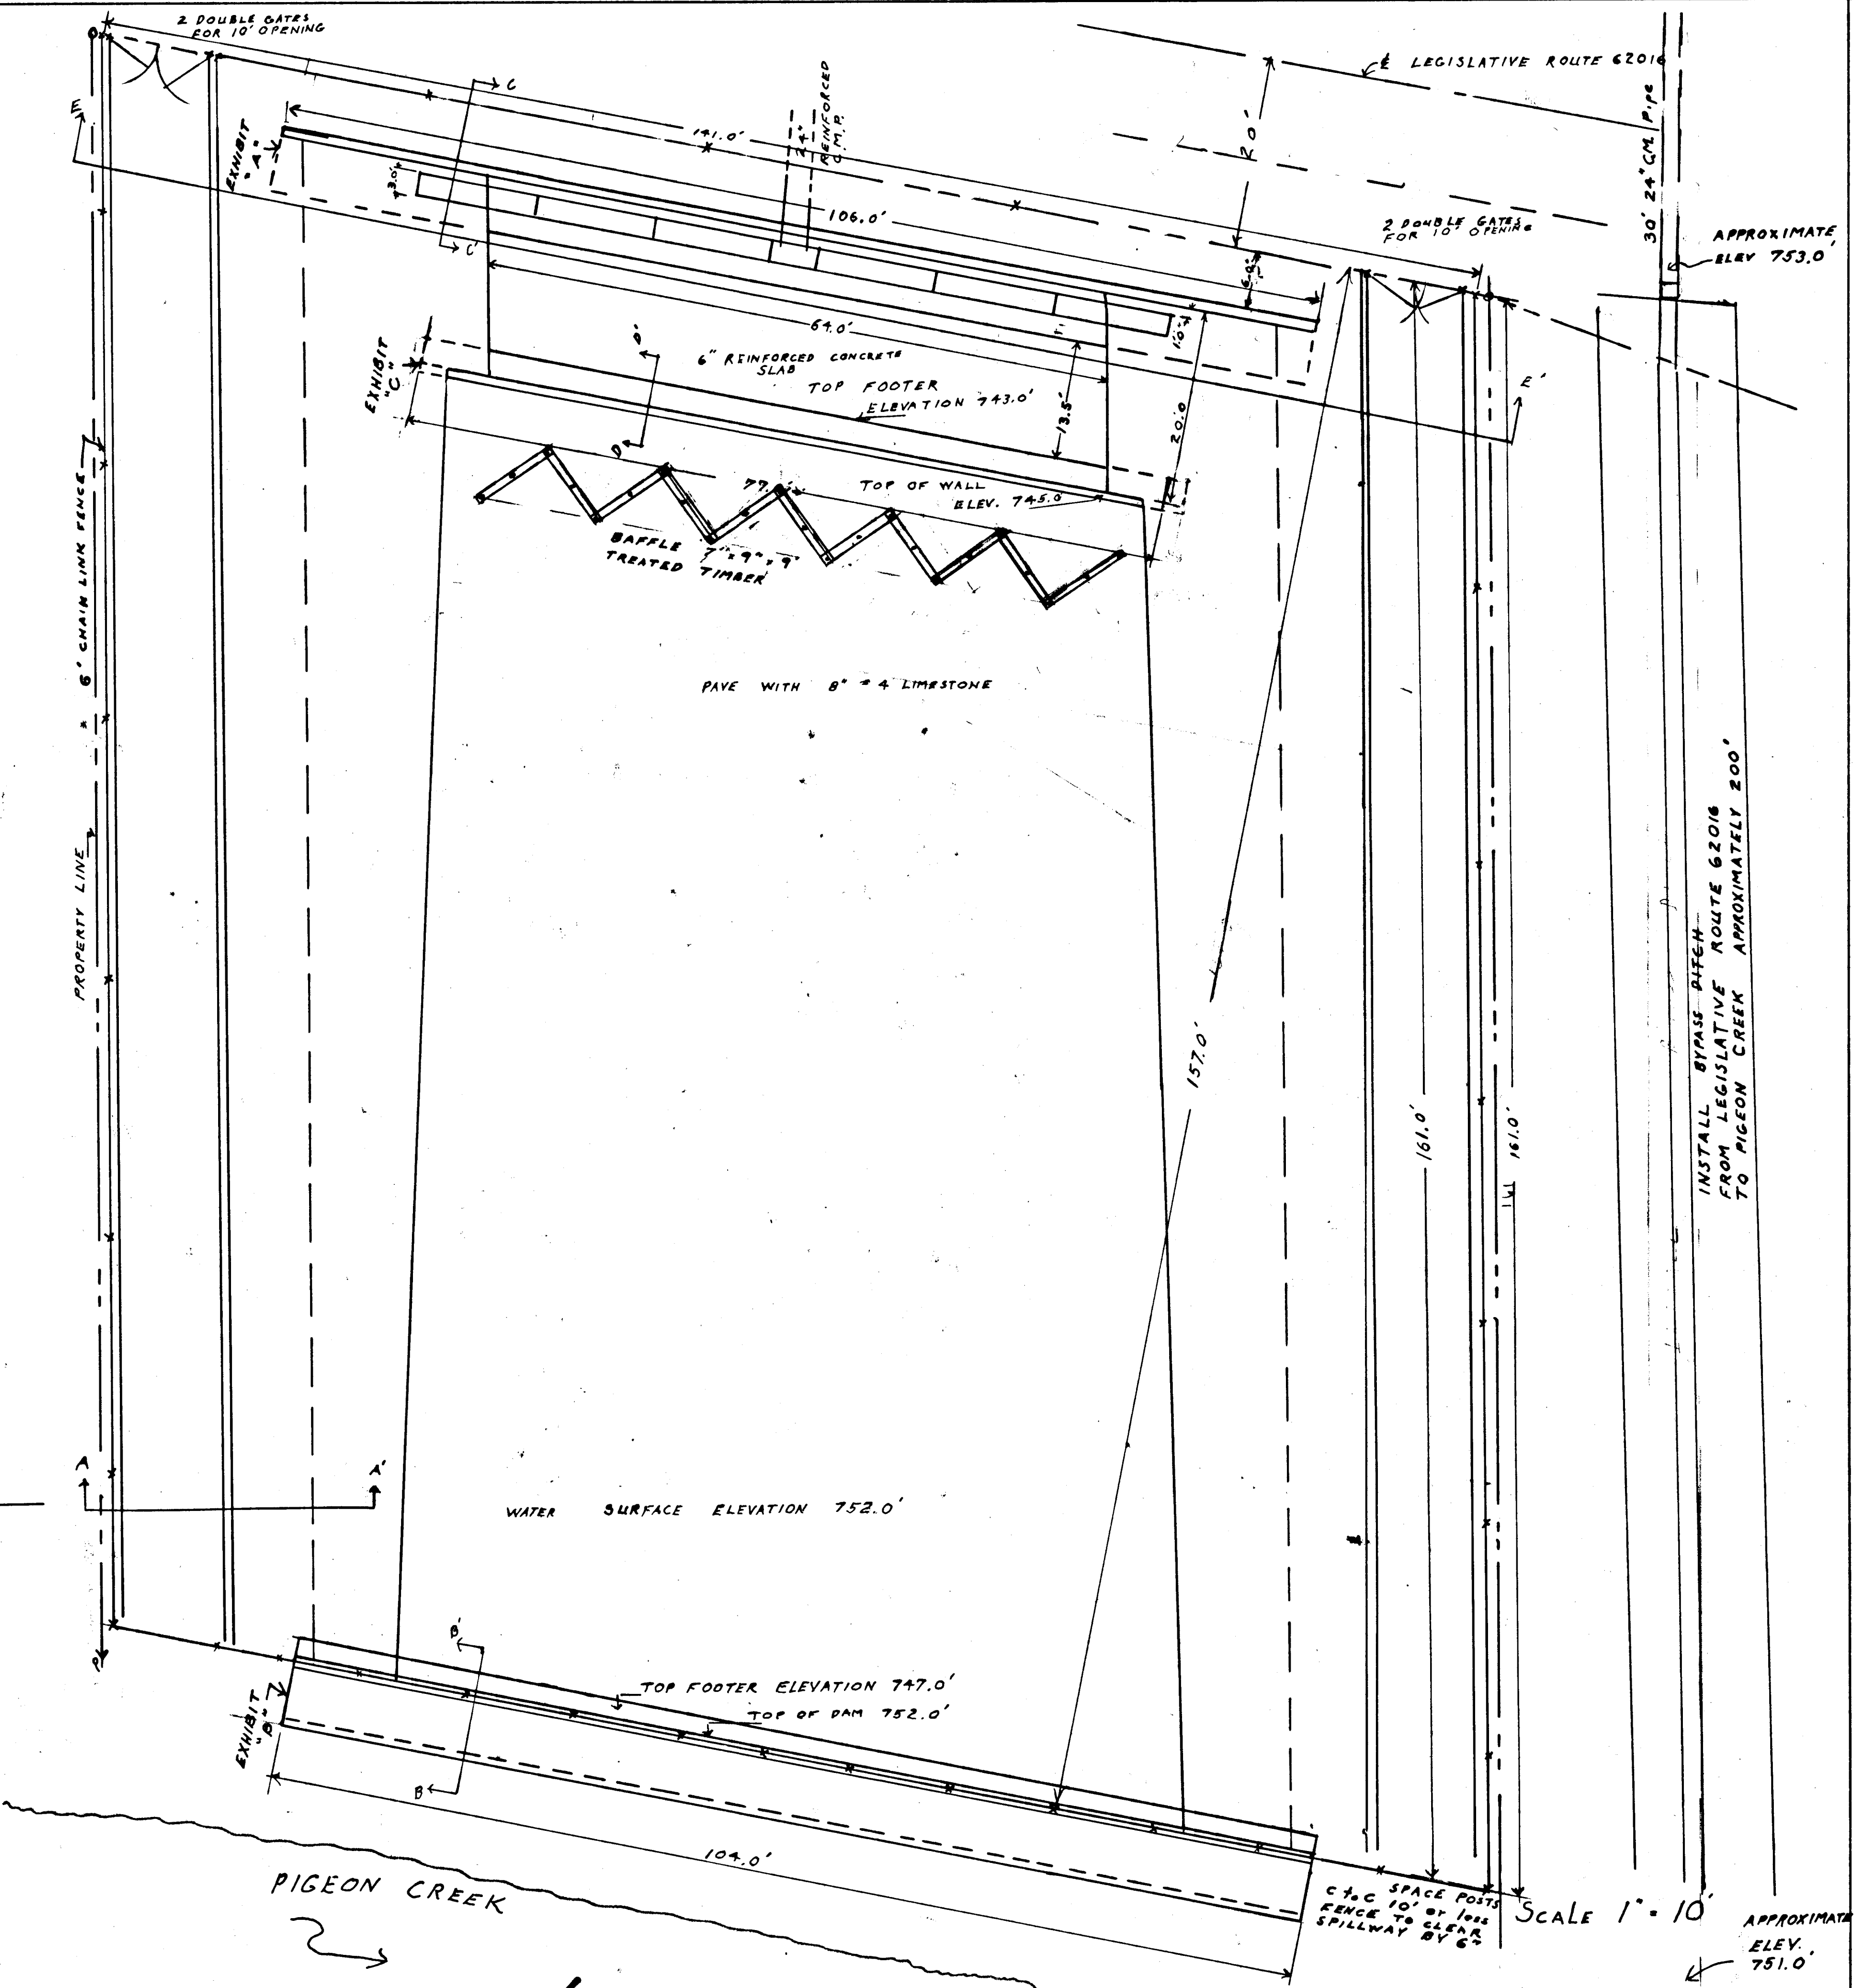

SCALE 1" = 10' APPROXIMATE ELEV. 751.0

**AS BUILT**  
NOV. 15, 1978

PENNSYLVANIA DEPARTMENT OF MINES AND MINERAL INDUSTRIES  
 PIGEON CREEK WATER TREATMENT PLANT  
 CARROLL TOWNSHIP, WASHINGTON COUNTY, PENNSYLVANIA  
 MINE DRAINAGE PROJECT SL 142-1  
 SCALE AS SHOWN  
 APRIL 29, 1969  
 REV. JULY 1, 1969  
 DRAWN BY DAVID R. LEWIS  
 APPROVED *Arnoldshahi, P.E.*