



LEGEND


- 1234 --- EXISTING CONTOURS
- EXISTING STABILIZED AGGREGATE ROAD
- WATERCOURSE
- WATERBODY
- APPROX. EDGE NATURAL WETLAND
- ▲ ORIGINAL PRECONSTRUCTION MONITORING POINTS
- ▲ 1234.56 MARKED RANDOM SURVEY POINT # WITH SURFACE ELEVATION

REV. NO.	DATE	REVISION

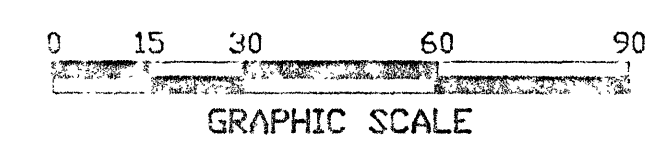


AS-BUILT PLAN
 Passive Treatment System
 PROJECT # 002
 PA STATE ROUTE 1001 9.0
 Slippery Rock Creek
 Twp. 10 N., R. 7 W., Mer. C. 10th, 11th
 COUNTY OF BUTLER, PENNSYLVANIA
 Scale: 1" = 80' Date: 11/05
 C. D. C. Associates, Inc.
 Coopersburg, PA
 215-261-1100

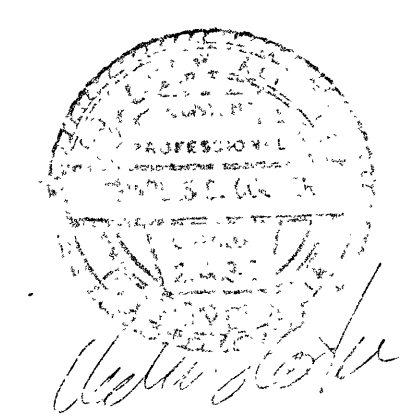


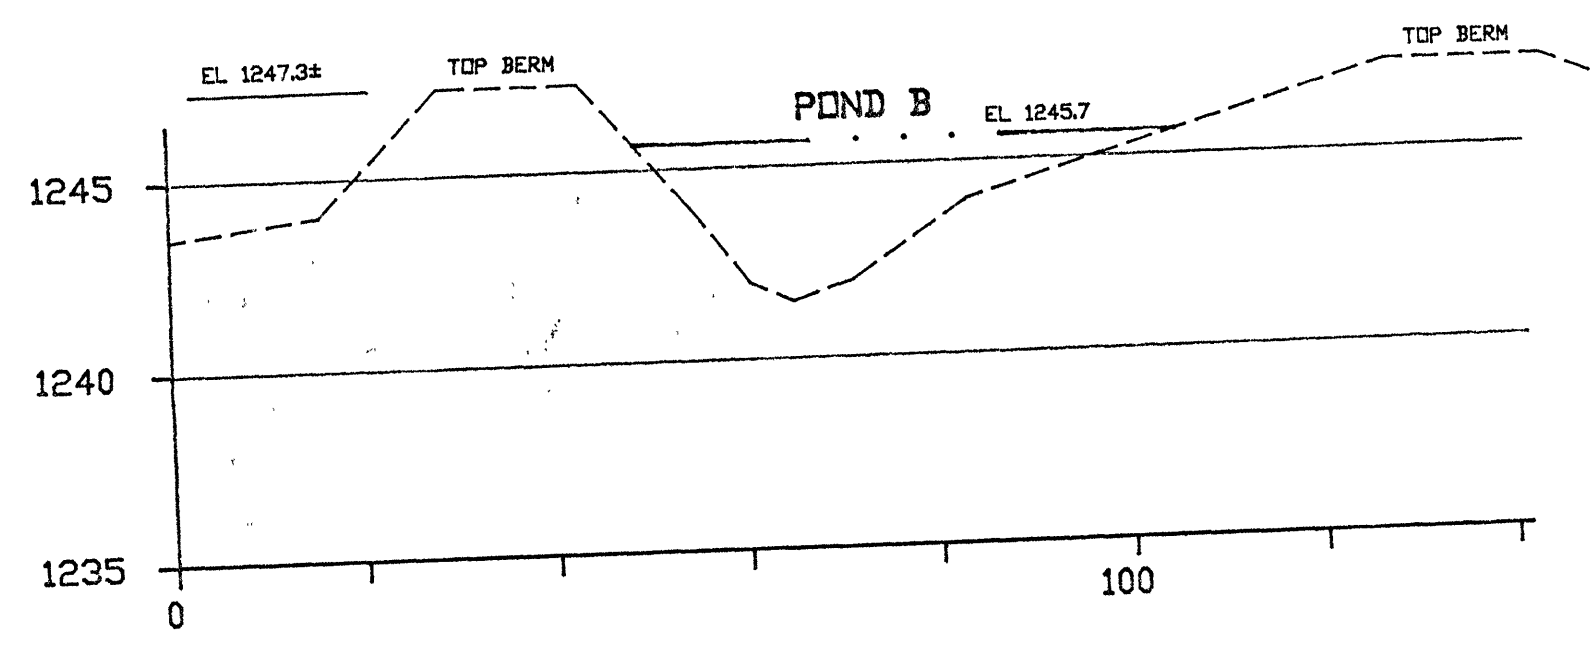


SECTION B4
 Scale: 1" = 20' Hor
 Scale: 1" = 5' Vert

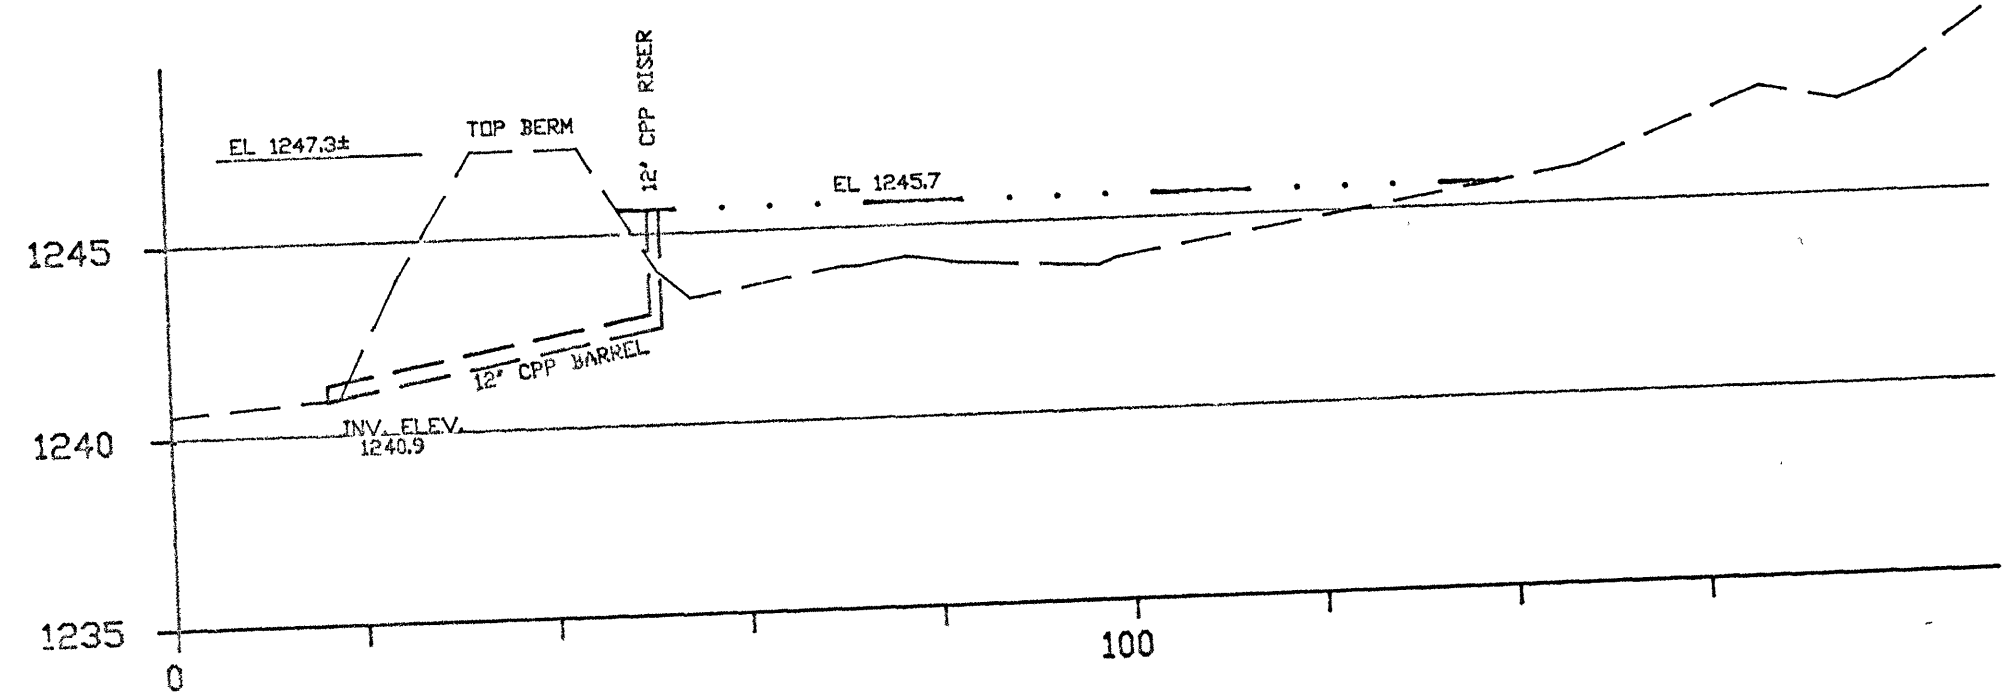


SECTION B5
 Scale: 1" = 20' Hor
 Scale: 1" = 5' Vert

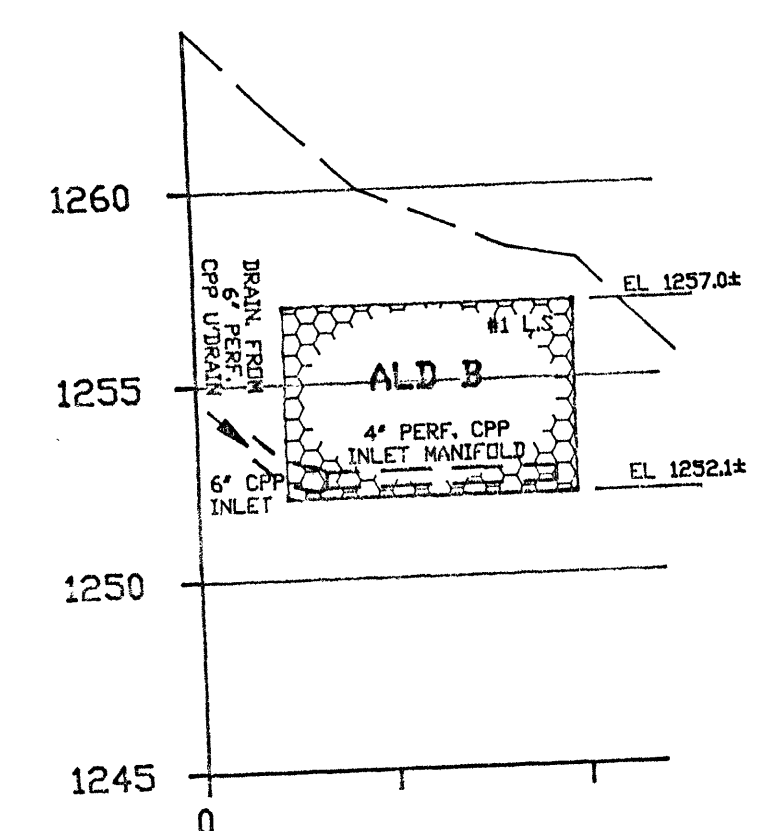


SECTION B1
 Scale: 1" = 20' Hor
 Scale: 1" = 5' Vert

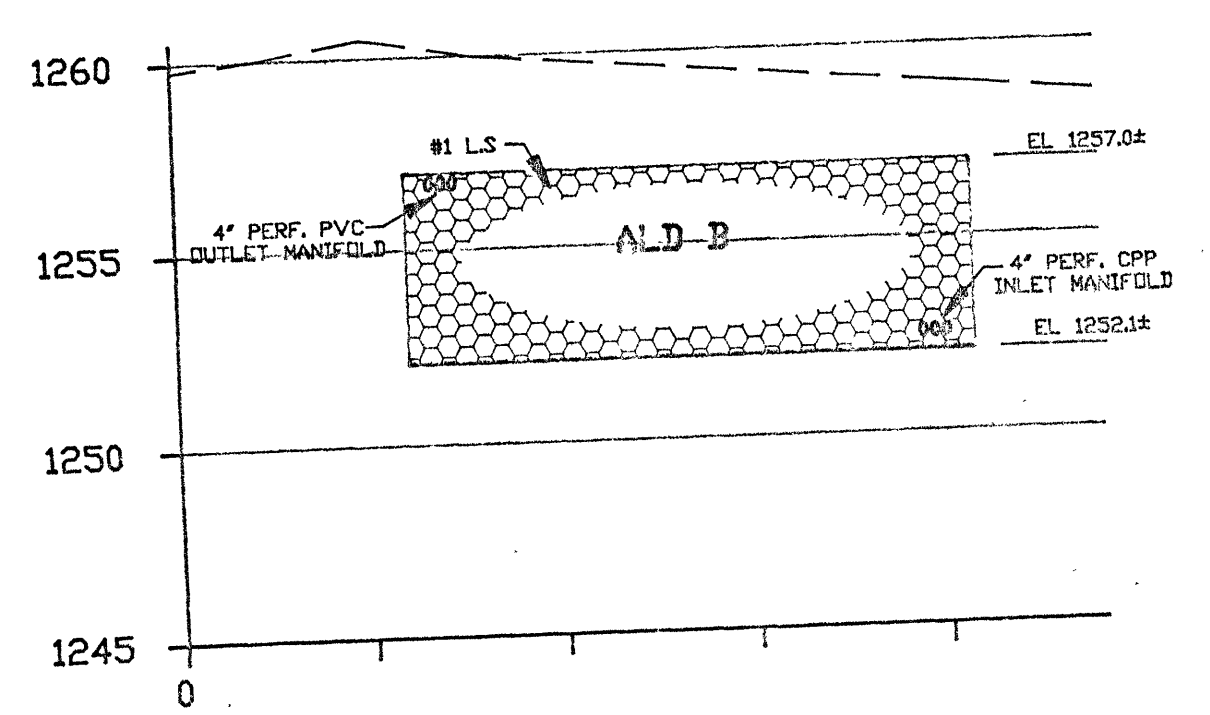

SECTION B2
 Scale: 1" = 20' Hor
 Scale: 1" = 5' Vert

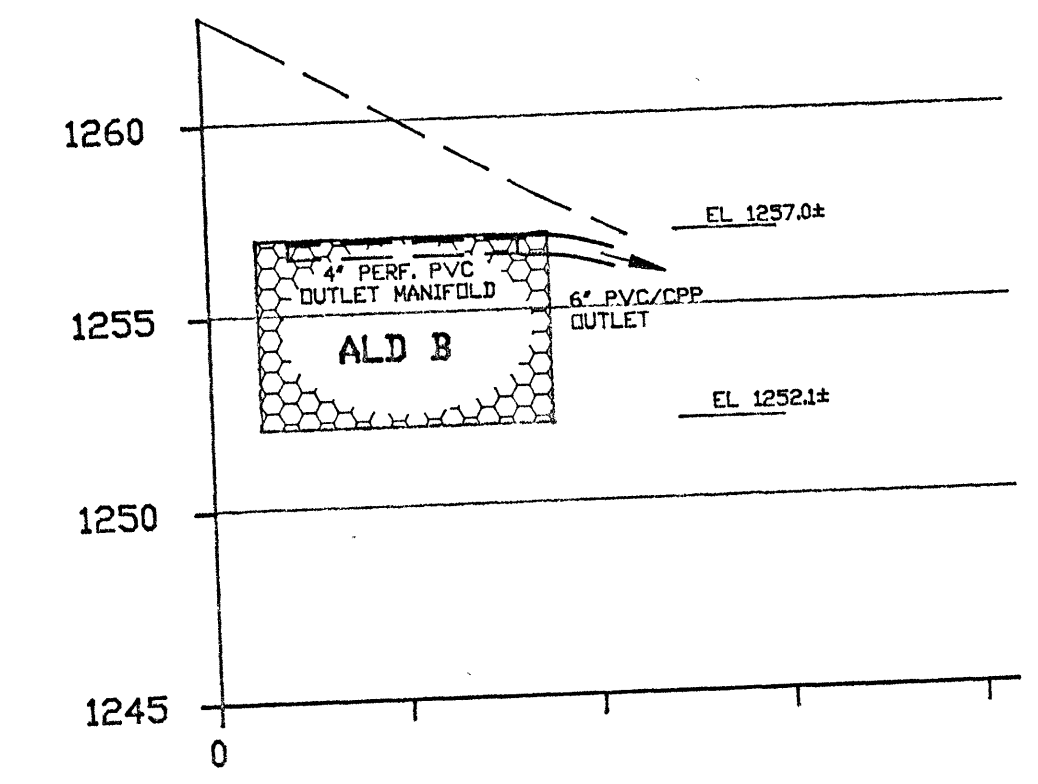


SECTION B3
 Scale: 1" = 20' Hor
 Scale: 1" = 5' Vert

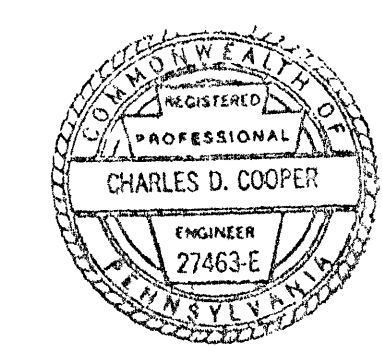


Charles D. Cooper

REV. NO.	DATE	REVISION


AS BUILT
 CROSS-SECTIONS
 Proposed Passive Treatment System
 ARGENTINE SITE
 Discharges 114-A, B, C & D
 PA STATE GAME LANDS # 95
 situate in
 Washington Township, Butler County, PA
 made for
HEDIN ENVIRONMENTAL
 Scale: as shown Date: 11/25
 C D S Associates, Inc.
 Ceraopolis, PA
 No. 94393

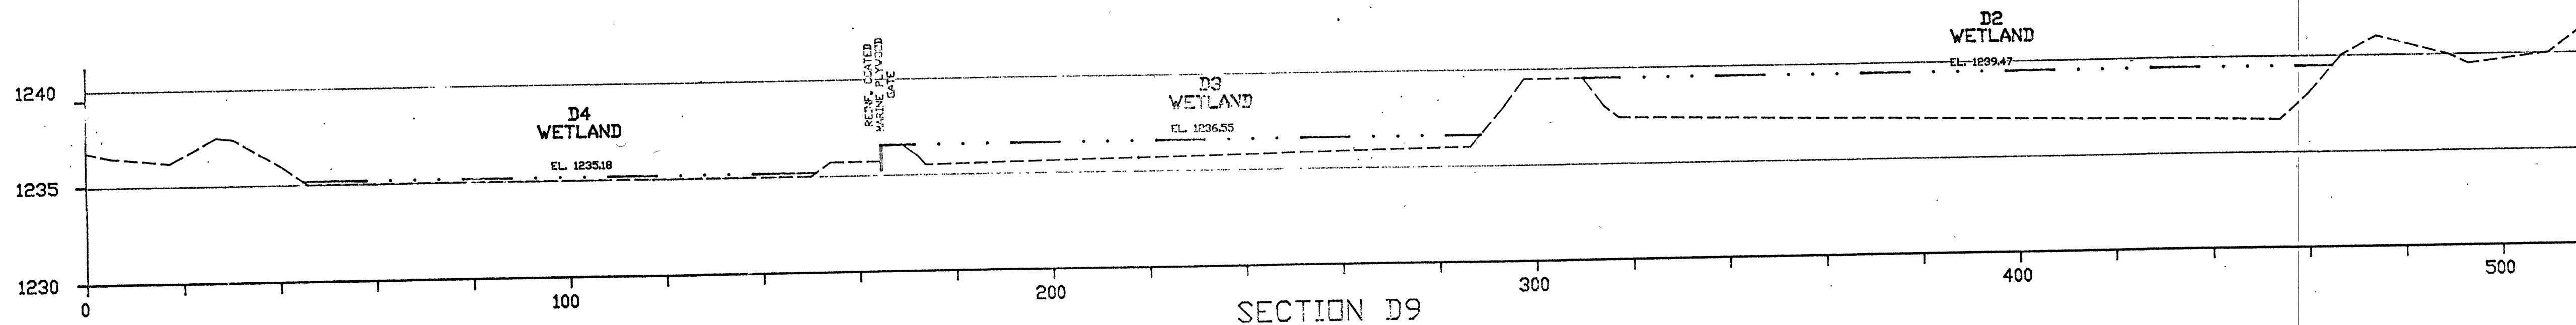


SECTION D9
Scale: 1" = 20' Hor
Scale: 1" = 5' Vert

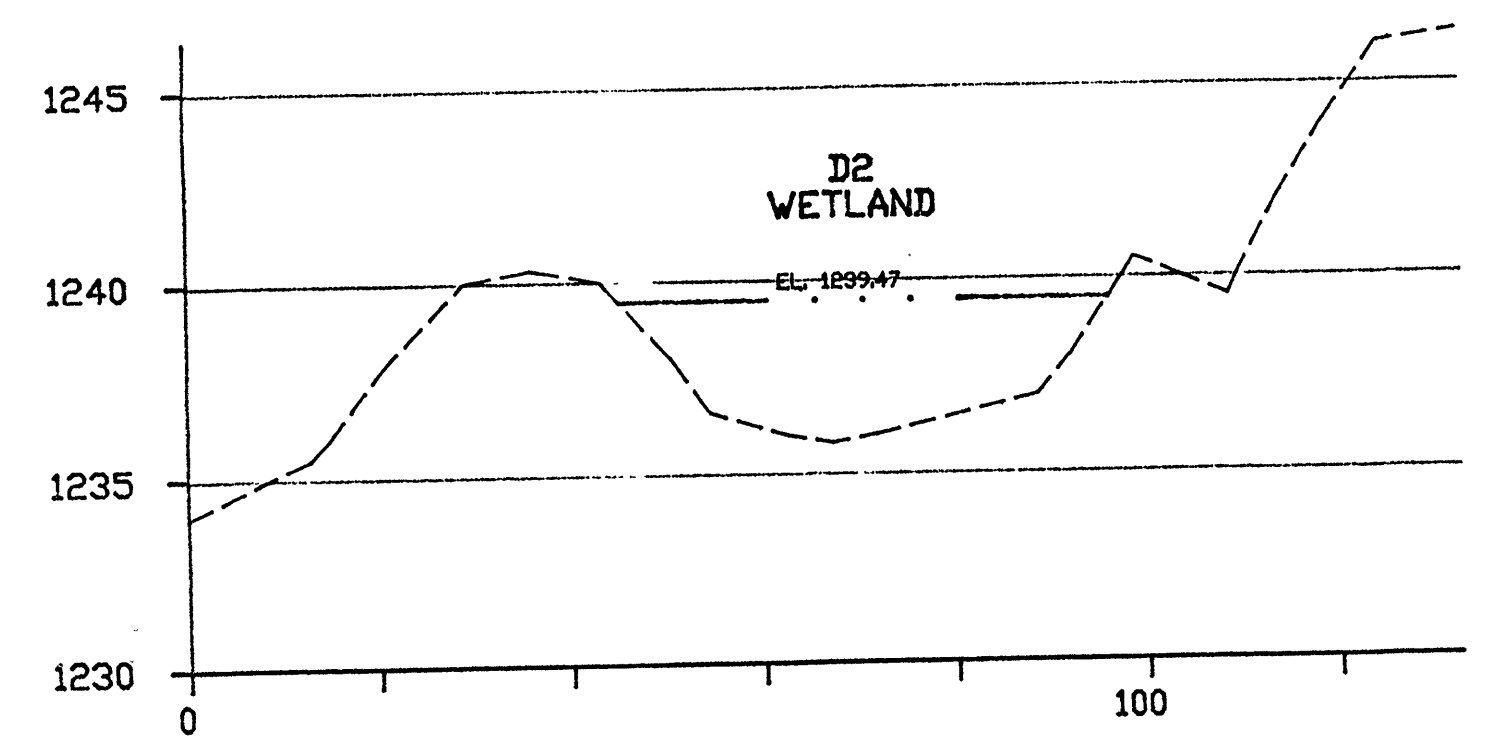


SECTION D6
Scale: 1" = 20' Hor
Scale: 1" = 5' Vert

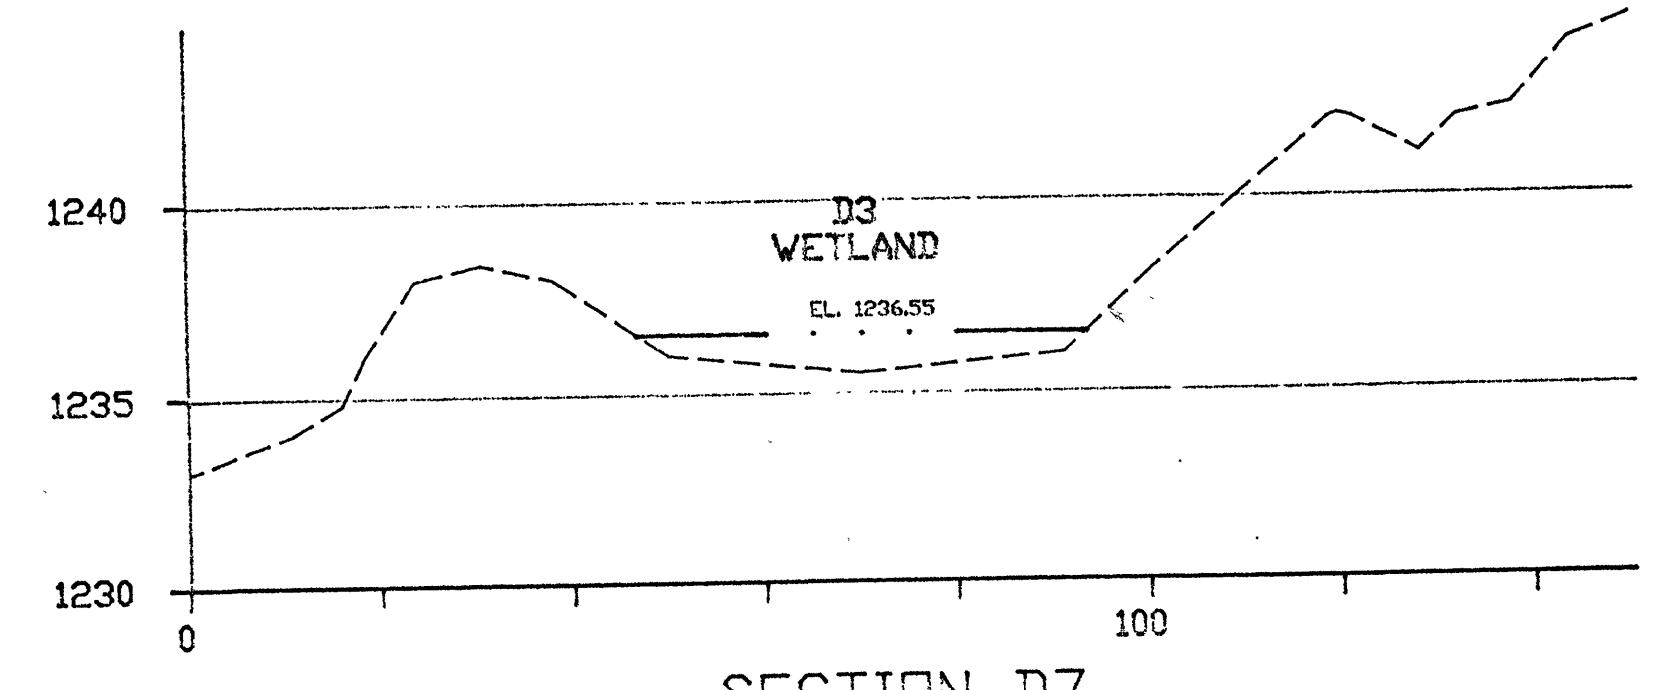


SECTION D7
Scale: 1" = 20' Hor
Scale: 1" = 5' Vert

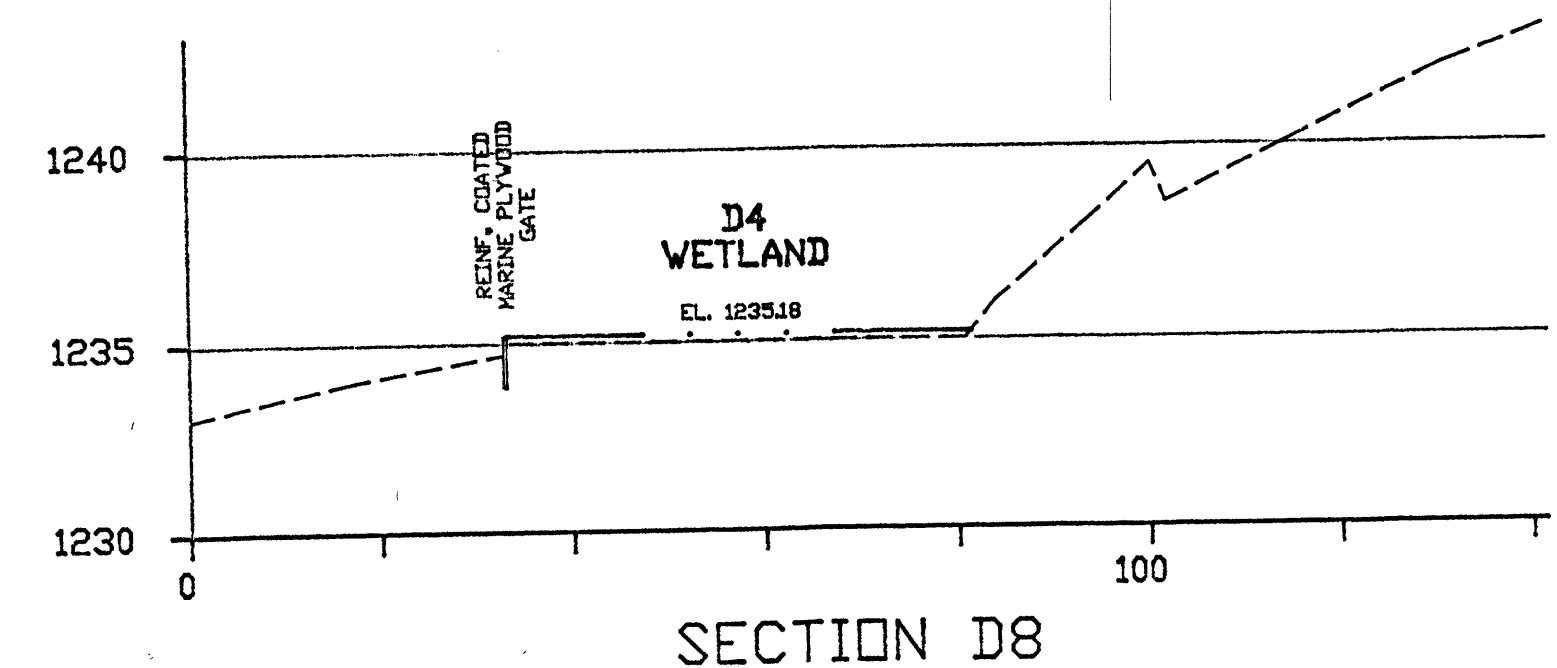


SECTION D8
Scale: 1" = 20' Hor
Scale: 1" = 5' Vert

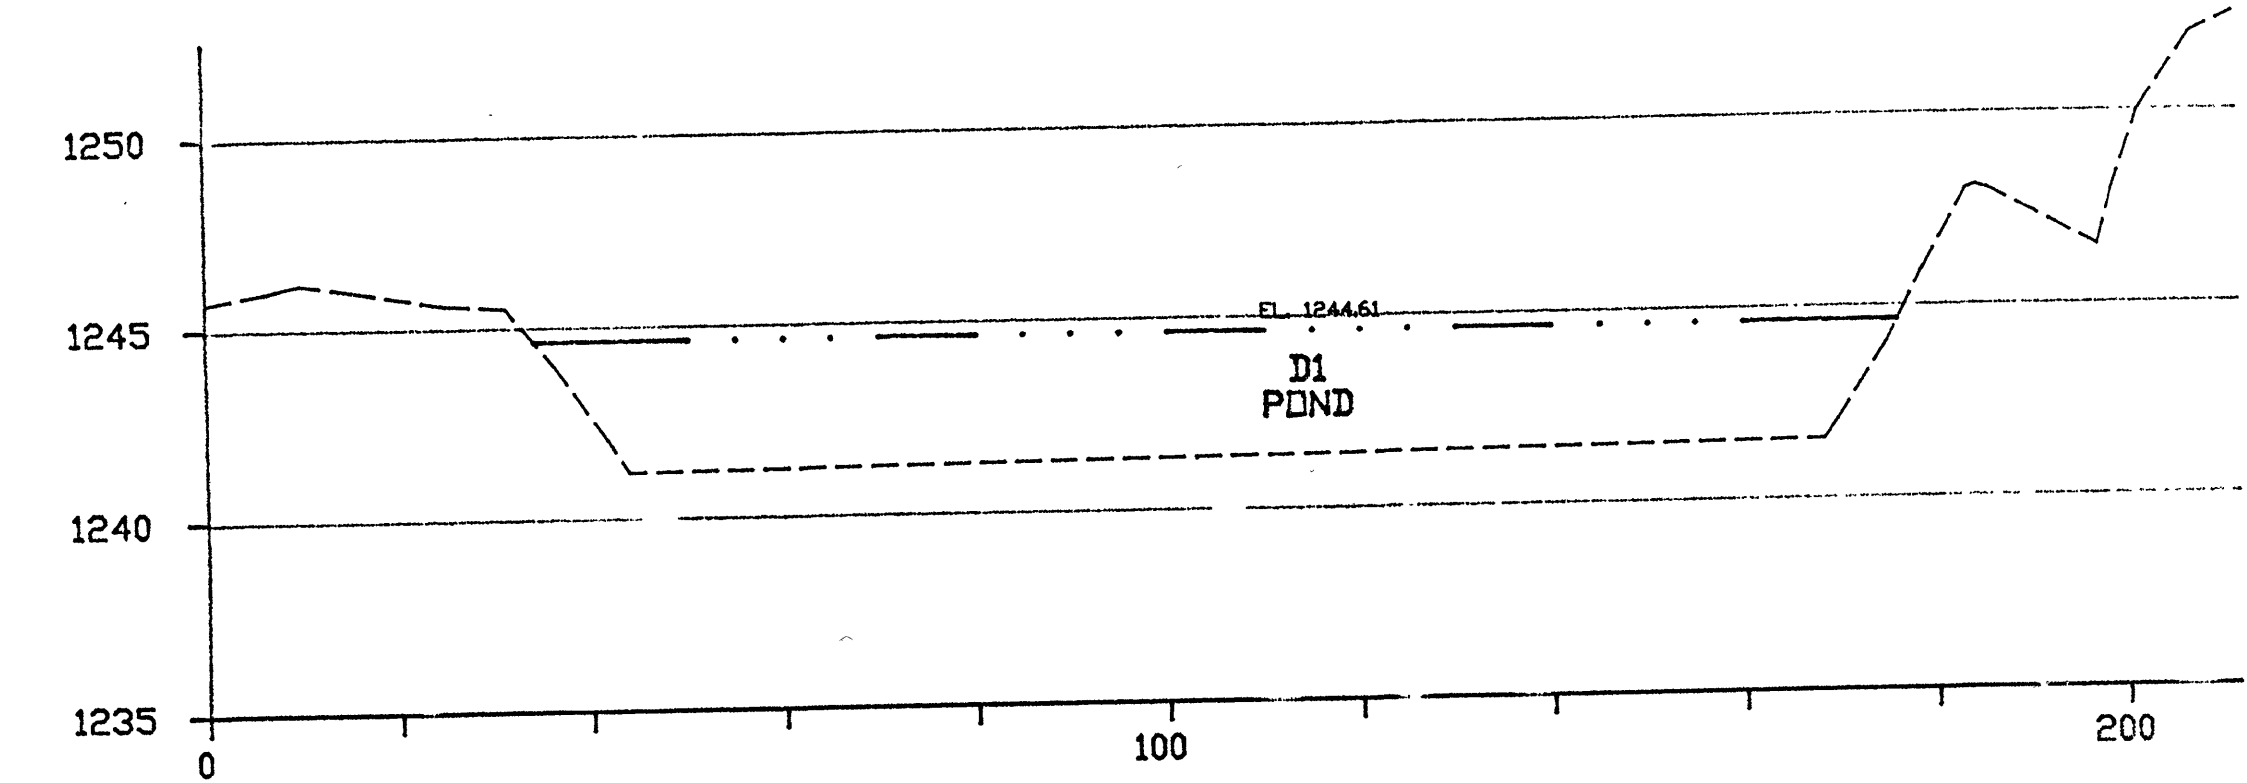


SECTION D4
Scale: 1" = 20' Hor
Scale: 1" = 5' Vert

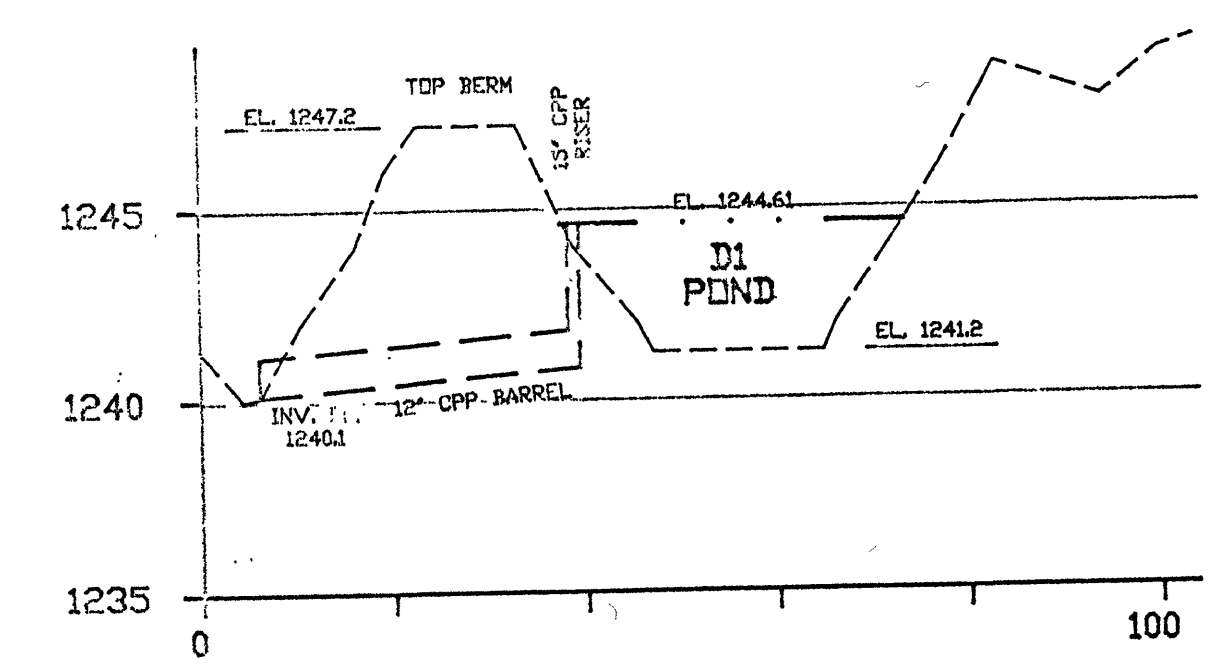


SECTION D5
Scale: 1" = 20' Hor
Scale: 1" = 5' Vert

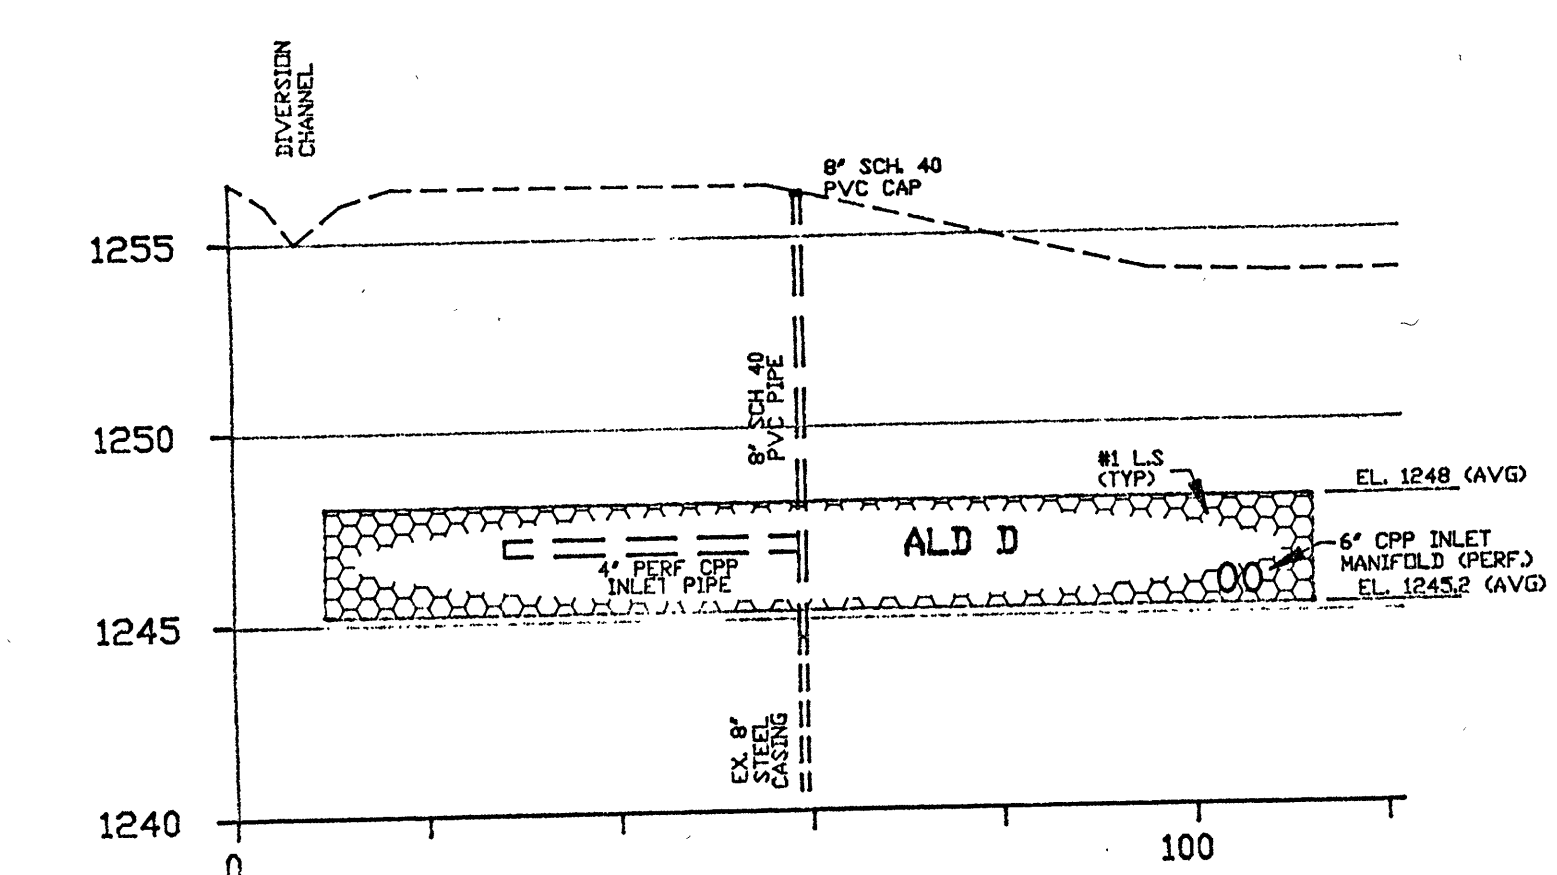


SECTION D1
Scale: 1" = 20' Hor
Scale: 1" = 5' Vert

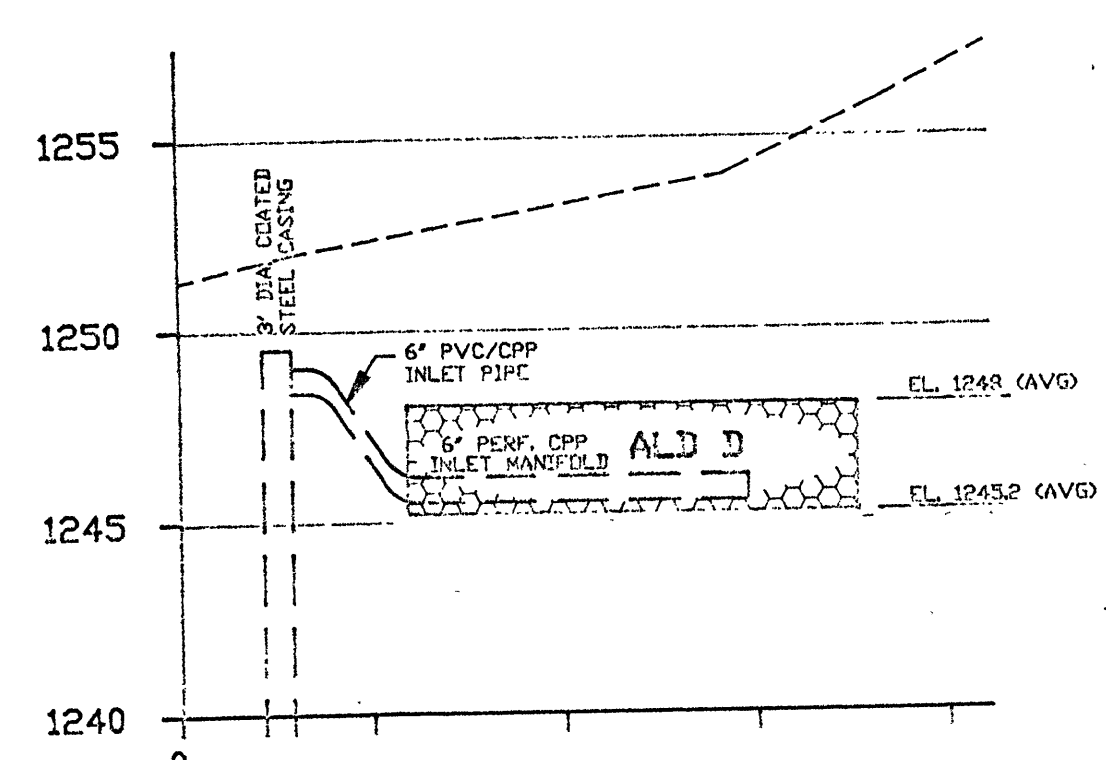

SECTION D2
Scale: 1" = 20' Hor
Scale: 1" = 5' Vert

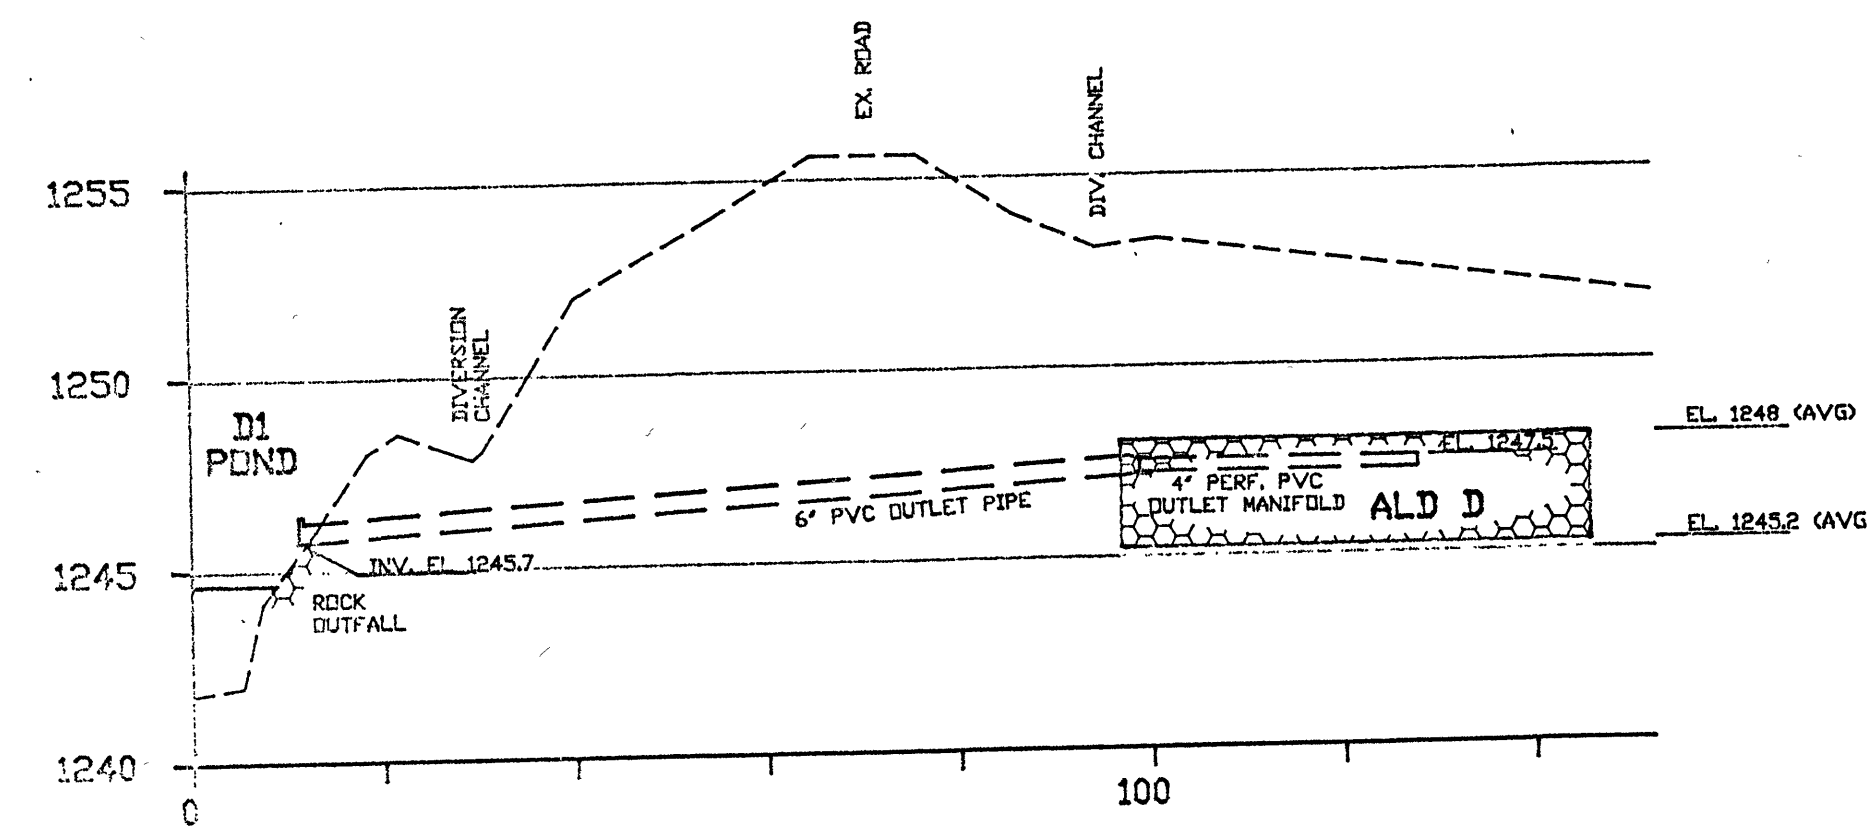

SECTION D3
Scale: 1" = 20' Hor
Scale: 1" = 5' Vert

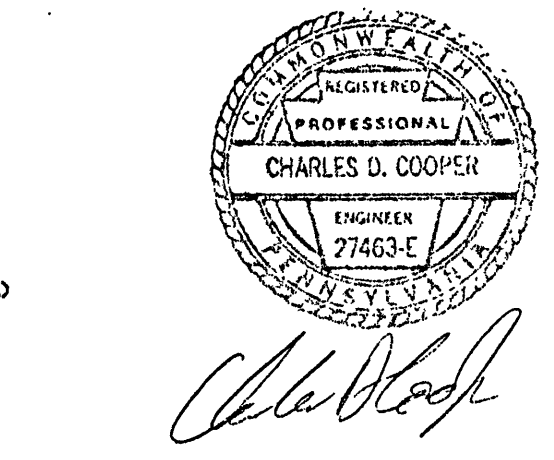

REV. NO.	DATE	REVISION

AS BUILT
CROSS-SECTIONS
Proposed Passive Treatment System
ARGENTINE SITE
Discharges 114A, B, C & D
PA STATE GAME LANDS # 95
situate in
Washington Township, Butler County, PA
made for
HEDIN ENVIRONMENTAL
Scale: as shown Date: 11/95
C D S Associates, Inc.
Coraopolis, PA
No. 94393