




DEWATERING BASIN
Vertical Scale: None Horizontal Scale: None

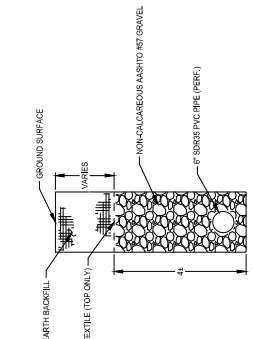


ANOXIC COLLECTION SYSTEM (ACS)
Vertical Scale: None Horizontal Scale: None

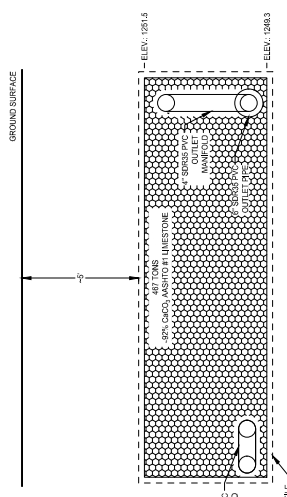


ANOXIC LIMESTONE DRAIN B (ALD B)
B1 SECTION VIEW
Vertical Scale: None Horizontal Scale: None

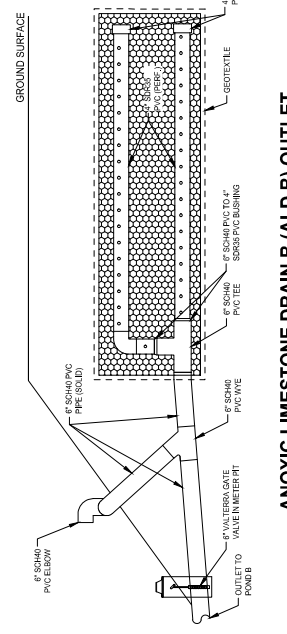


ANOXIC LIMESTONE DRAIN B (ALD B) OUTLET
B2 SECTION VIEW
Vertical Scale: None Horizontal Scale: None

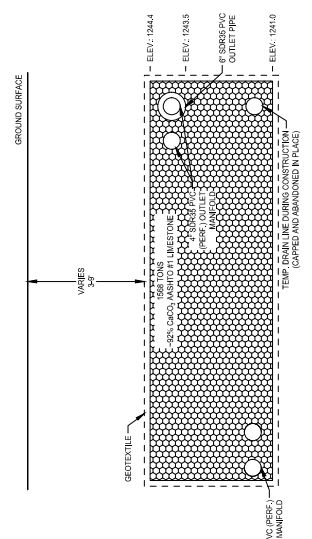

ANOXIC LIMESTONE DRAIN D (ALD D)
D1 SECTION VIEW
Vertical Scale: None Horizontal Scale: None

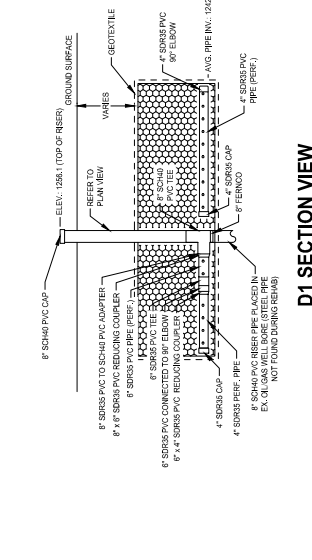


D2 SECTION VIEW
Vertical Scale: None Horizontal Scale: None

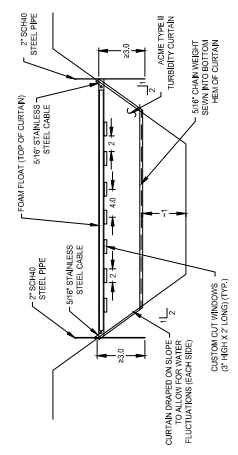


WINDOWED BAFFLE CURTAIN
Vertical Scale: None Horizontal Scale: None

Note:
1. All baffle curtain doors will have windows
out into it, and doors will extend across the entire
pond (see plan view).

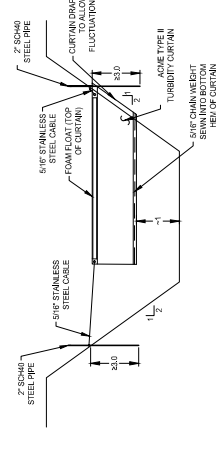

DIRECTIONAL BAFFLE CURTAIN
Vertical Scale: None Horizontal Scale: None

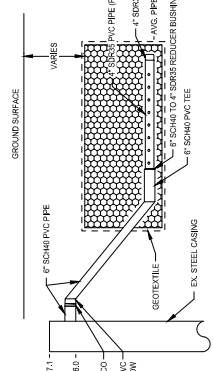

D2 SECTION VIEW
Vertical Scale: None Horizontal Scale: None

	CLIENT	STREAM RESTORATION INCORPORATED PO BOX 837 SLIPPERY ROCK, PA 16957	NO. BY DATE DESCRIPTION REVISIONS	CONTRACTOR CODY A. NEELY, P.E. PROJECT ENGINEER, PA, INC.	ALL SETTING CONDITIONS SHALL BE CHECKED AND VERIFIED AT THE SITE PRIOR TO PERFORMING ANY MAINTENANCE WORK.	DRAWING NO. SR114-As-Built-03	PROJECT NAME SR114 As-Built-03	COUNTY WASHINGTON TOWNSHIP	COUNTY BUTLER COUNTY
	PROJECT	SR114 Rehabilitation Project As-Built							