


REV. NO.	DATE	REVISION

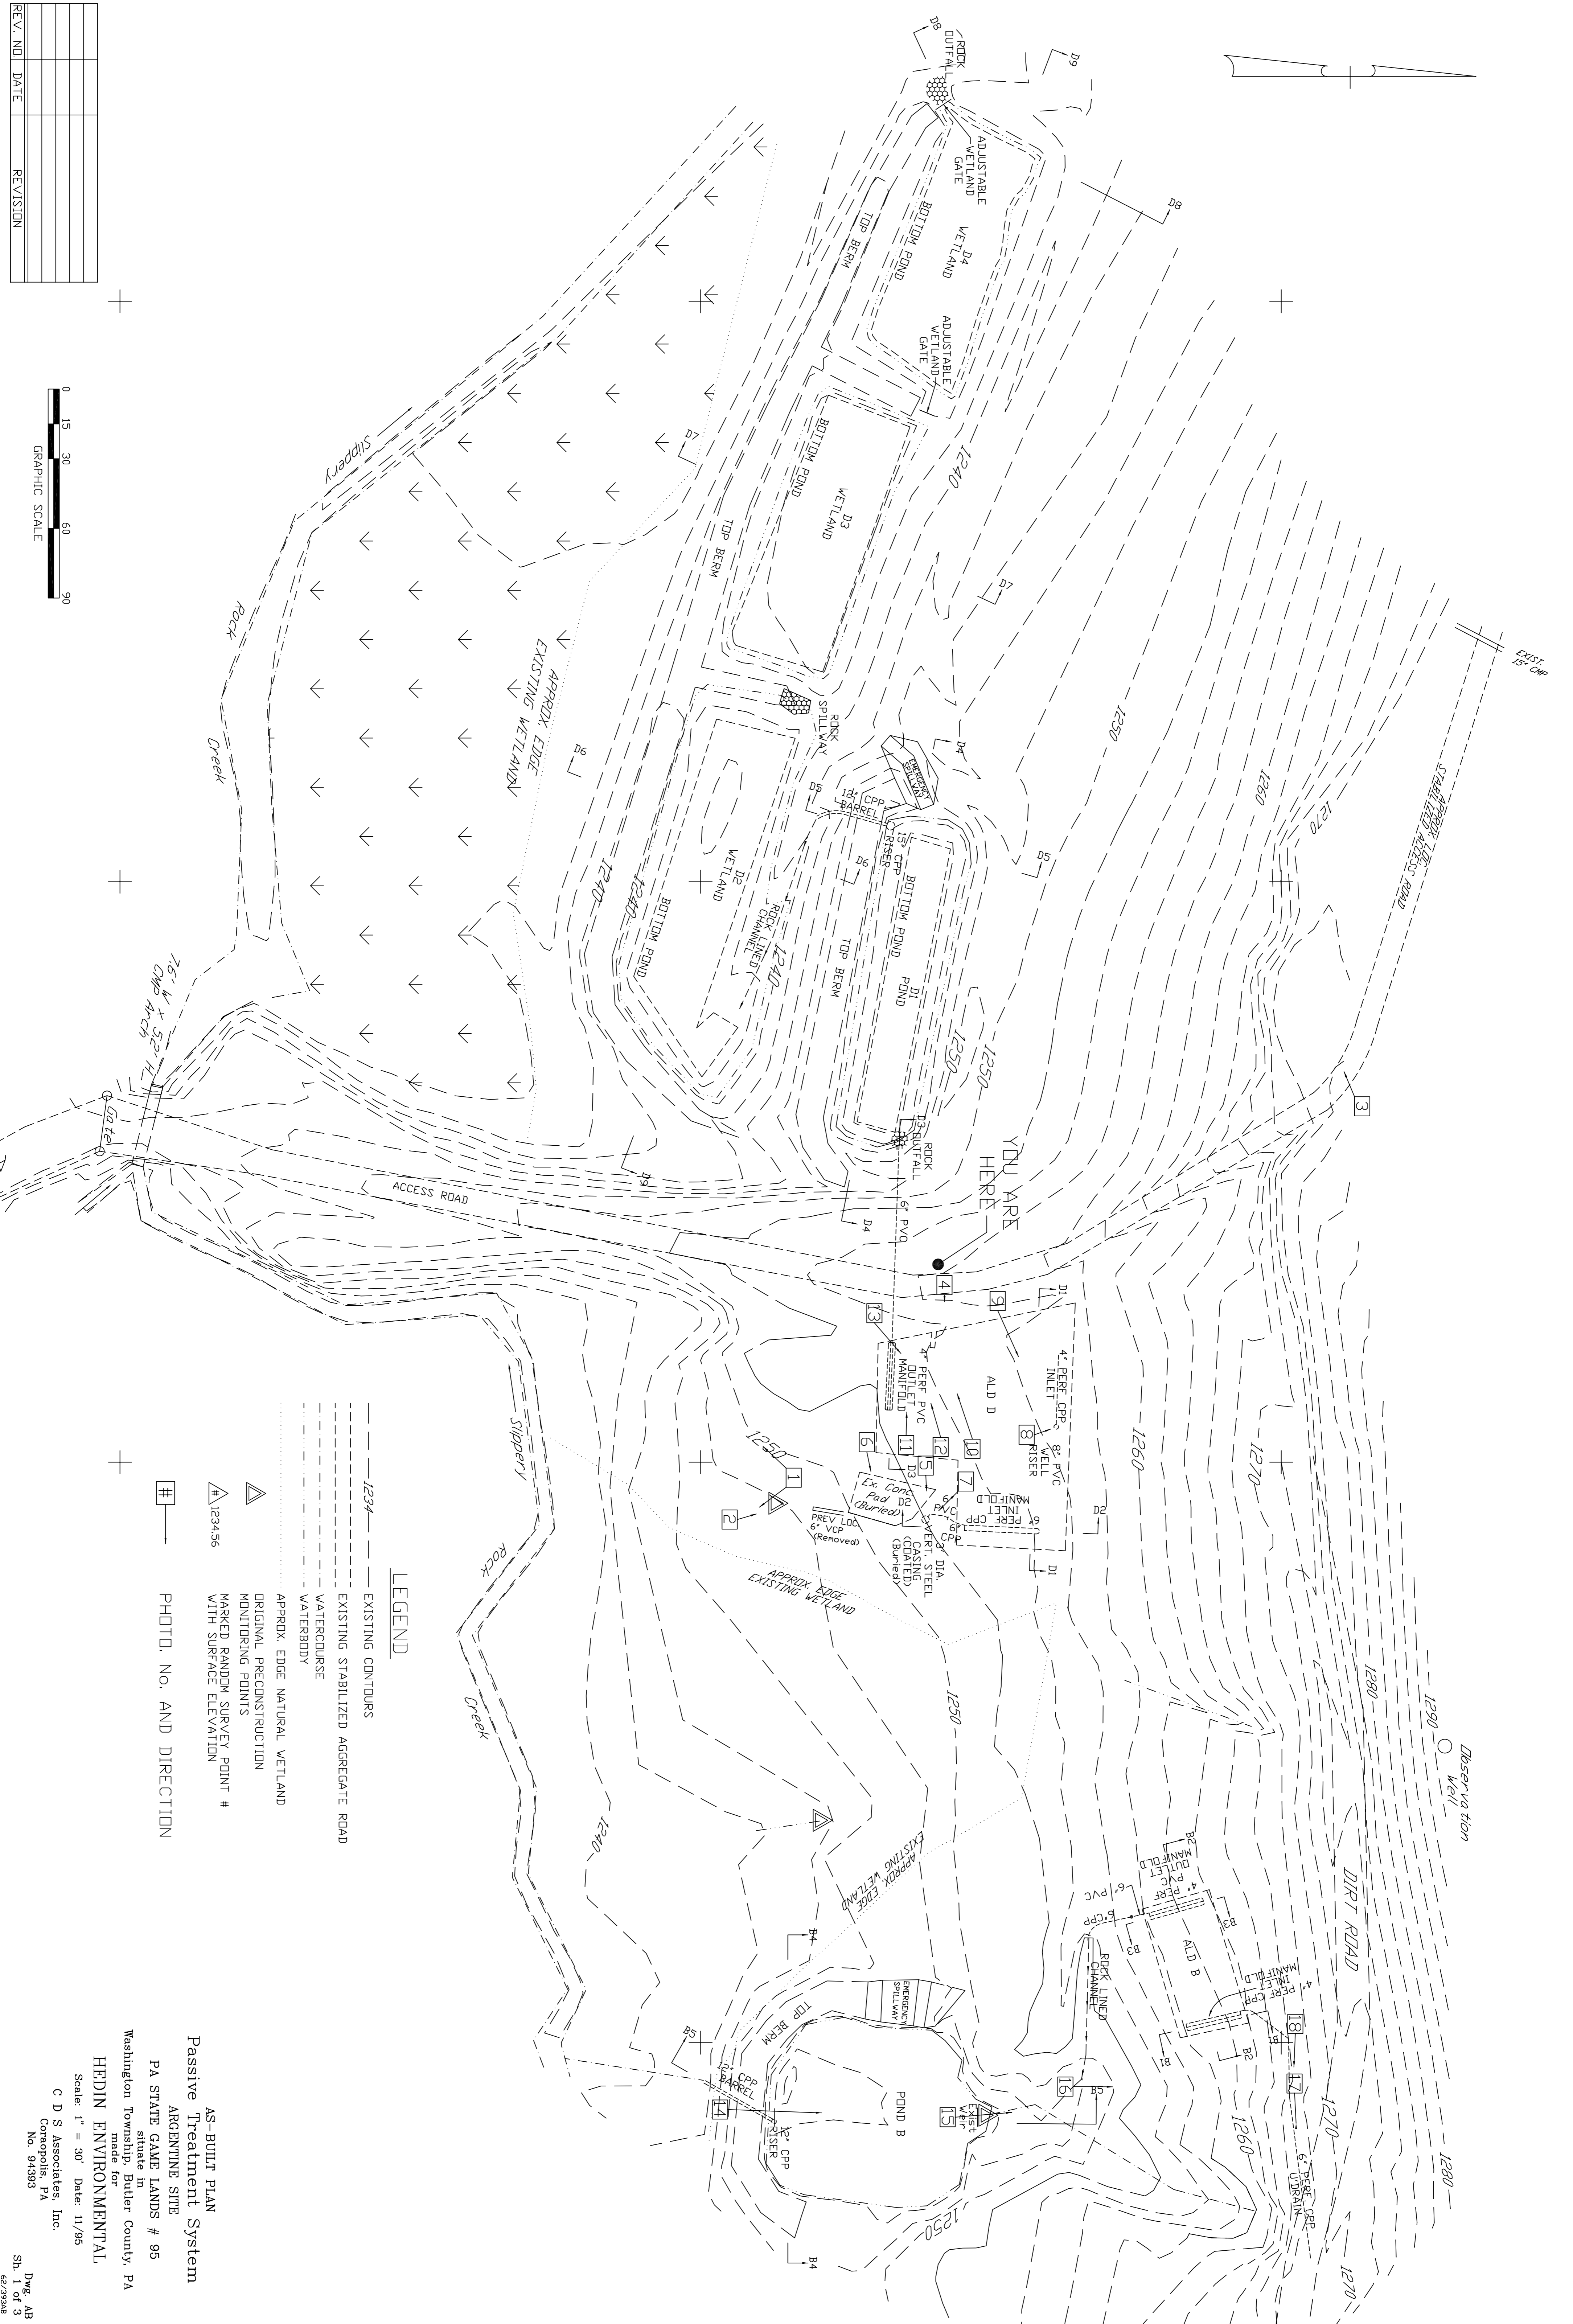

LEGEND

	1234	EXISTING CONTOURS
	---	EXISTING STABILIZED AGGREGATE ROAD
	---	WATERCOURSE
	---	WATERBODY
	---	APPROX. EDGE NATURAL WETLAND
	▲	ORIGINAL PRECONSTRUCTION MONITORING POINTS
	▲ # 123456	MARKED RANDOM SURVEY POINT WITH SURFACE ELEVATION
	■ #	PHOTO. NO. AND DIRECTION

AS-BUILT PLAN
Passive Treatment System
ARGENTINE SITE
PA STATE GAME LANDS # 95
Washington Township, Butler County, PA
made for
situate in
HEDIN ENVIRONMENTAL
Scale: 1" = 30' Date: 11/95
C D S Associates, Inc.
Coraopolis, PA
No. 94393