



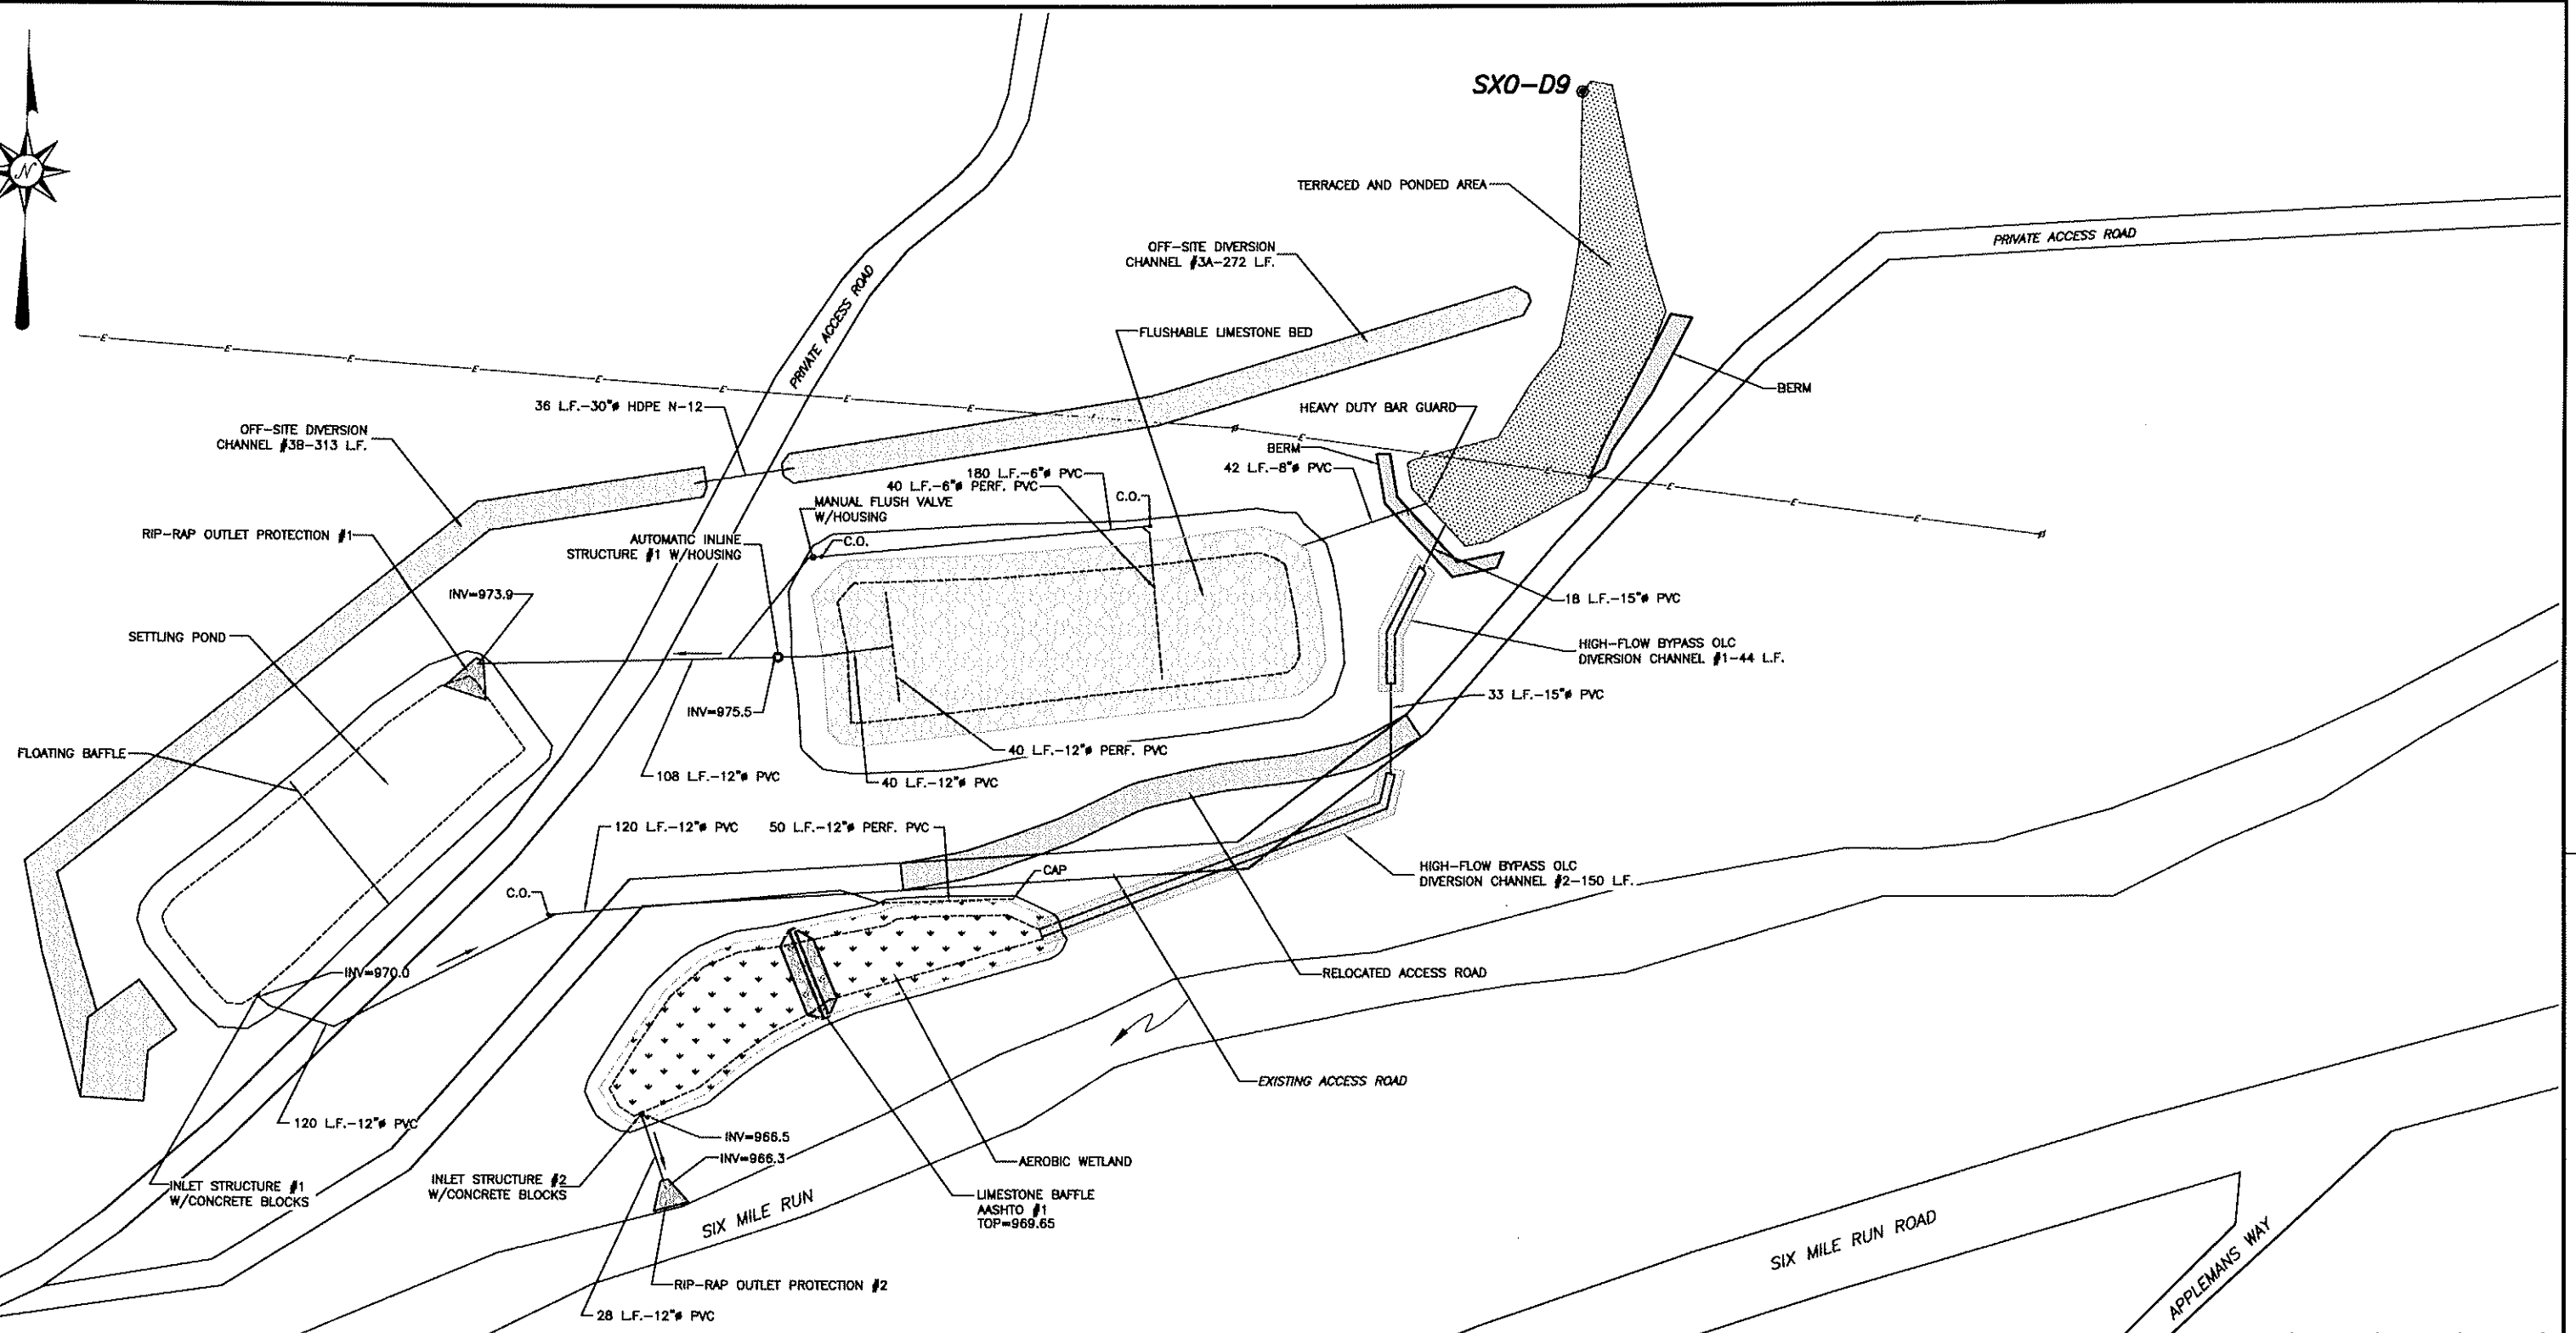

NOTE:
1. AN AS-BUILT FIELD SURVEY WAS PERFORMED ON APRIL 23, 2015.

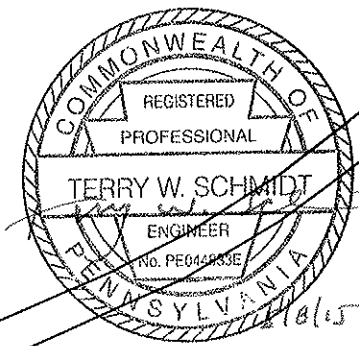

SKELLY and LOY Inc. ENGINEERS-ENVIRONMENTAL CONSULTANTS	05/05/15	DWG NO. C-1
RECORD DRAWING SX0-D9 AMD REMEDIATION PROJECT BROAD TOP TOWNSHIP BEDFORD COUNTY, PA PREPARED FOR: BROAD TOP TOWNSHIP		
R11-0379.000	SCALE: AS SHOWN	