
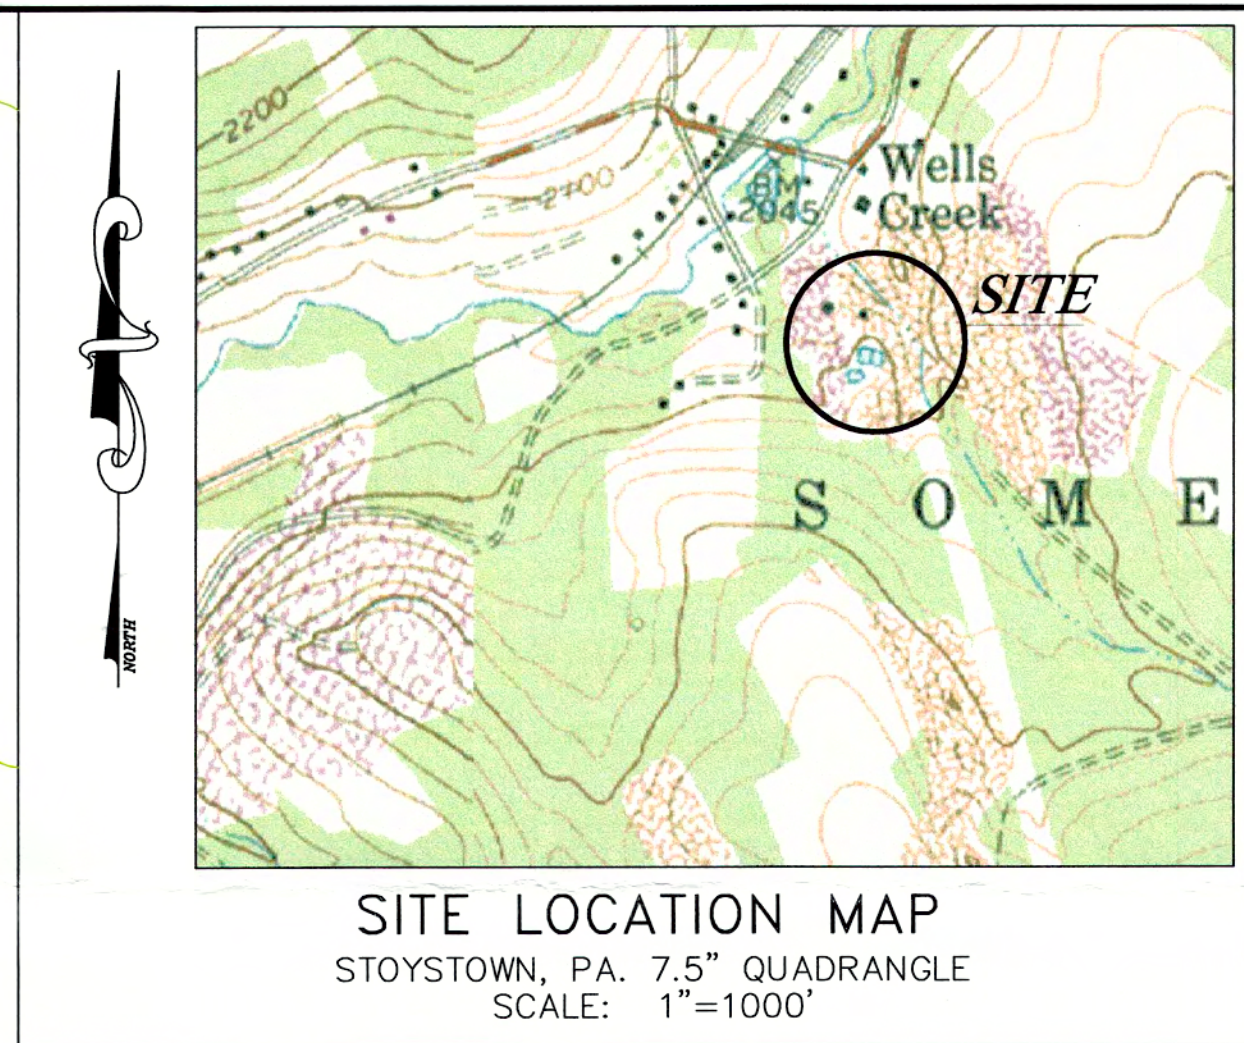



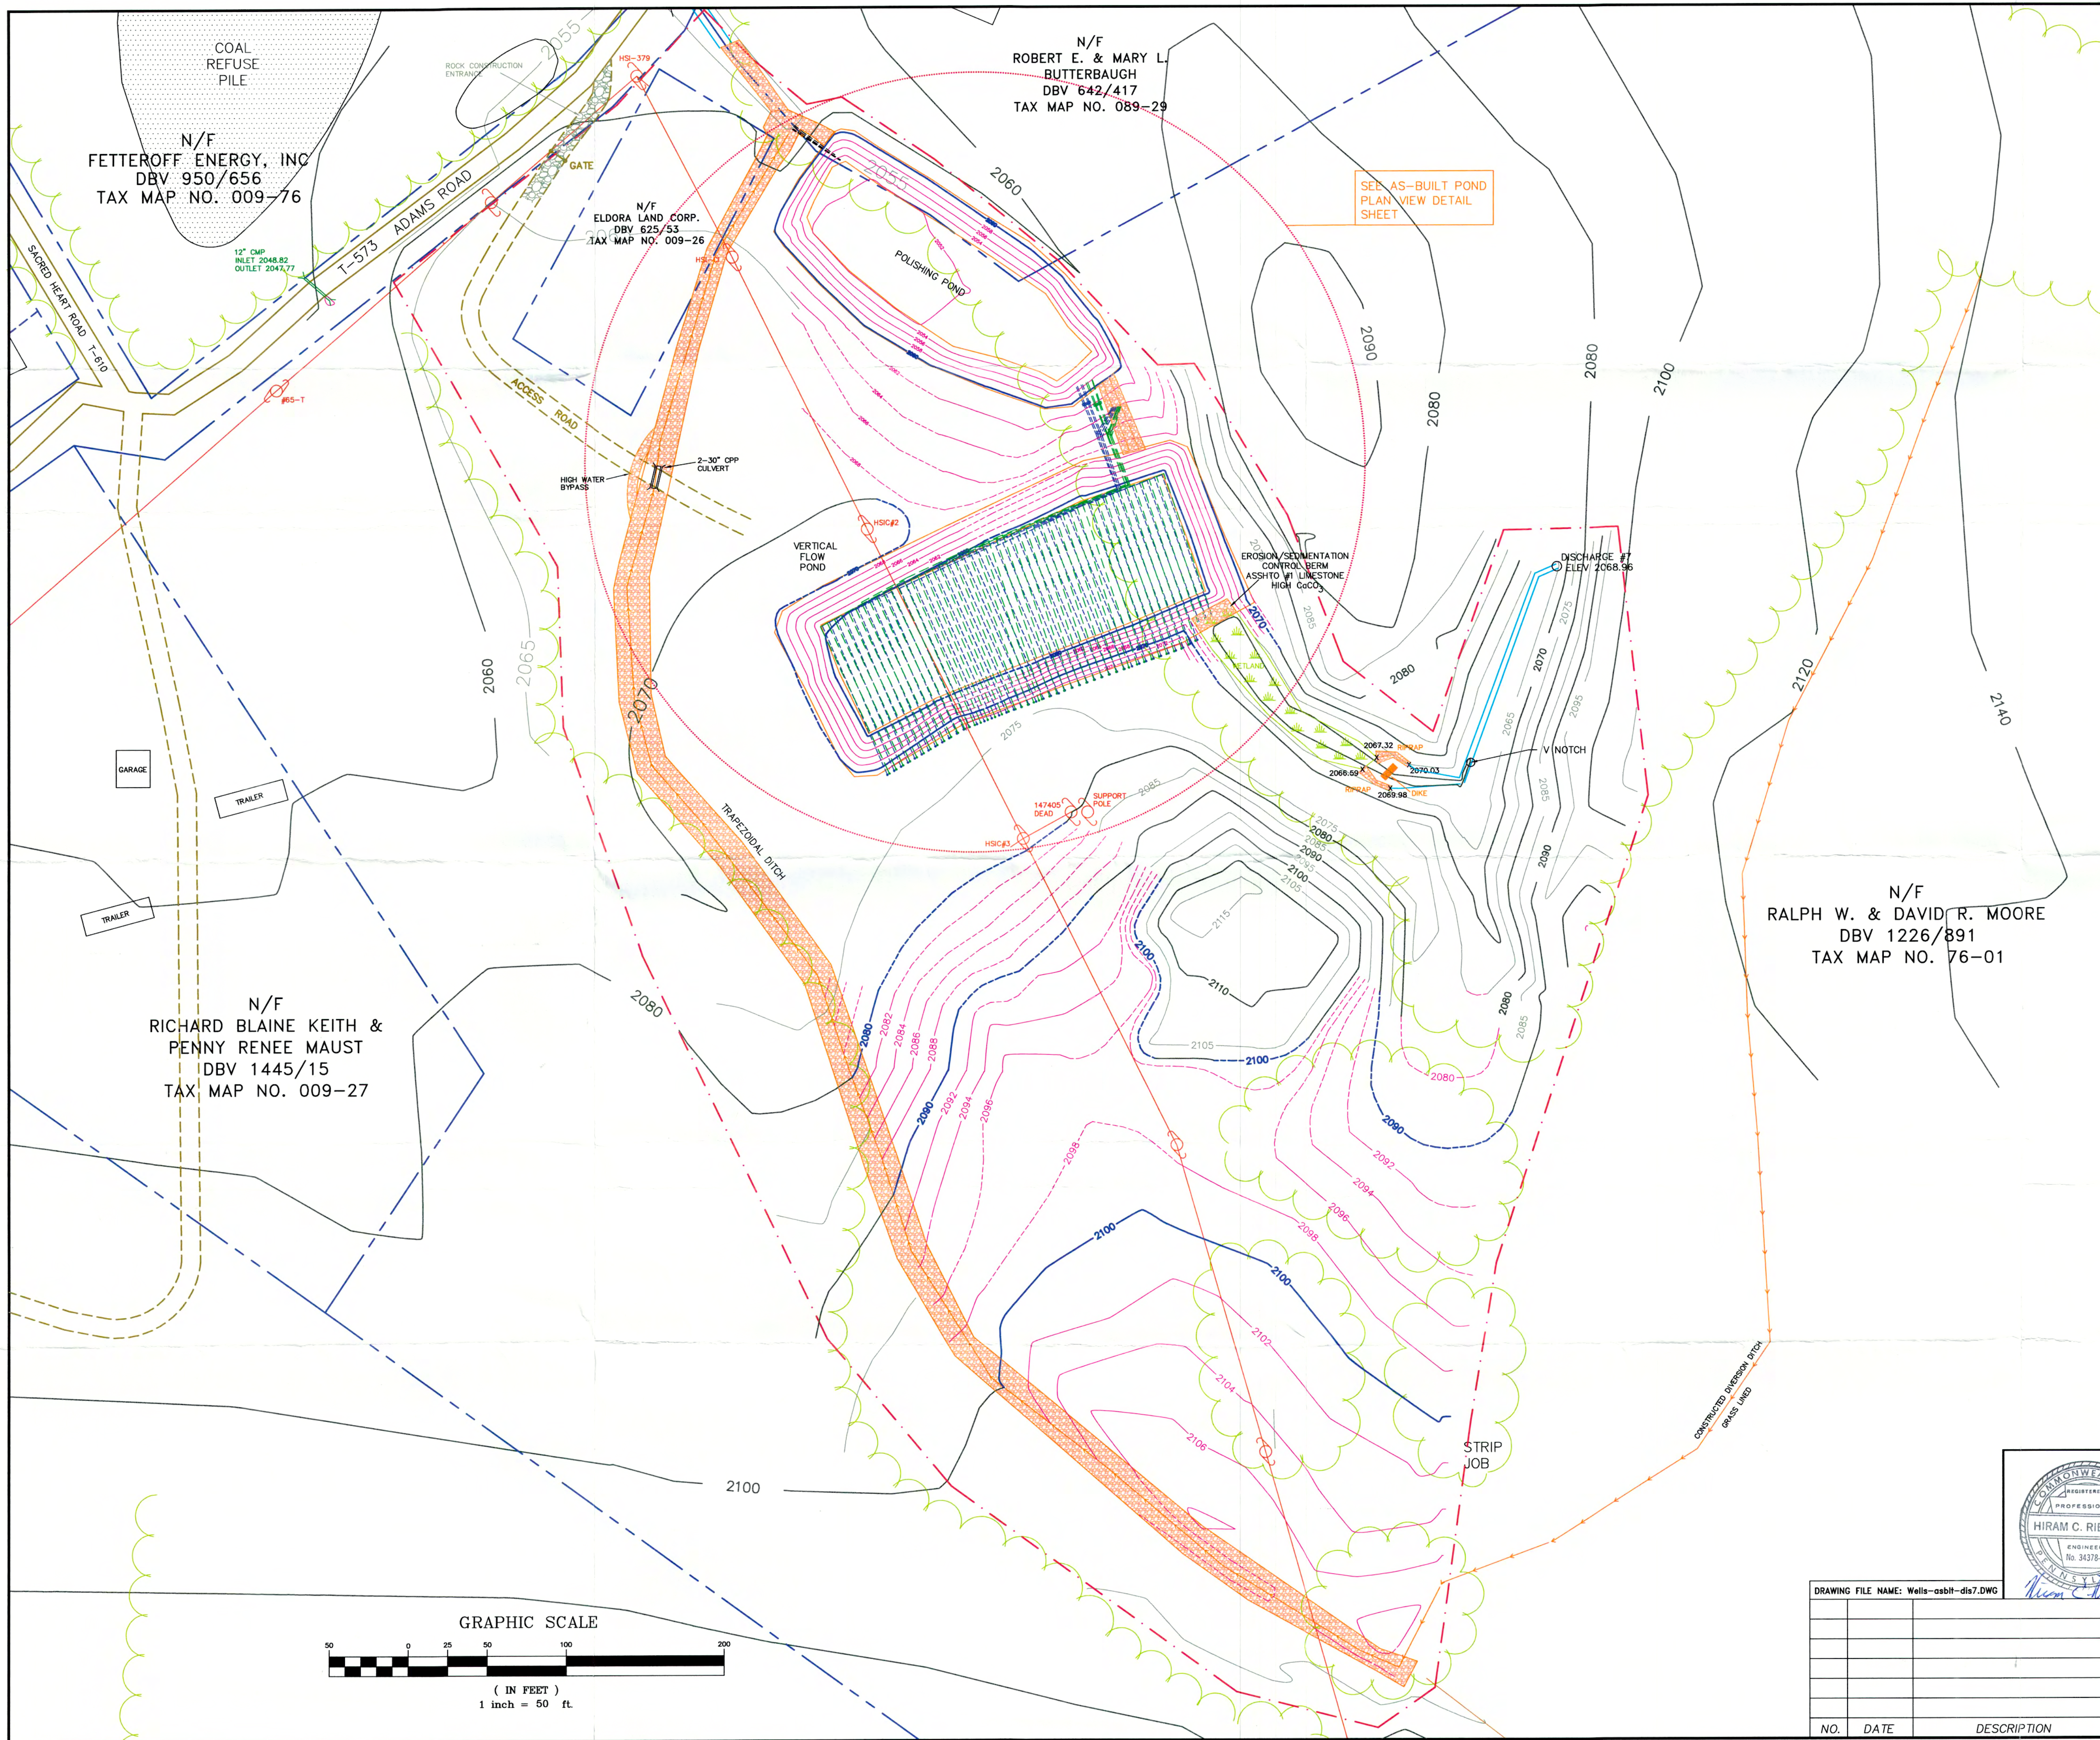


LEGEND:

- Property Line
- Railroad
- Tree Line
- Existing Contours
- As-built Contours
- Diversion Ditch
- Utility Line
- Stream
- Filter Fence and/or Staked Hay Bales
- Existing Property Marker
- Utility Pole
- Bridge
- Gate
- Guard Rail

NOTE:
 1. PROPERTY LINES ARE TAKEN FROM TAX MAPS AND DEED DESCRIPTIONS.
 2. LOCATIONS OF STRUCTURES (i.e. HOUSES, BARN, GARAGES, ROADS, COAL REFUSE PILES) ARE APPROXIMATE.

PROJECT AREA
 10.7 ACRES

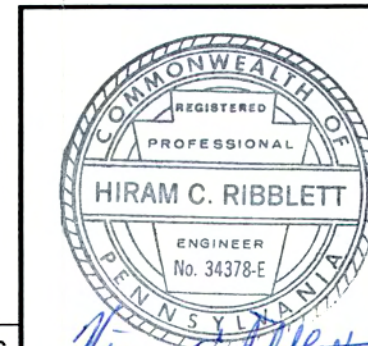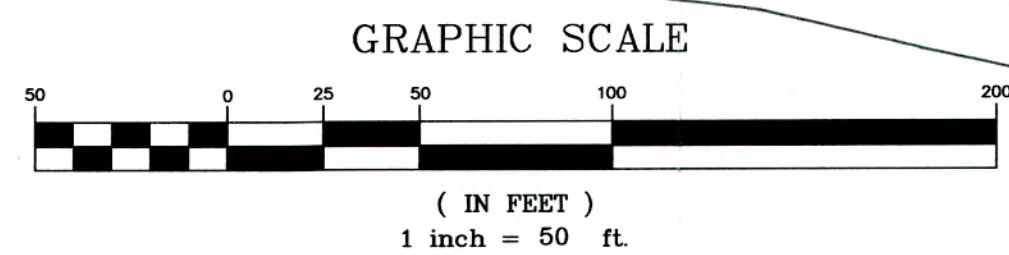

DRAWING FILE NAME: Wells-asbtl-dwg7.DWG

NO.	DATE	DESCRIPTION	BY

EXHIBIT II - PASSIVE TREATMENT SYSTEM PLAN - AS-BUILT

WELLS CREEK WATERSHED ASSOCIATION


ADAMS STATION DISCHARGE #7

SOMERSET TOWNSHIP

SOMERSET COUNTY, PA

SCALE: 1" = 50' DATE: February 26, 2004


Earthtech, Inc.
 336 Bloomfield Street, Suite 201 Johnstown, PA 15904
 Telephone: (814) 266-6402 Fax: (814) 266-6530
www.scientificengineers.com

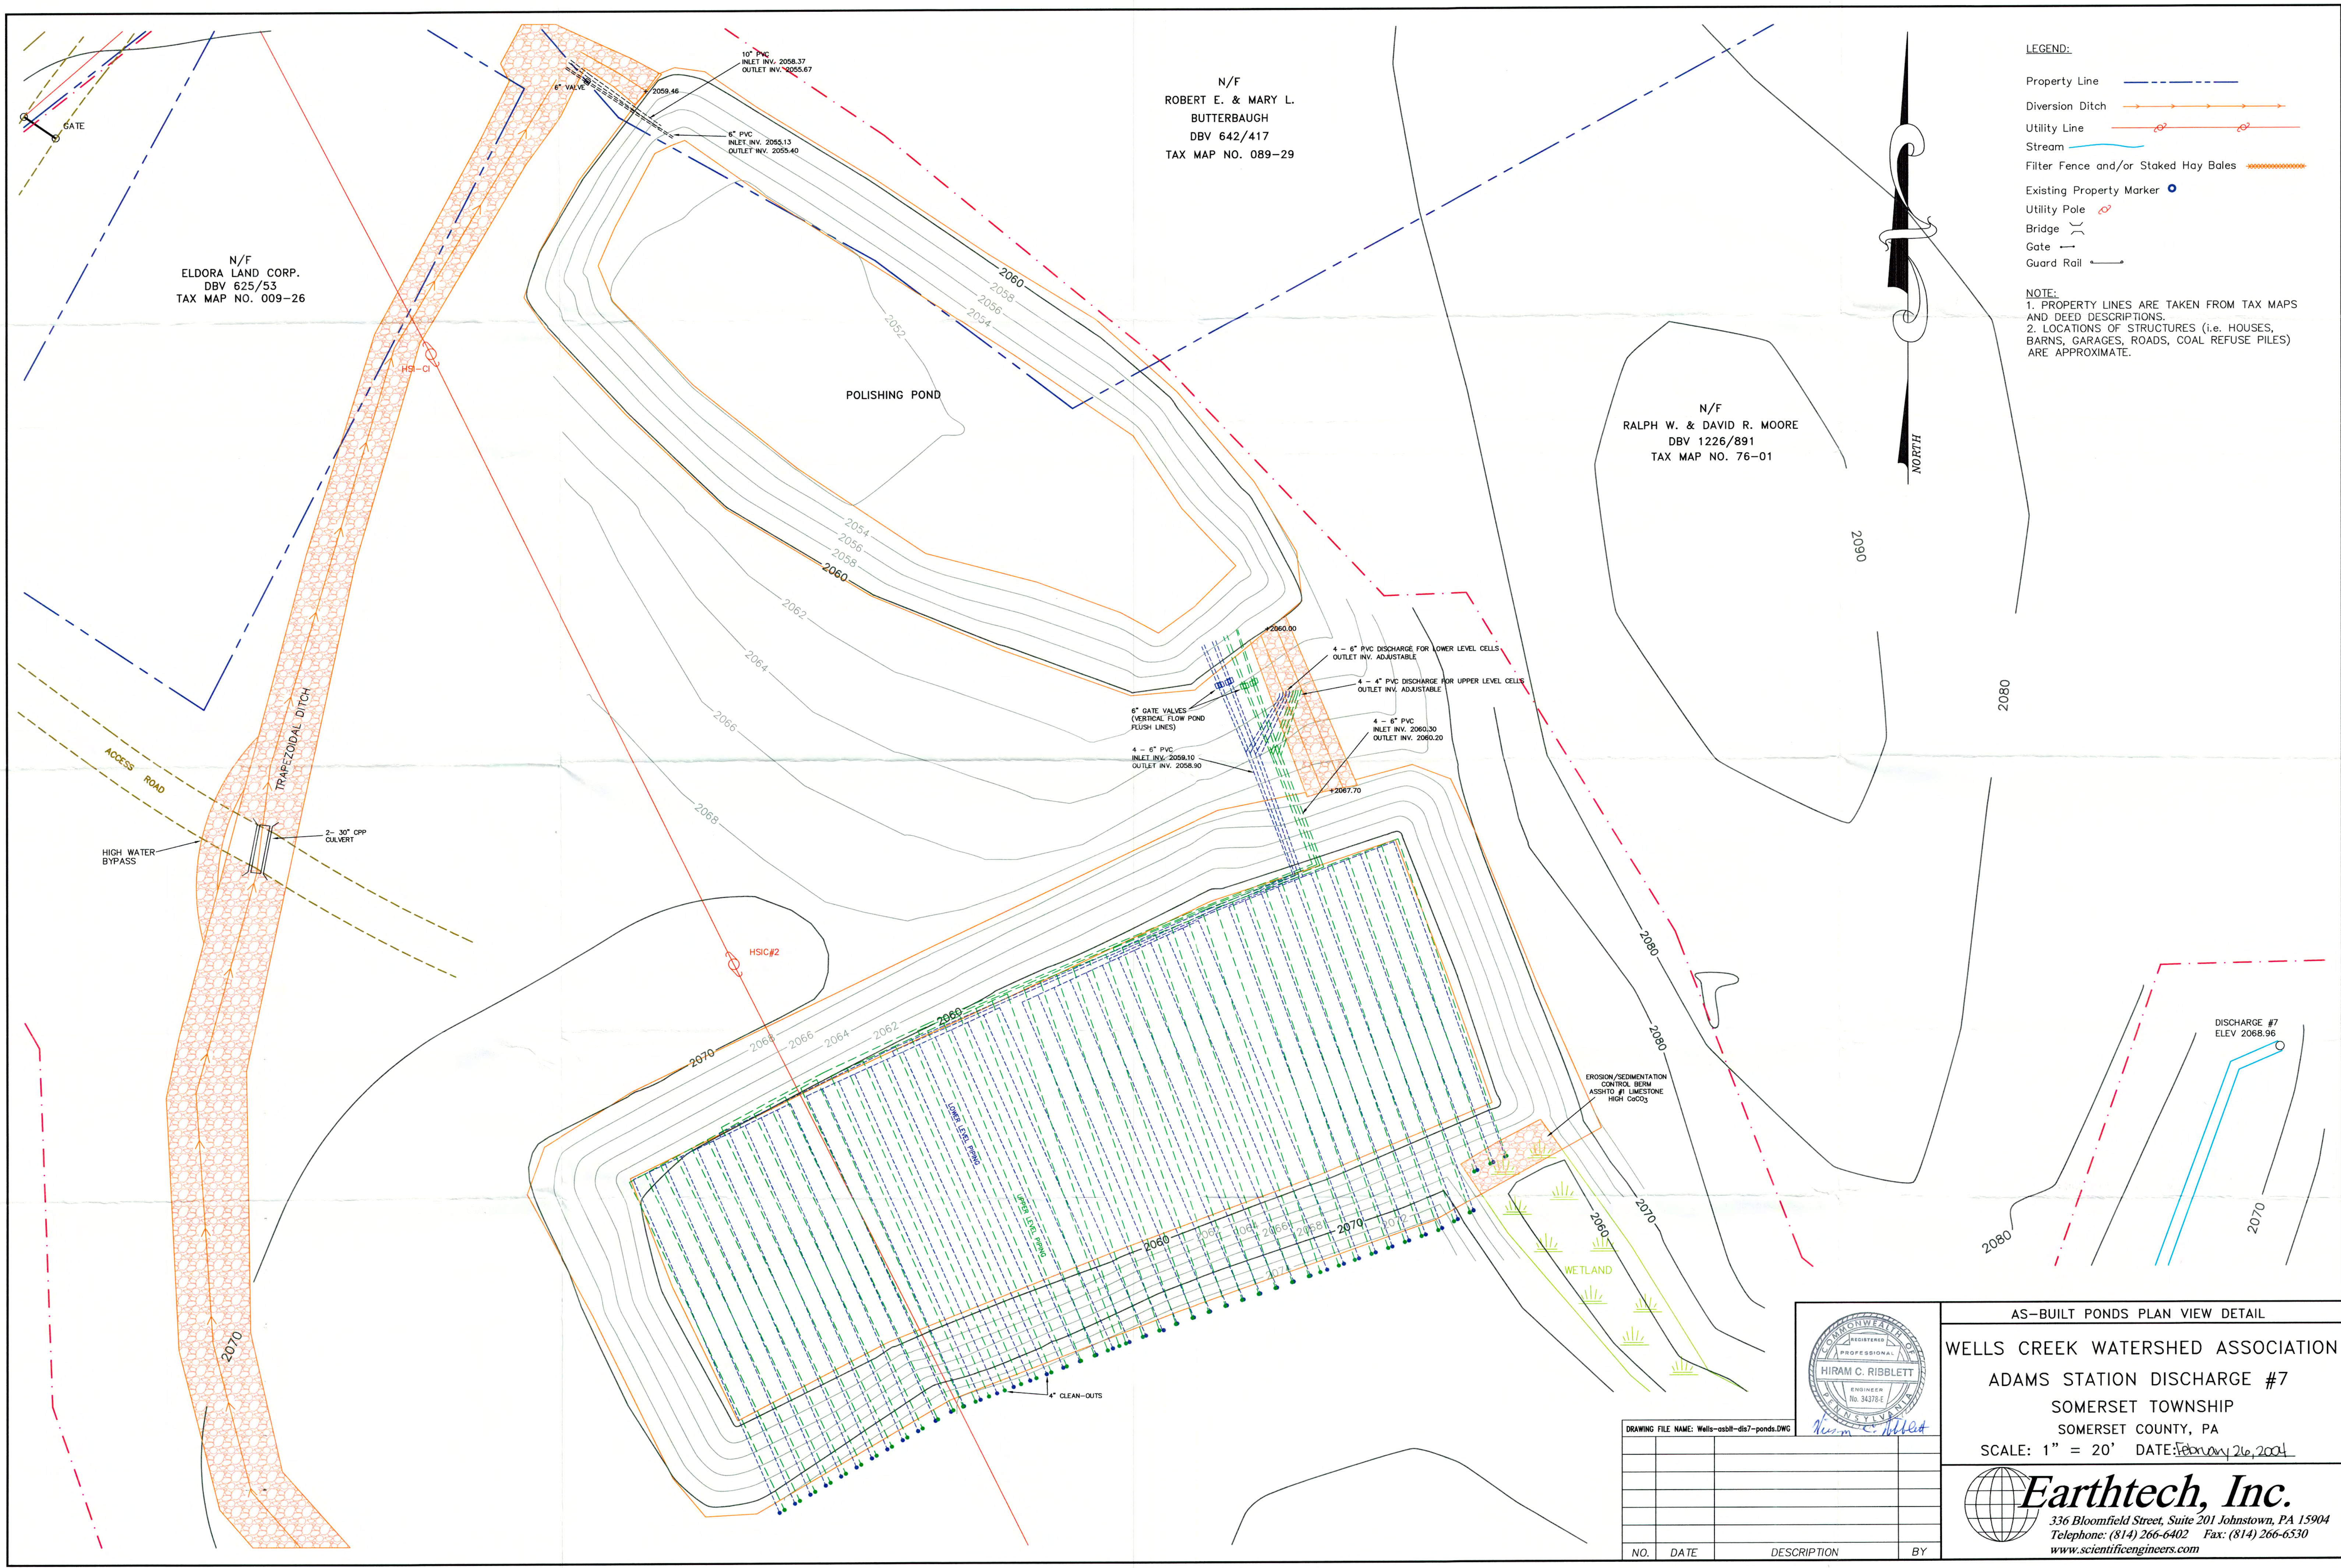

LEGEND:

- Property Line
- Diversion Ditch
- Utility Line
- Stream
- Filter Fence and/or Staked Hay Bales
- Existing Property Marker
- Utility Pole
- Bridge
- Gate
- Guard Rail

NOTE:
1. PROPERTY LINES ARE TAKEN FROM TAX MAPS AND DEED DESCRIPTIONS.
2. LOCATIONS OF STRUCTURES (i.e. HOUSES, BARN, GARAGES, ROADS, COAL REFUSE PILES) ARE APPROXIMATE.

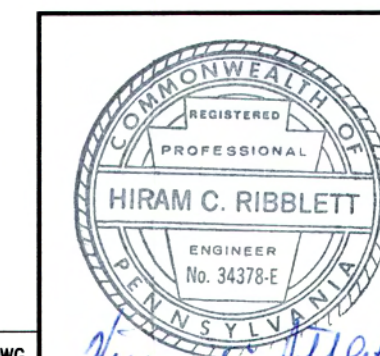


DRAWING FILE NAME: Wells-ashill-dis7-ponds.DWG

NO.	DATE	DESCRIPTION	BY


AS-BUILT PONDS PLAN VIEW DETAIL

WELLS CREEK WATERSHED ASSOCIATION
ADAMS STATION DISCHARGE #7
SOMERSET TOWNSHIP
SOMERSET COUNTY, PA
SCALE: 1" = 20' DATE: February 26, 2004


Earthtech, Inc.
336 Bloomfield Street, Suite 201 Johnstown, PA 15904
Telephone: (814) 266-6402 Fax: (814) 266-6530
www.scientificengineers.com

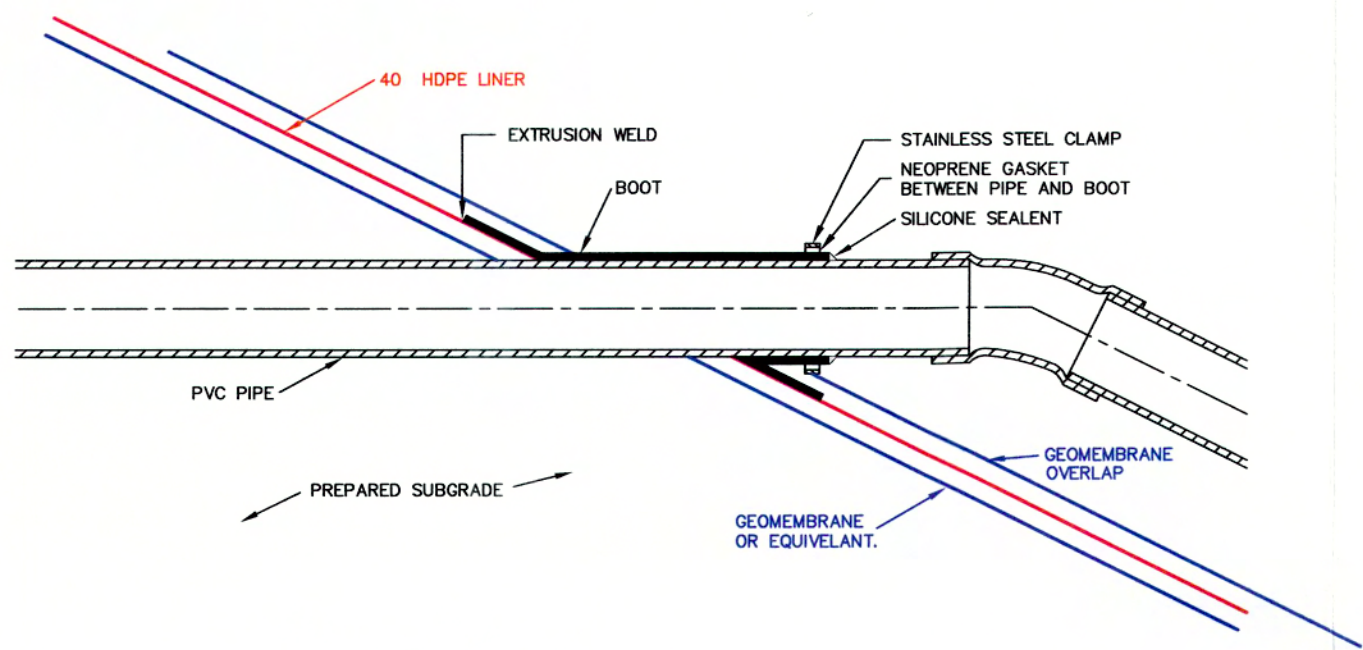


TYPICAL HORIZONTAL PIPE BOOT INSTALLATION DETAIL
FOR POLISHING POND
N.T.S.

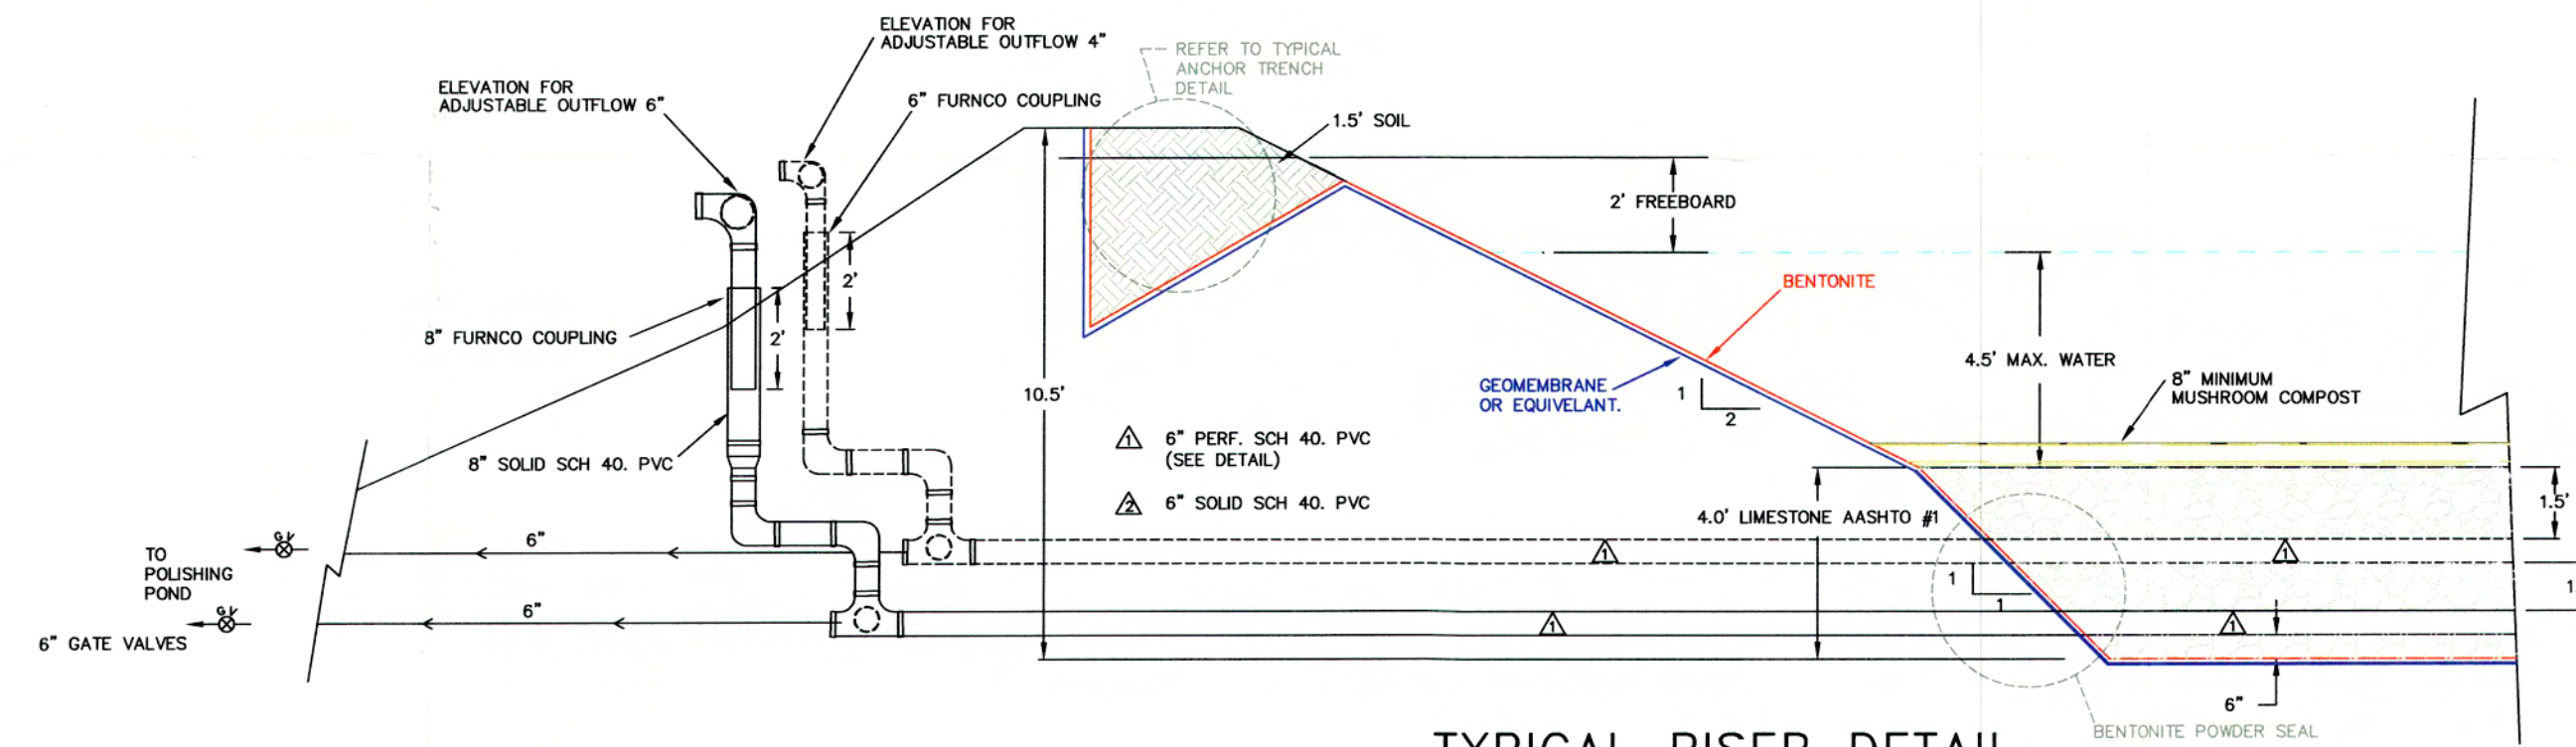


TYPICAL RISER DETAIL
N.T.S.

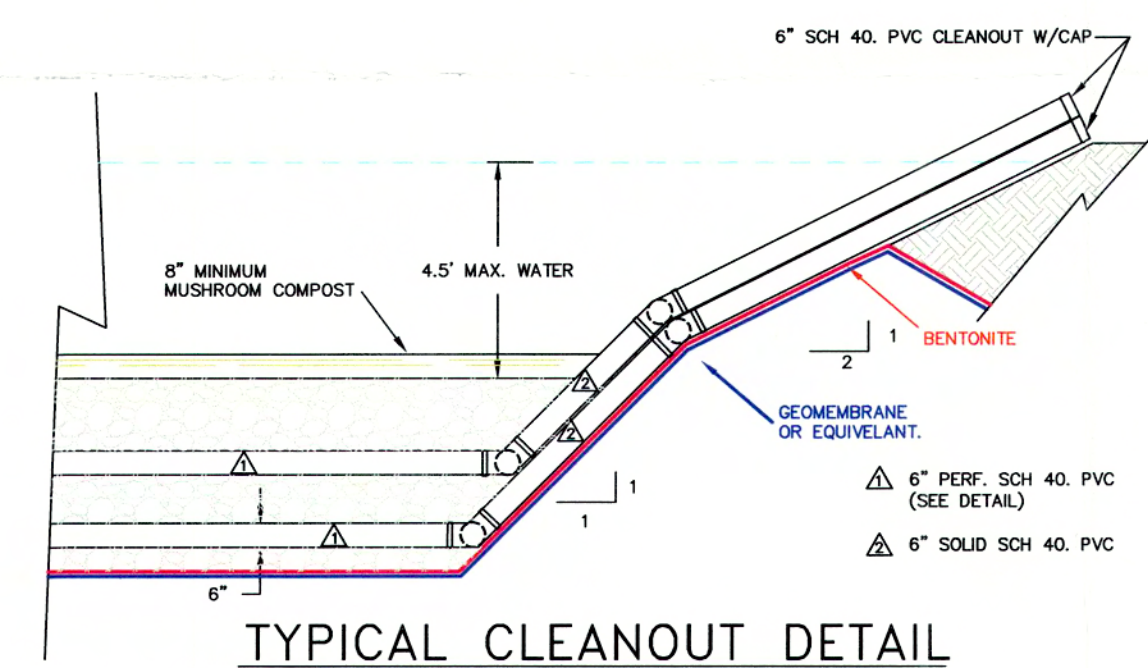


TYPICAL CLEANOUT DETAIL
N.T.S.

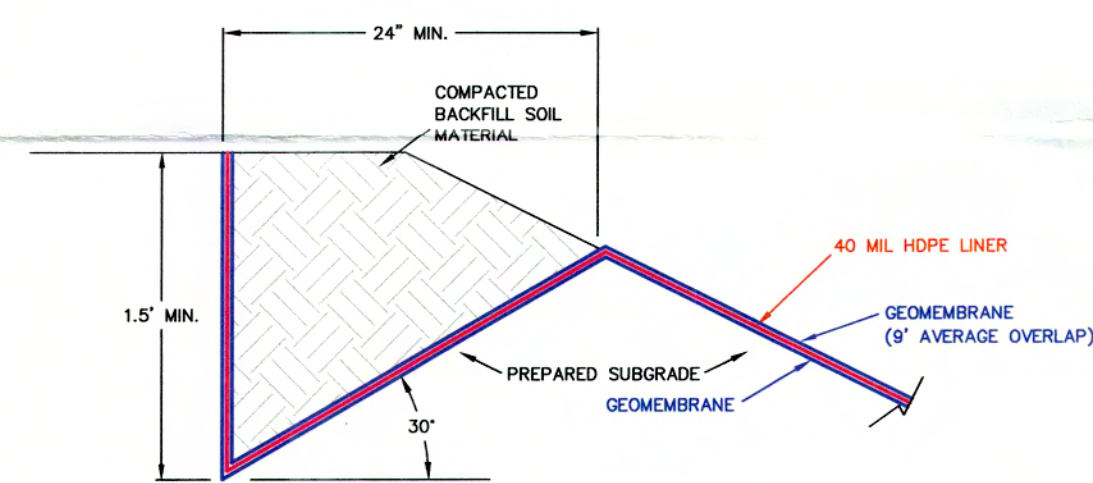


ANCHOR TRENCH DETAIL
N.T.S.

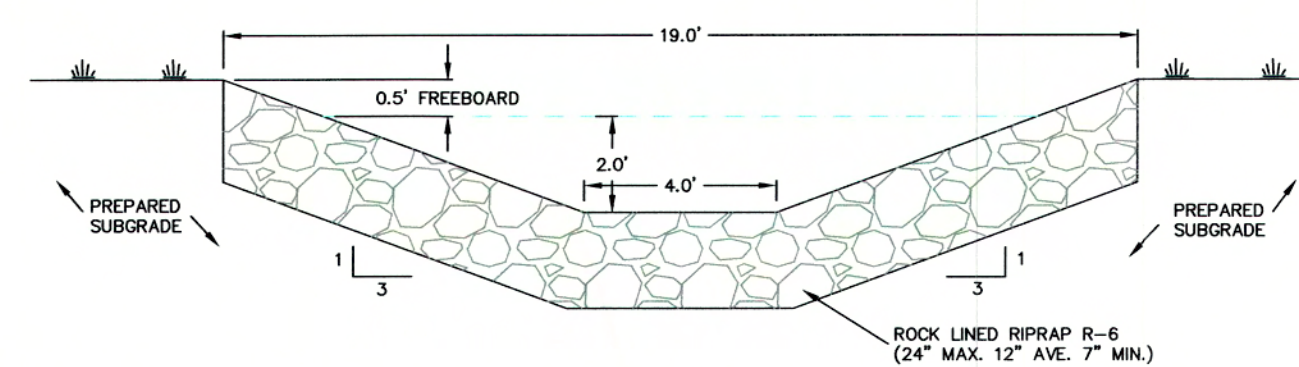


TYPICAL TRAPEZOIDAL DITCH DETAIL
N.T.S.

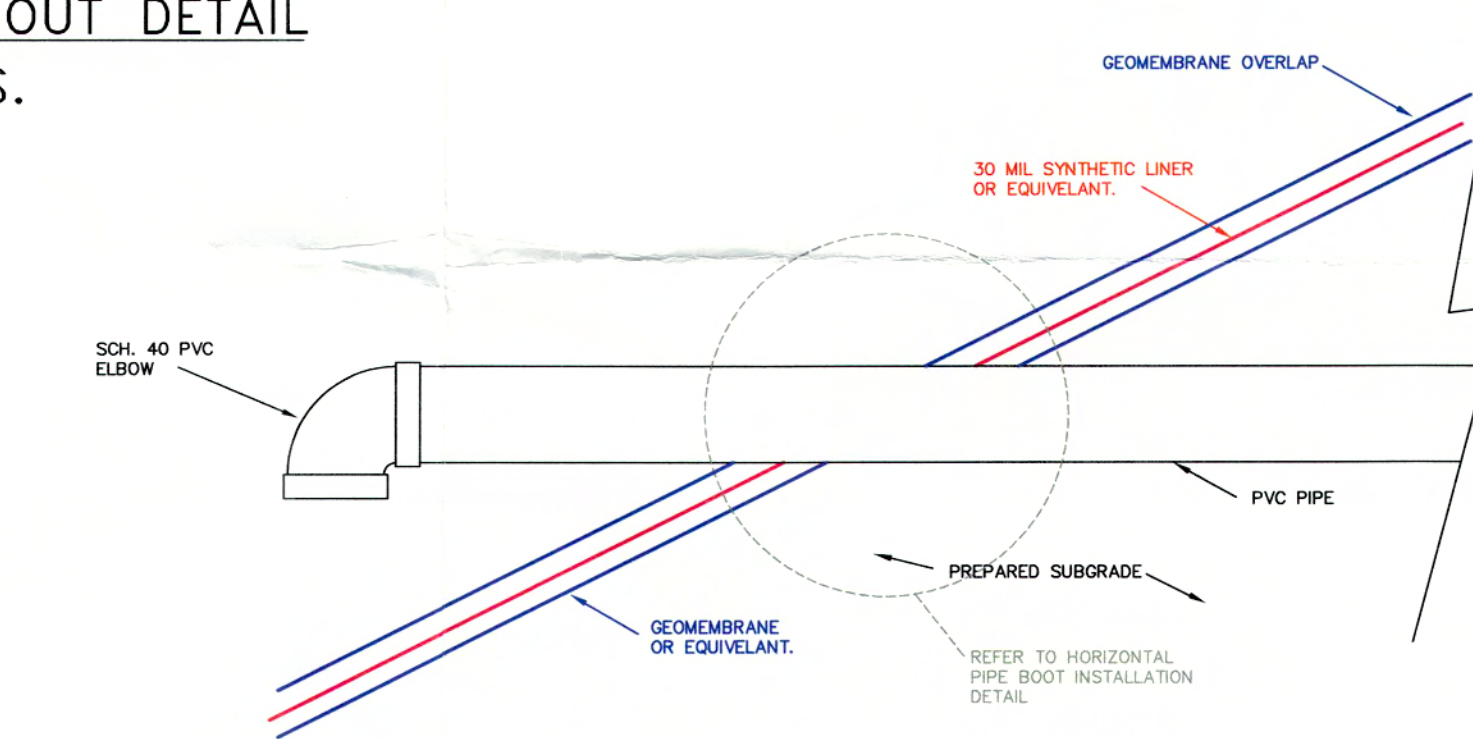


TYPICAL OUTLET DETAIL
N.T.S.

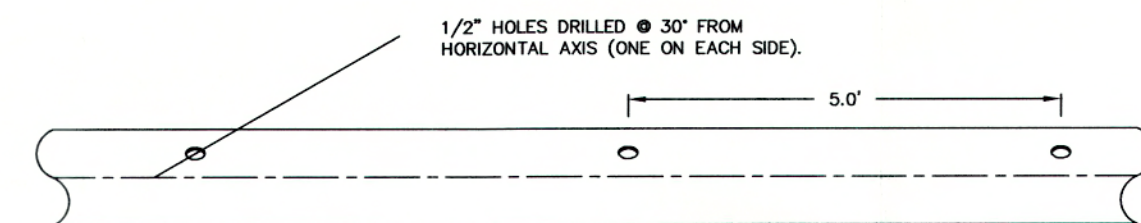


TYPICAL 4" PERF. SCH. 40 PVC DETAIL
N.T.S.

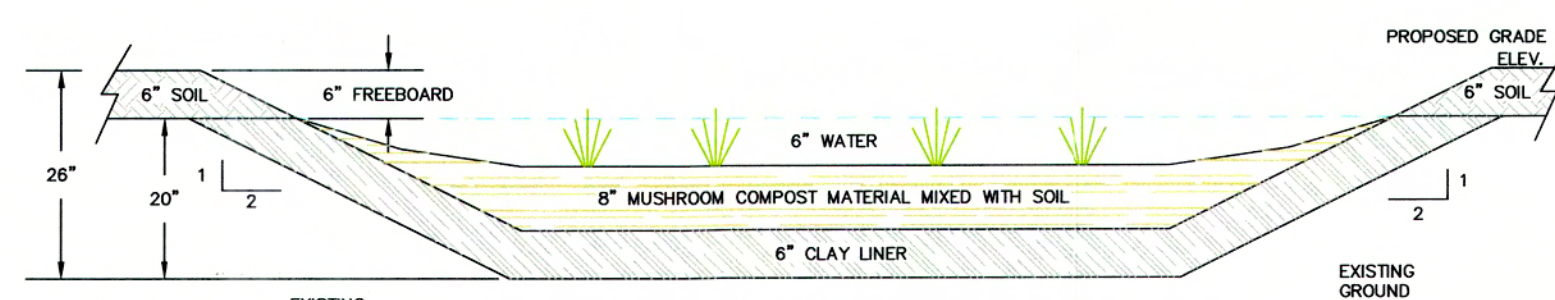

TYPICAL NEW PLANTED WETLAND AREA DETAIL
N.T.S.

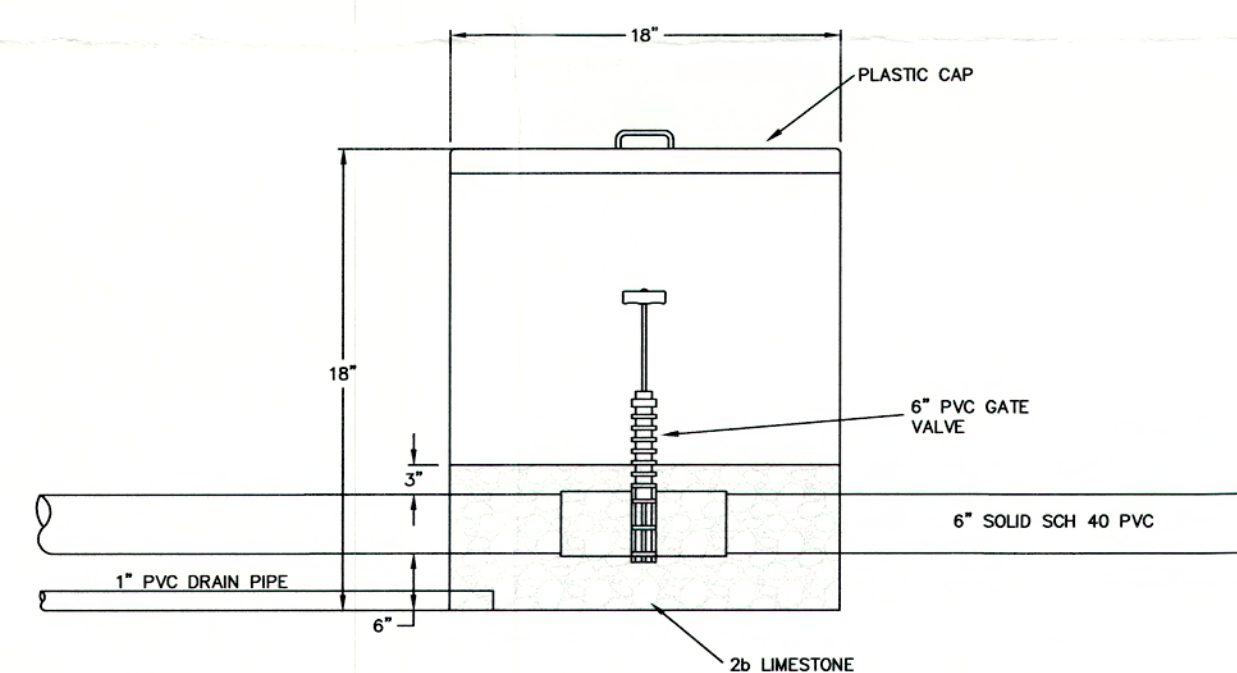

VALVE BOX & LID DETAIL
N.T.S.

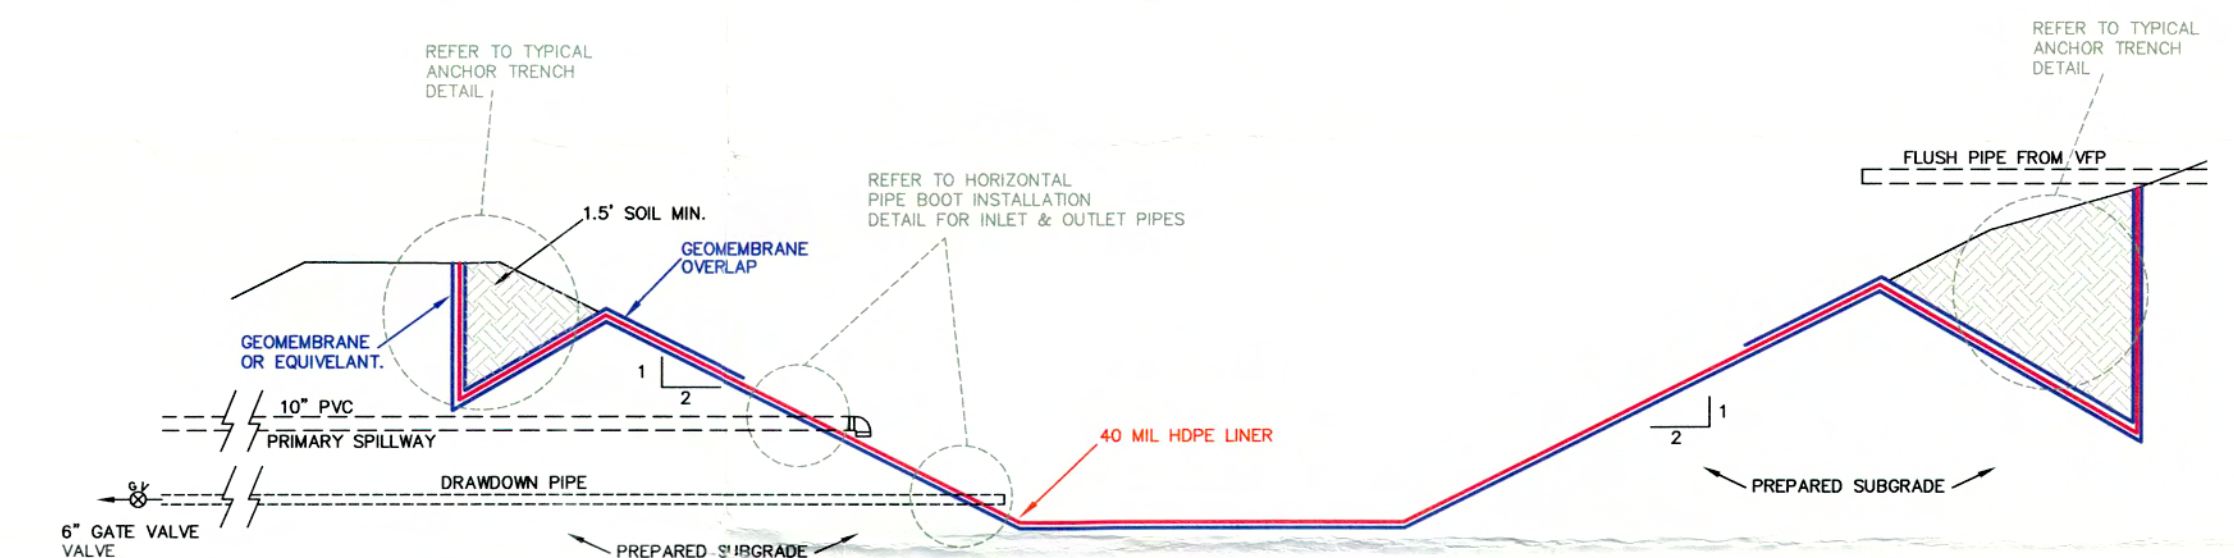

TYPICAL POLISHING POND CROSS SECTION
N.T.S.

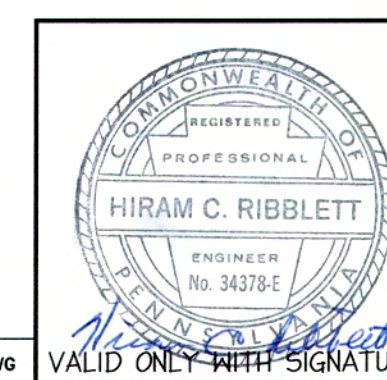


EXHIBIT III - PASSIVE TREATMENT SYSTEM DETAILS - AS-BUILT

WELLS CREEK WATERSHED ASSOCIATION

ADAMS STATION DISCHARGES #7

SOMERSET TOWNSHIP, SOMERSET COUNTY

SCALE: NONE DATE: February 26, 2004

Earthtech, Inc.
336 Bloomfield Street, Suite 201 Johnstown, PA 15904
Telephone: (814) 266-6402 Fax: (814) 266-6530
www.scientificengineers.com

NO.	DATE	DESCRIPTION	BY