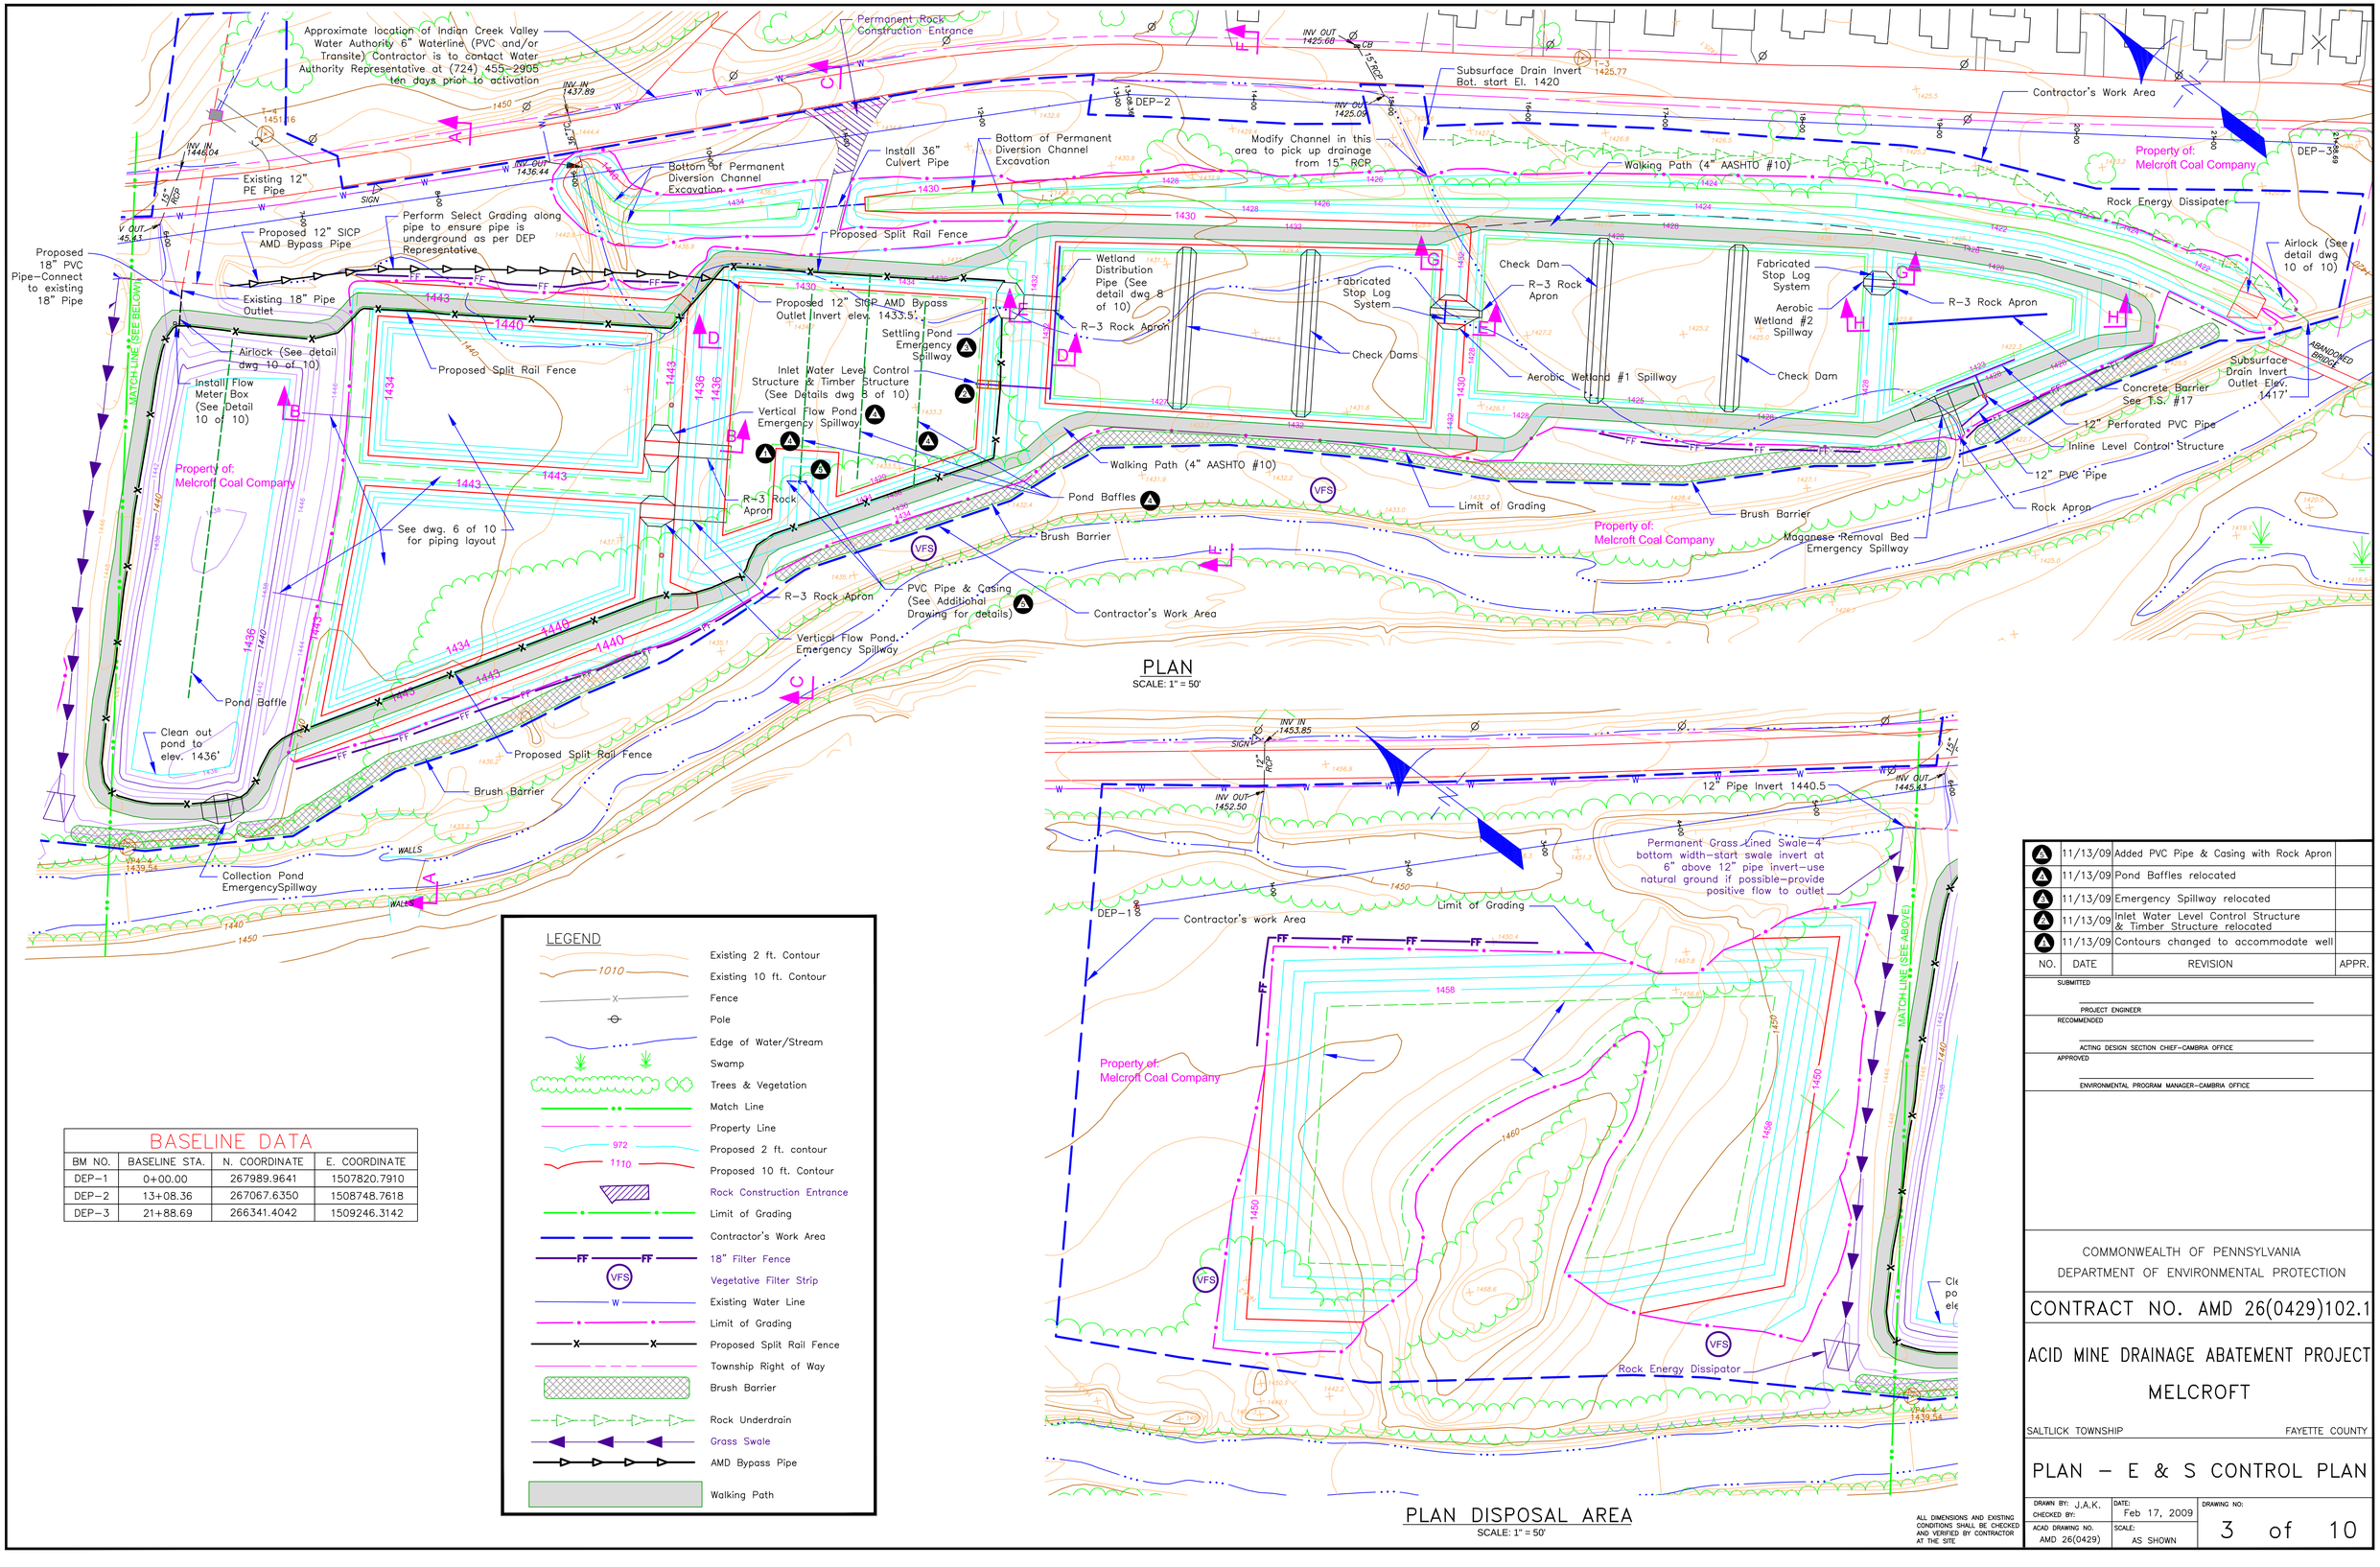

PLAN
SCALE: 1" = 50'

PLAN DISPOSAL AREA
SCALE: 1" = 50'

LEGEND

- Existing 2 ft. Contour
- Existing 10 ft. Contour
- Fence
- Pole
- Edge of Water/Stream
- Swamp
- Trees & Vegetation
- Match Line
- Property Line
- Proposed 2 ft. contour
- Proposed 10 ft. Contour
- Rock Construction Entrance
- Limit of Grading
- Contractor's Work Area
- 18" Filter Fence
- Vegetative Filter Strip
- Existing Water Line
- Limit of Grading
- Proposed Split Rail Fence
- Township Right of Way
- Brush Barrier
- Rock Underdrain
- Grass Swale
- AMD Bypass Pipe
- Walking Path

BASELINE DATA

BM NO.	BASELINE STA.	N. COORDINATE	E. COORDINATE
DEP-1	0+00.00	267989.9641	1507820.7910
DEP-2	13+08.36	267067.6350	1508748.7618
DEP-3	21+88.69	266341.4042	1509246.3142

NO.	DATE	REVISION	APPR.
5	11/13/09	Added PVC Pipe & Casing with Rock Apron	
4	11/13/09	Pond Baffles relocated	
3	11/13/09	Emergency Spillway relocated	
2	11/13/09	Inlet Water Level Control Structure & Timber Structure relocated	
1	11/13/09	Contours changed to accommodate well	

SUBMITTED

PROJECT ENGINEER

RECOMMENDED

ACTING DESIGN SECTION CHIEF-CAMBRIA OFFICE

APPROVED

ENVIRONMENTAL PROGRAM MANAGER-CAMBRIA OFFICE

COMMONWEALTH OF PENNSYLVANIA
DEPARTMENT OF ENVIRONMENTAL PROTECTION

CONTRACT NO. AMD 26(0429)102.1

ACID MINE DRAINAGE ABATEMENT PROJECT
MELCROFT

SALTLICK TOWNSHIP — FAYETTE COUNTY

PLAN – E & S CONTROL PLAN

DRAWN BY: J.A.K.
CHECKED BY:
ACAD DRAWING NO. AMD 26(0429)
DATE: Feb 17, 2009
SCALE: AS SHOWN
DRAWING NO: 3 of 10

ALL DIMENSIONS AND EXISTING CONDITIONS SHALL BE CHECKED AND VERIFIED BY CONTRACTOR AT THE SITE