



PLACE  
GEOSYNTHETIC  
CLAY LINER (GCL)  
LINER ON POND  
BOTTOM AND SIDES  
TO TOP POND

FRENCH DRAIN  
(BY OTHERS)

MILLER RUN

- # - FLOW AND WATER CHEMISTRY SAMPLING POINTS
- 1 - RAW AMD (COMBINED SOURCES) IN ROCK-LINED CHANNEL INTO LIMESTONE POND
  - 2 - FINAL OUTFALL FROM WATER LEVEL CONTROL STRUCTURE/FRENCH DRAIN

CUT "NOTCH" AROUND PIPE AND PLACE  
GRANULAR BENTONITE. INSTALL GRANULAR  
BENTONITE AND SECONDARY COLLAR AROUND  
PIPE

REMOVE AND REPLACE EXSITING 8" SOILD/  
PERF. PVC PIPE (CONNECT TO EXISTING  
PIPE WITH FERNCO-TYPE COUPLER)

"SKETCH PLAN"  
MILLER RUN #1 SYSTEM LEAK REPAIR  
Notes in red by BioMost, Inc., 6/5/14

NOTE:  
ENGINEERING DESIGN PLAN SHOWN WAS PREPARED BY  
NATURAL RESOURCES CONSERVATION SERVICE (NRCS) AND  
PROVIDED BY HUNTINGDON COUNTY CONSERVATION DISTRICT.


REPLACE LIMESTONE TO  
ORIGINAL CONDITION UPON  
COMPLETION

REMOVE ~400 TONS  
LIMESTONE AND  
TEMPORARILY STOCKPILE

OVER EXCAVATE POND  
BOTTOM AND SIDES 1',  
TEMPORARILY STOCKPILE,  
REPLACE 1' ON TOP OF GCL

INSTALL 6" OR 8" PVC PIPE OR  
WEIR TO PROVIDE FLOW  
MEASUREMENT LOCATION

REMOVE RIPRAP,  
OVEREXCAVATE 1' OF  
SOIL, PLACE GCL,  
REPLACE 1' SOIL AND  
RIPRAP TO ORIGINAL  
CONDITION

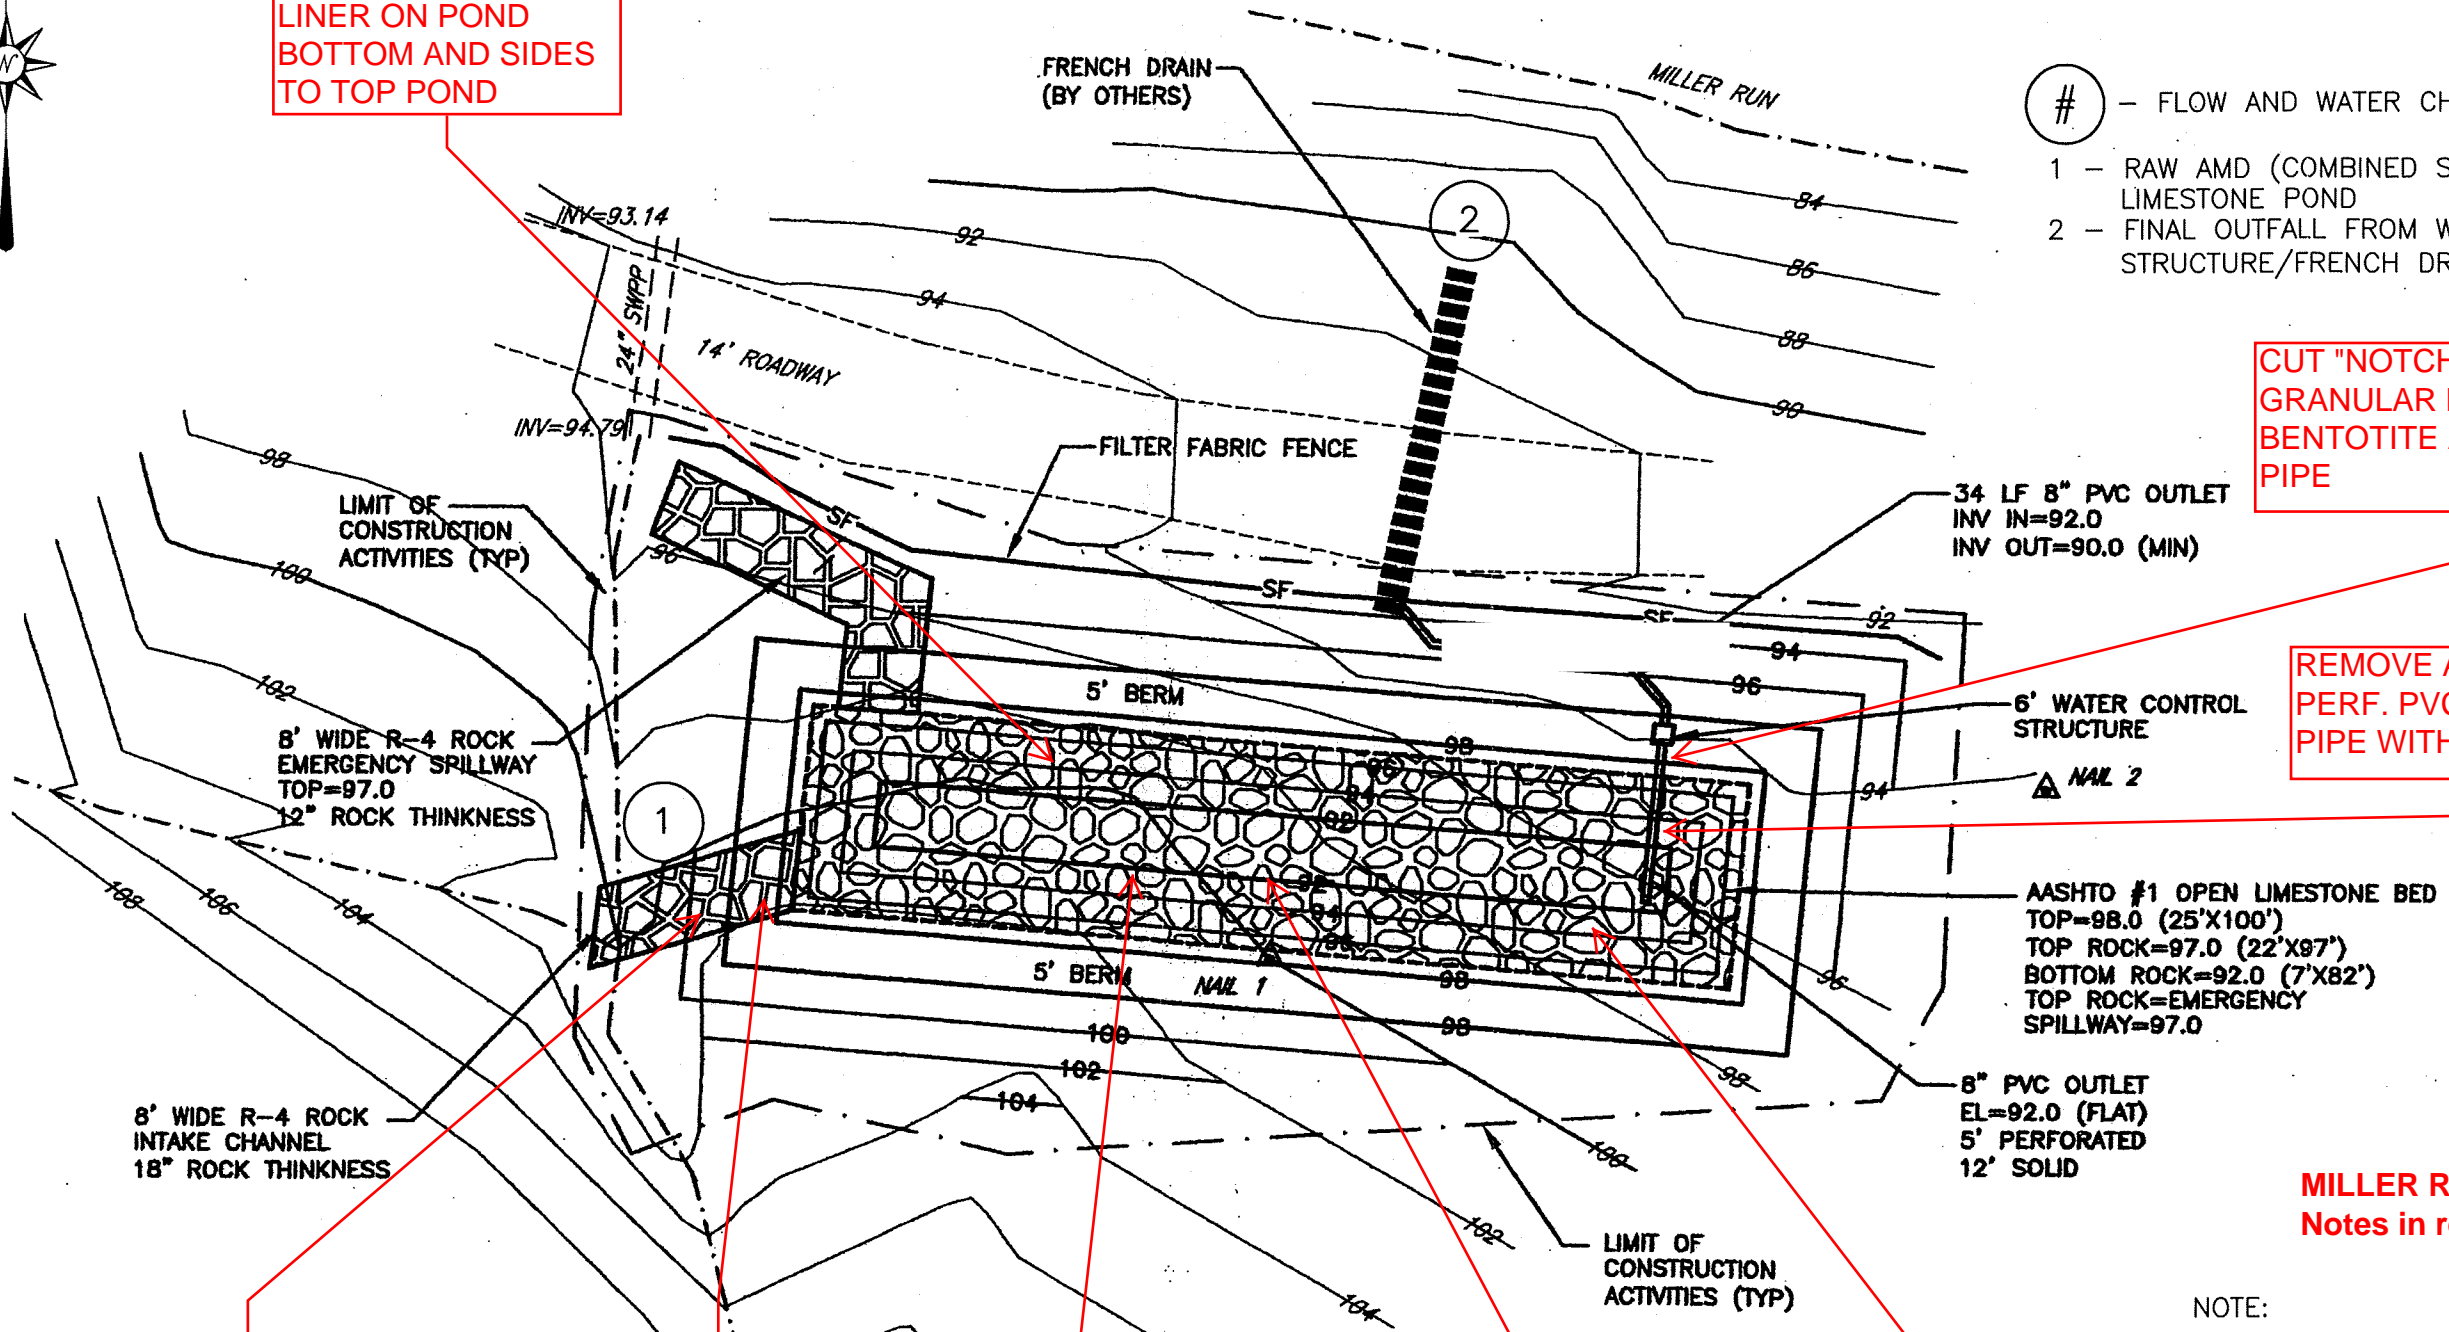

SKELLY and LOY Inc. ENGINEERS-ENVIRONMENTAL CONSULTANTS	06/22/11	FIGURE 4
OM&R SCHEMATIC PLAN MILLER RUN #1 AMD REMEDIATION SYSTEM CARBON TOWNSHIP HUNTINGDON COUNTY, PA PREPARED FOR: HUNTINGDON COUNTY CONSERVATION DISTRICT		
R10-0471.001	SCALE: 1" = 20'	