


Hubler Run Phase 1 (PA-160)

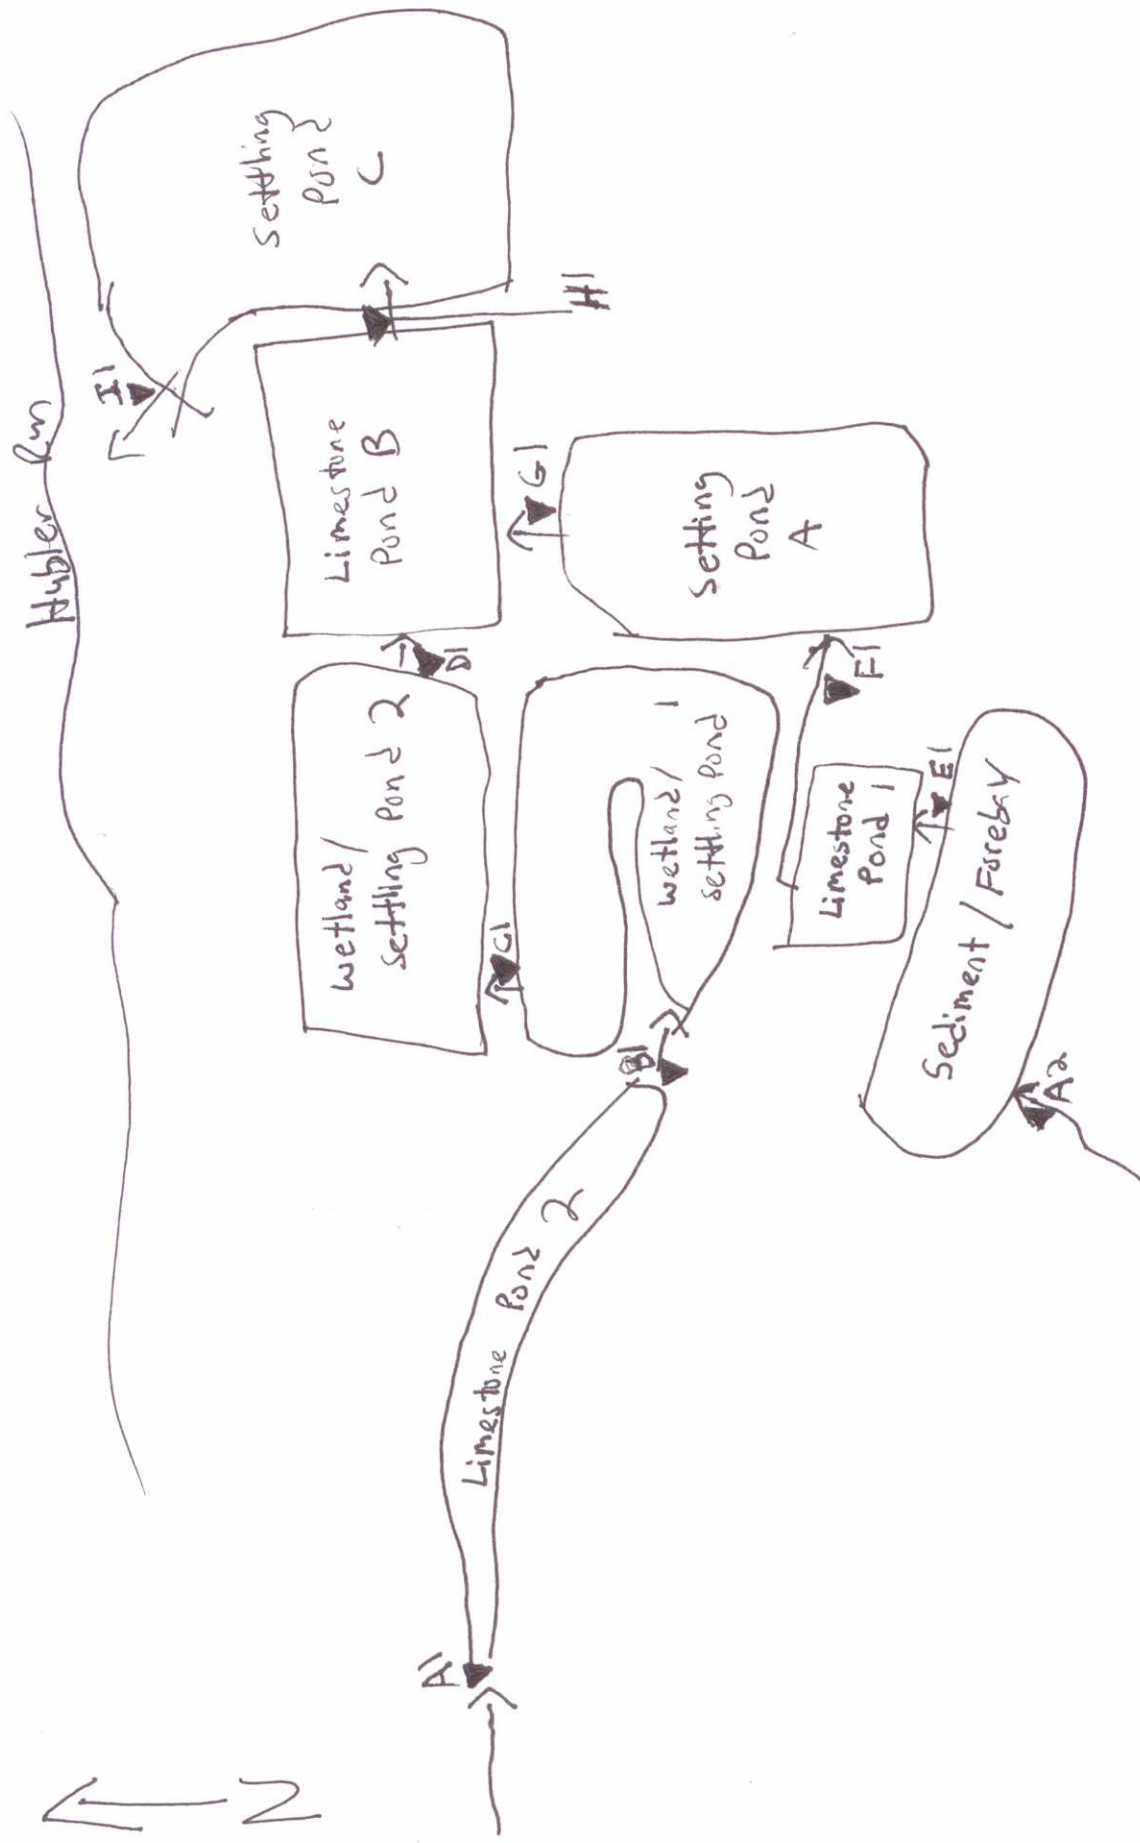

Note this is an interpretation of sampling point locations based on descriptions and GPS values