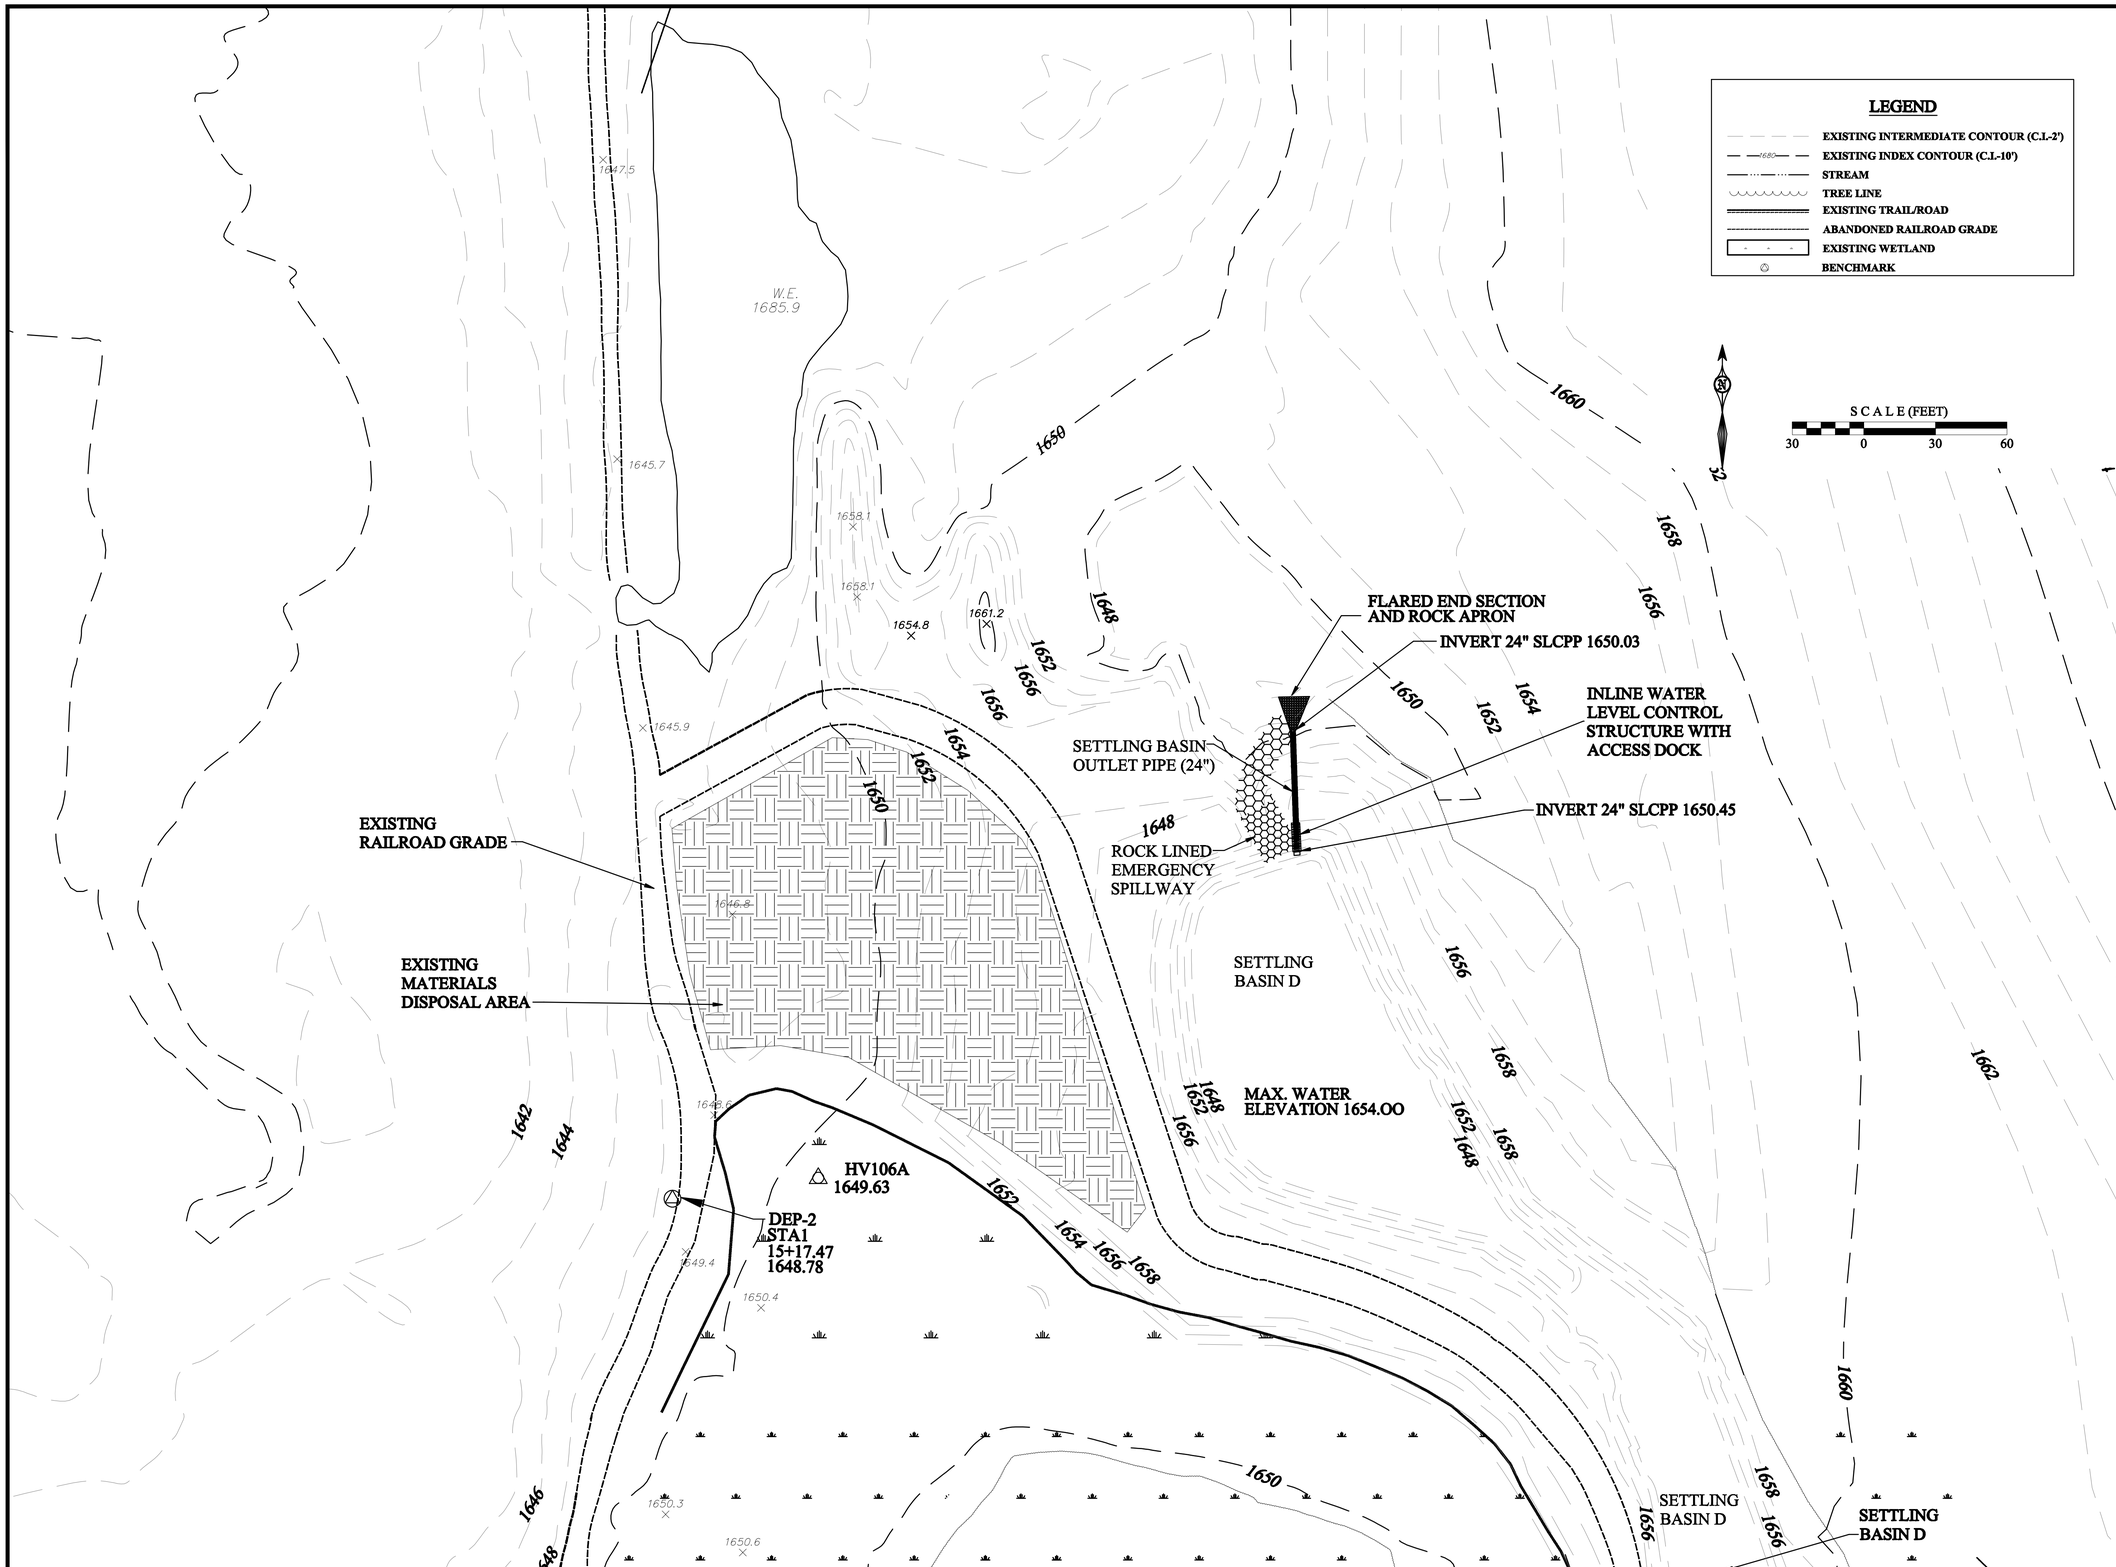


SHEET NO. AB-1

1 OF 2

SEAL: COMMONWEALTH OF PENNSYLVANIA REGISTERED PROFESSIONAL ENGINEER MICHELLE M. MERROW 065677

Michelle M. Merrow PE065677

REVISIONS

| NO. | DESCRIPTION | DATE |
|---|---|---|
| | | |

THE INFORMATION CONATAINED HERESON MAY NOT BE USED OR COPIED WITHOUT WRITTEN PERMISSION OF THE BEGENING ENGINEER.

PREPARED BY:

ALDER RUN ENGINEERING
107 COAL STREET
OSCEOLA MILLS, PENNSYLVANIA 16666
PHONE: (814) 339-6998

DATE: SEPTEMBER 12, 2013

SCALE: 1" = 30'

PROJECT:

MORGAN RUN 7
AMD TREATMENT SYSTEM
AS BUILT

DECATUR TOWNSHIP, CLEARFIELD COUNTY, PA

TITLE: AS BUILT

PREPARED FOR:

New Miles of Blue Stream NMBS
1602 OREBED ROAD
MANSFIELD, PENNSYLVANIA 16933
PHONE: (570)-662-8631