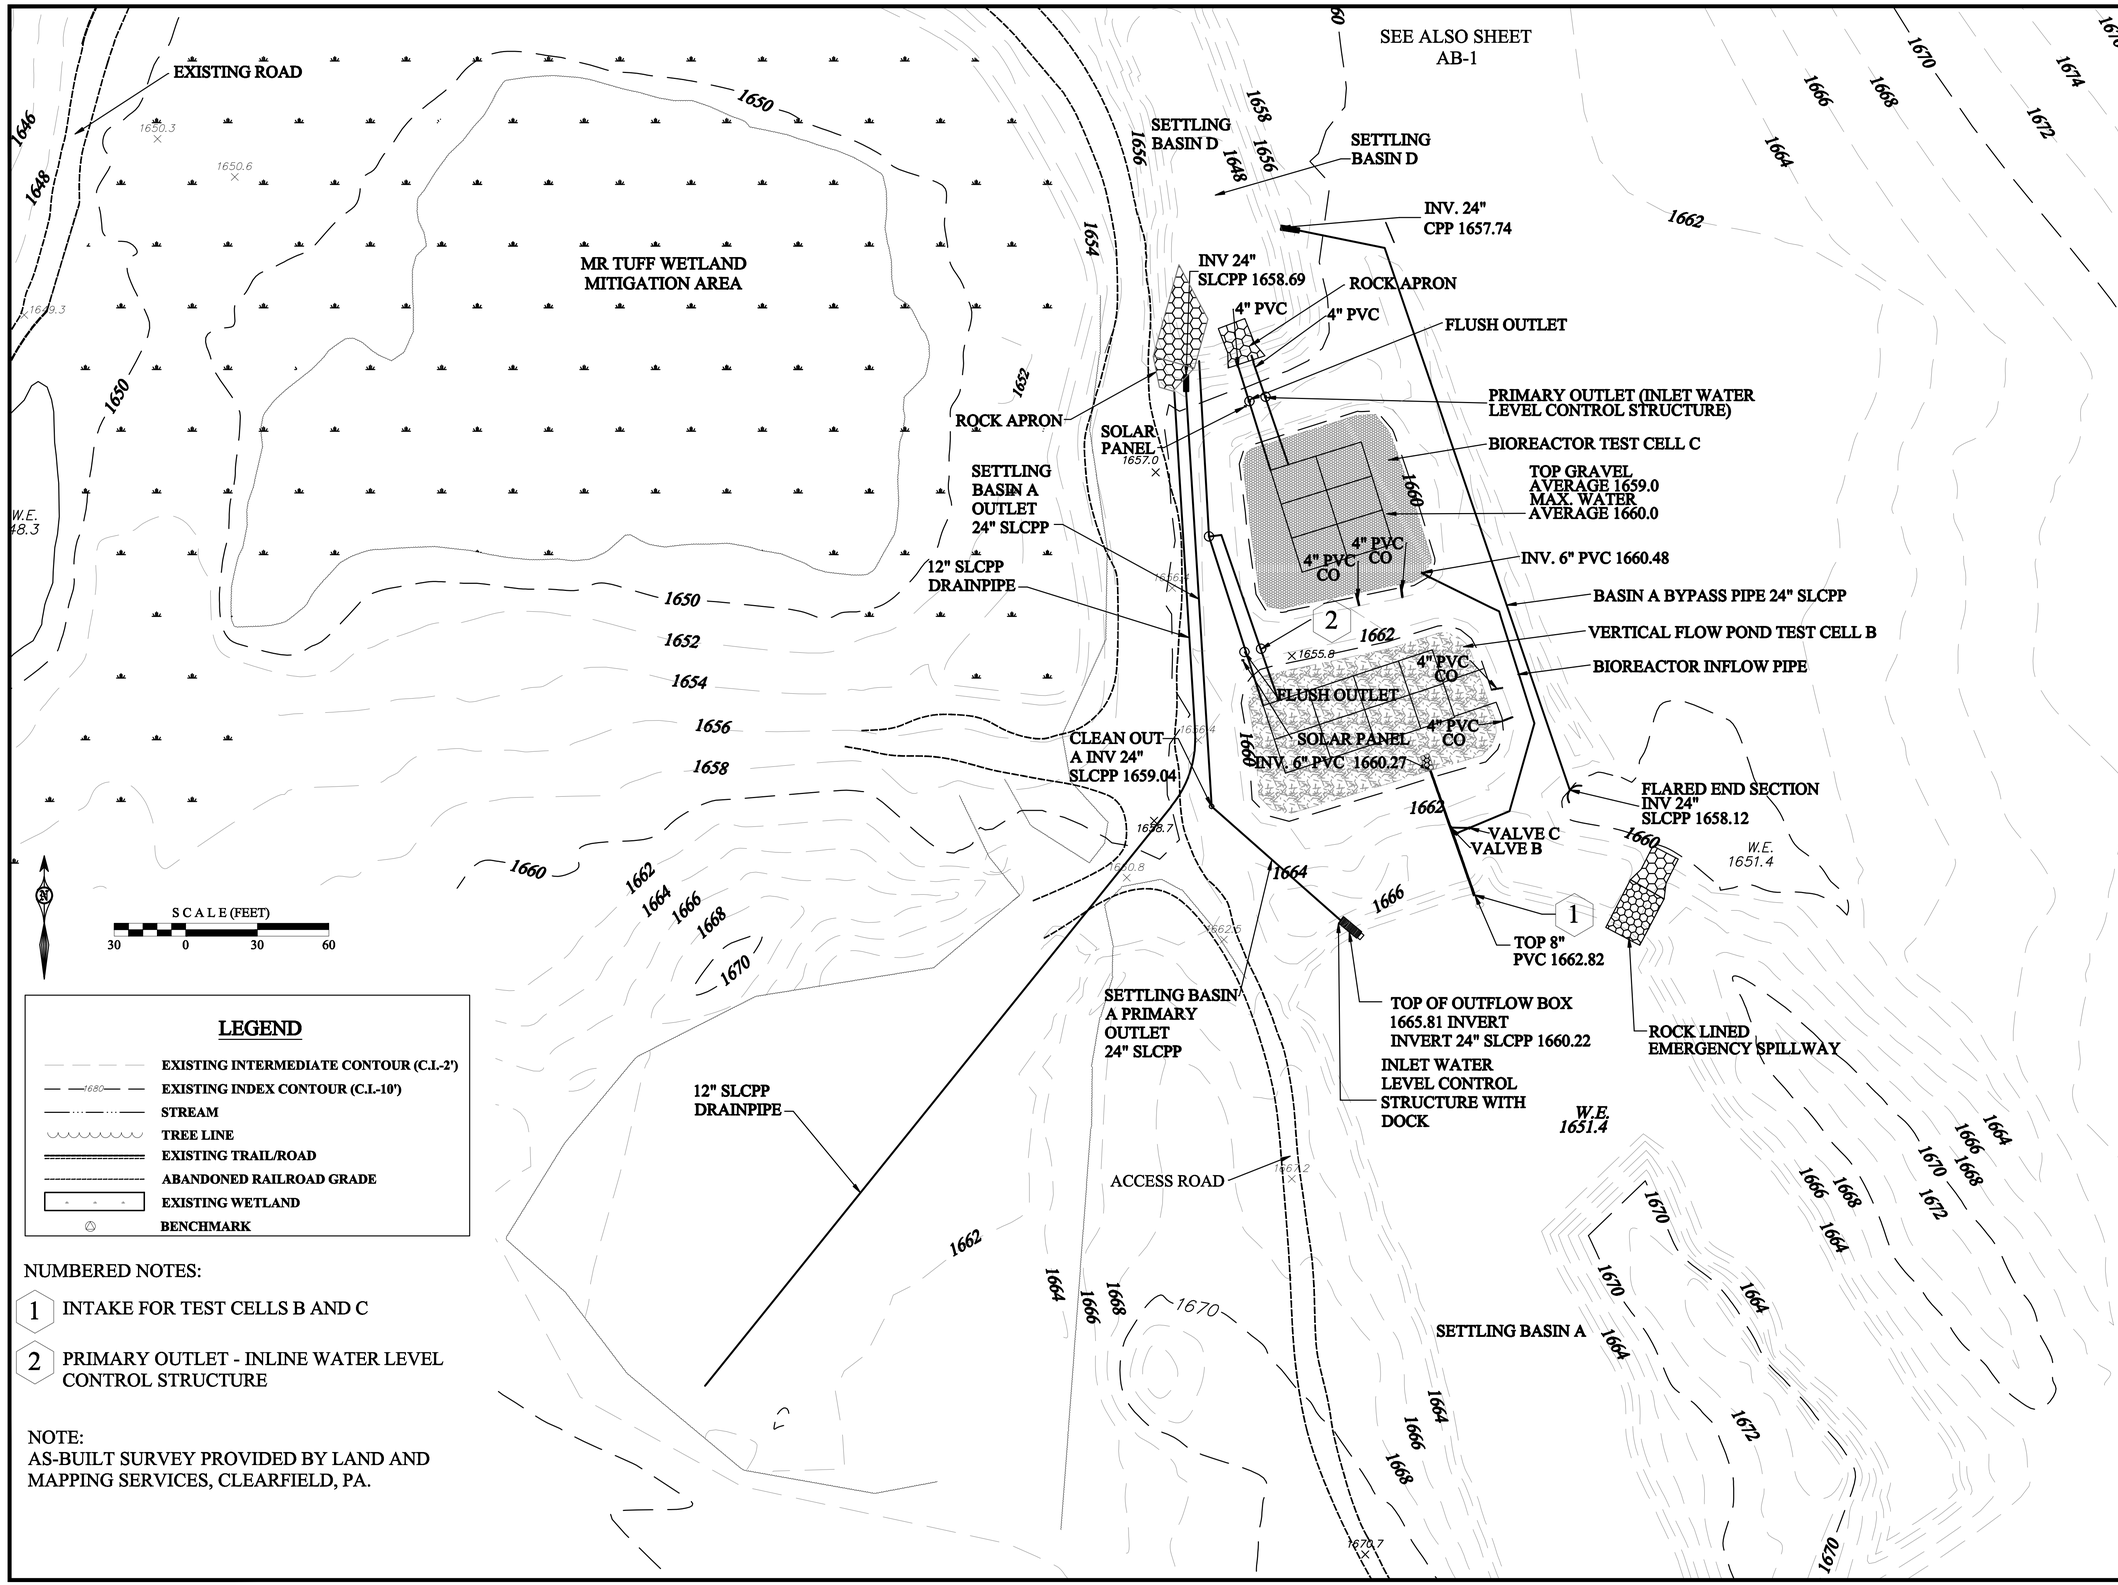


NUMBERED NOTES:

1. INTAKE FOR TEST CELLS B AND C
2. PRIMARY OUTLET - INLINE WATER LEVEL CONTROL STRUCTURE

NOTE:
AS-BUILT SURVEY PROVIDED BY LAND AND MAPPING SERVICES, CLEARFIELD, PA.

SHEET NO. AB-2 2 OF 2

SEAL: COMMONWEALTH OF PENNSYLVANIA REGISTERED PROFESSIONAL ENGINEER MICHELLE M. MERROW PE 060677

Michelle M. Merrow PE060677

REVISIONS

| NO. | DESCRIPTION | DATE |
|---|---|---|
| 1 | ADD DRAINPIPE | 6/26/14 |

THE INFORMATION CONTAINED HEREON MAY NOT BE USED OR COPIED WITHOUT WRITTEN PERMISSION OF THE ENGINEERING ENGINEER.

PREPARED BY:
ALDER RUN ENGINEERING
107 COAL STREET
OSCEOLA MILLS, PENNSYLVANIA 16666
PHONE: (814) 339-6998

DATE: SEPTEMBER 12, 2013

SCALE: 1" = 30'

PROJECT:
MORGAN RUN 7
AMD TREATMENT SYSTEM
AS BUILT
DECATUR TOWNSHIP, CLEARFIELD COUNTY, PA

TITLE: AS BUILT

PREPARED FOR:
New Miles of Blue Stream NMBS
1602 OREBED ROAD
MANSFIELD, PENNSYLVANIA 16933
PHONE: (570)-662-8631