








ARNOT #2 DISCHARGE #4
AMD TREATMENT SYSTEM

PROS 1D 230



-  Water sampling/flow measurement point
 -  Flush control box
 -  Valve
 -  Surface water flow
 -  Underground water flow
 -  Flushing path
- Scale: 1" = 100'

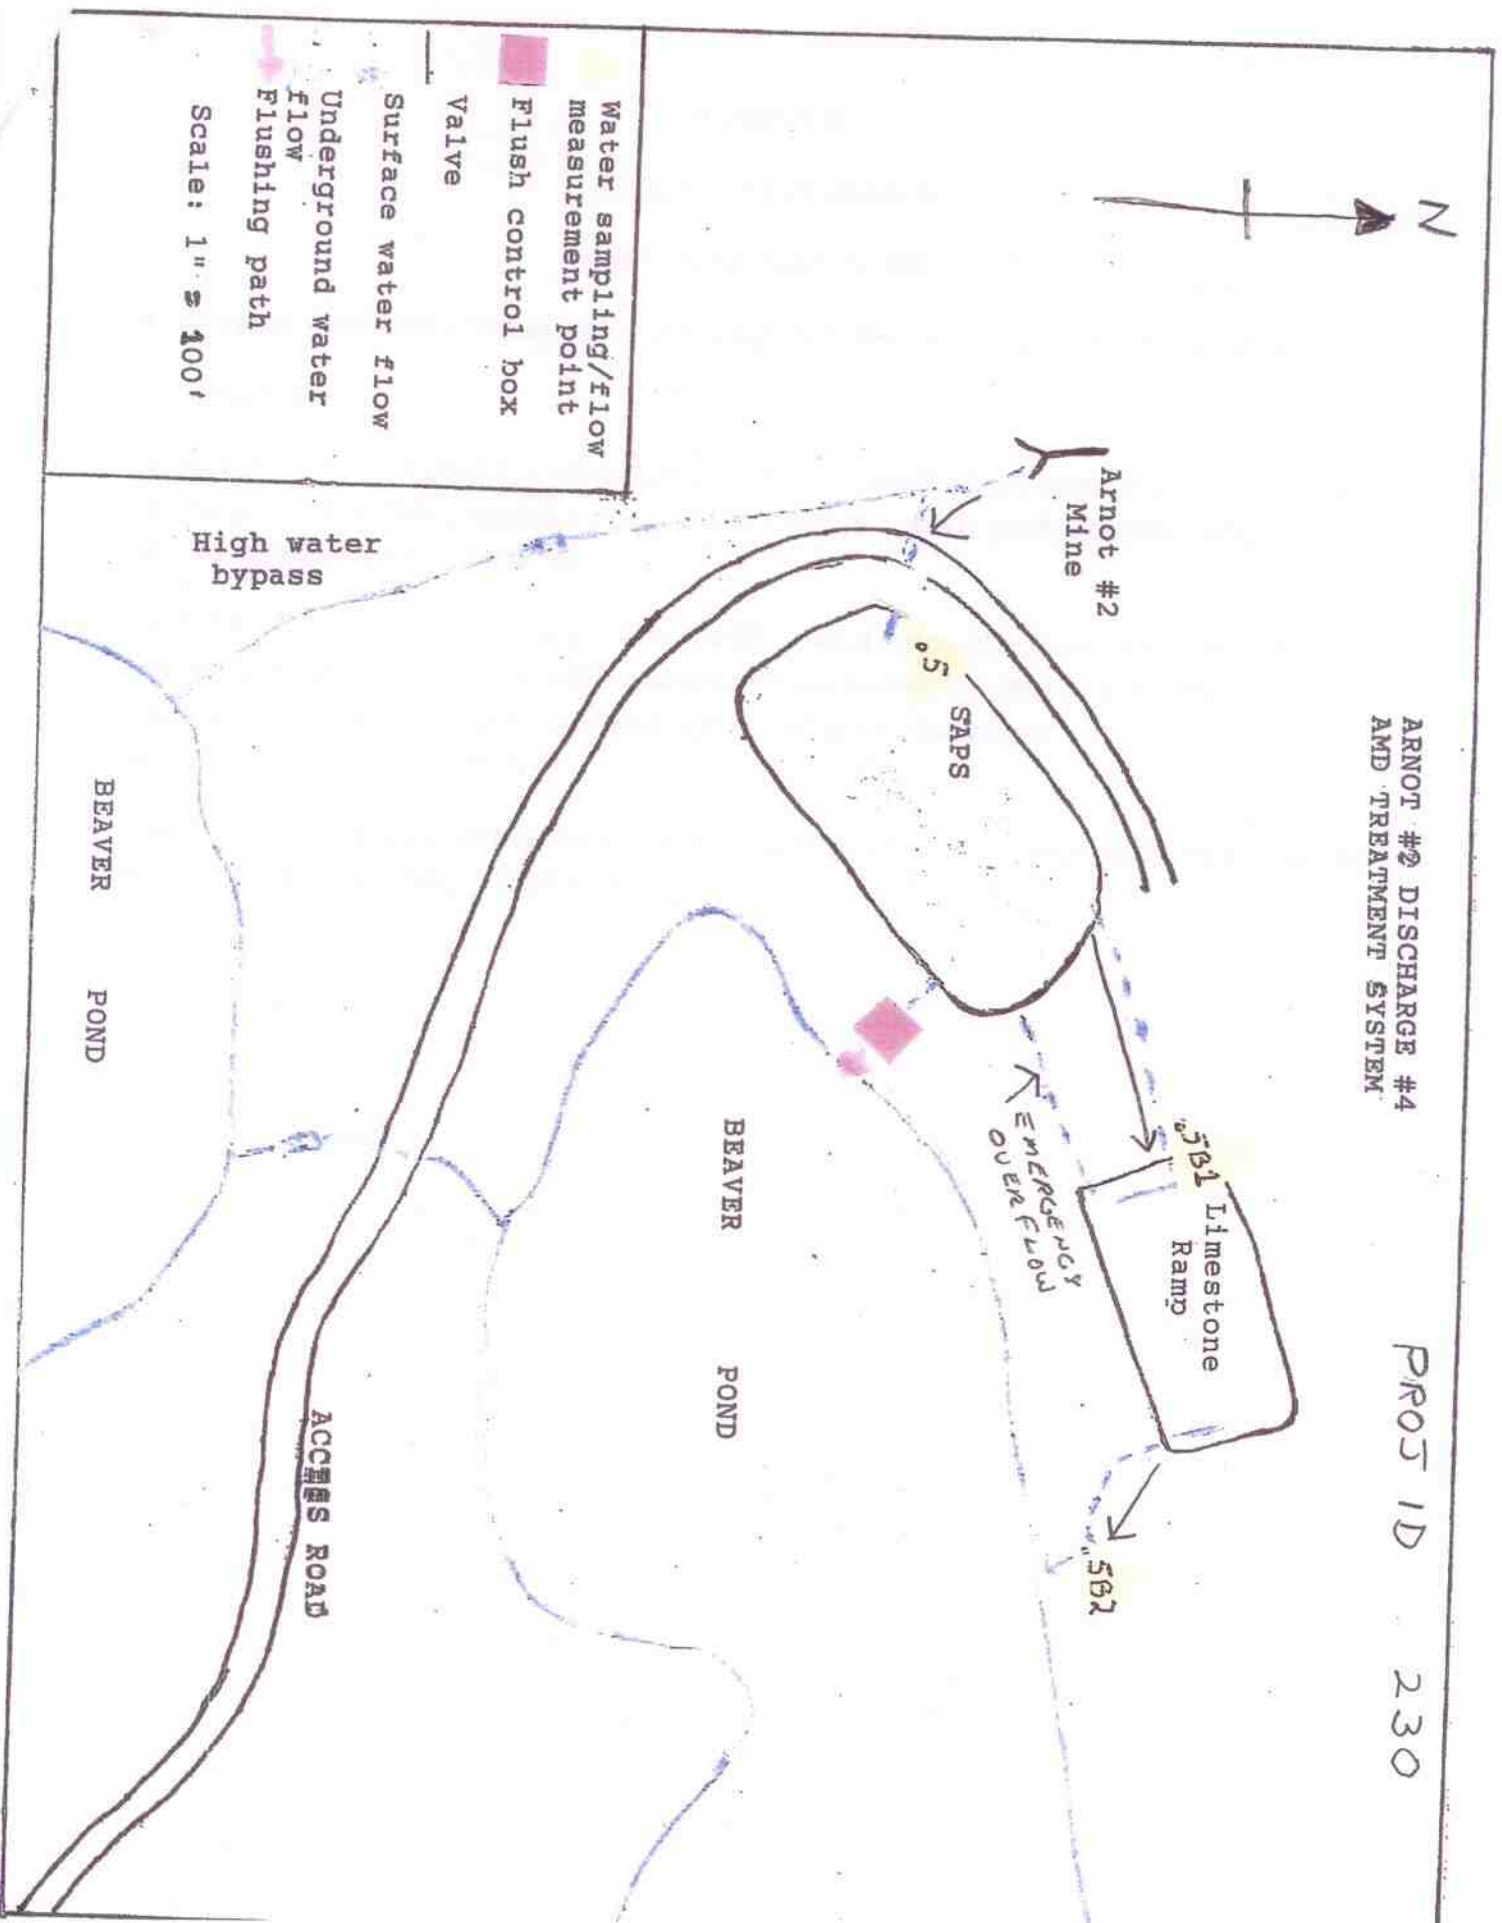

BEAVER POND

BEAVER POND

ACCESS ROAD

High water bypass

Arnot #2 Mine

SAPS

561 Limestone Ramp

EMERGENCY OVERFLOW

562