


PROJ ID 92

BEAR RUN
LARGE SYSTEM

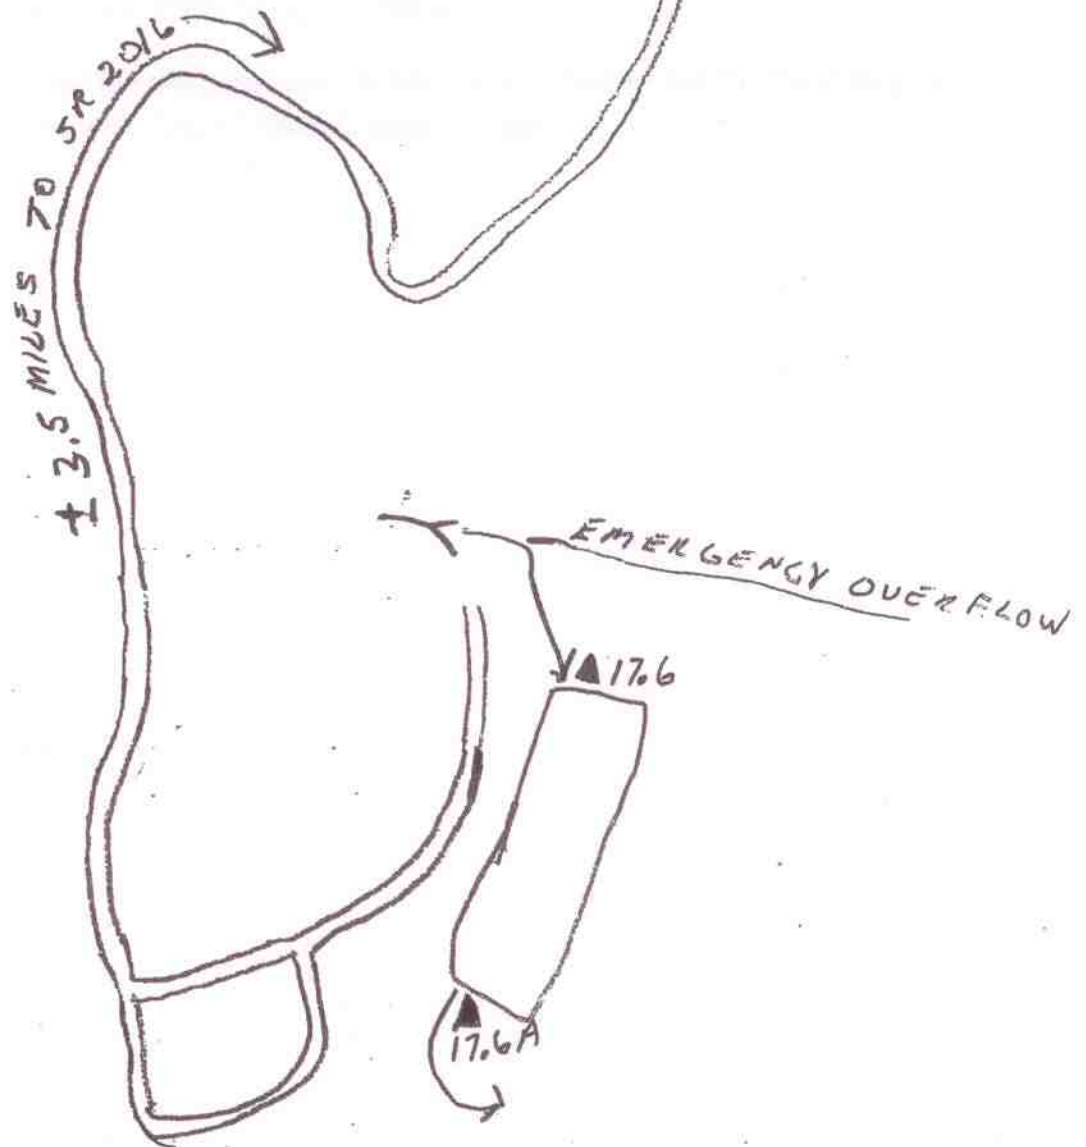

▲ MONITORING POINTS
MARKED WITH METAL SIGN