


BEAR ROCK




SYSTEM 1

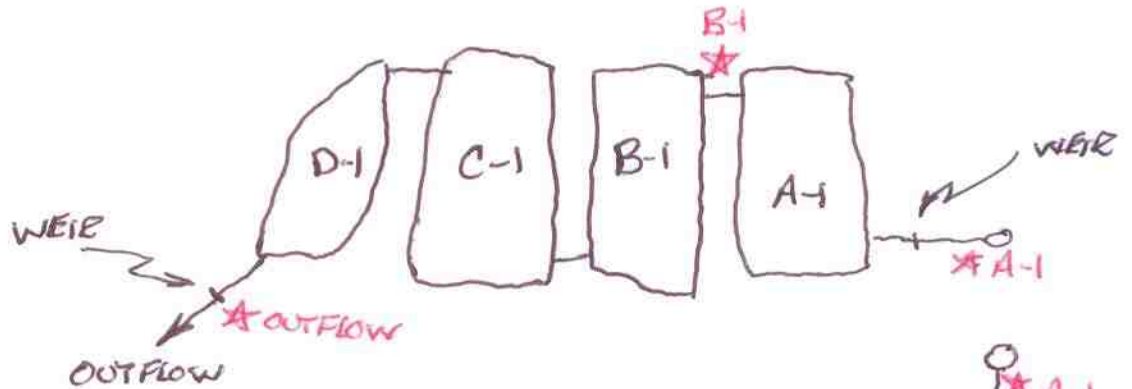

★ SAMPLE POINT

SYSTEM 2

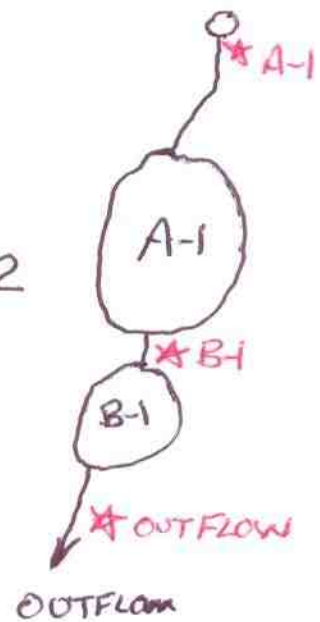

N 40° 25' 8.4"
W 78° 34' 56.8"

LILLY PA TURN OF SR 53 TO MEMORIAL DR
TURNS INTO RESEVOIR RD. DIRT ROAD
ON LEFT PAST FIRST BRIDGE