


Bellwood A/B
Vertical Flow

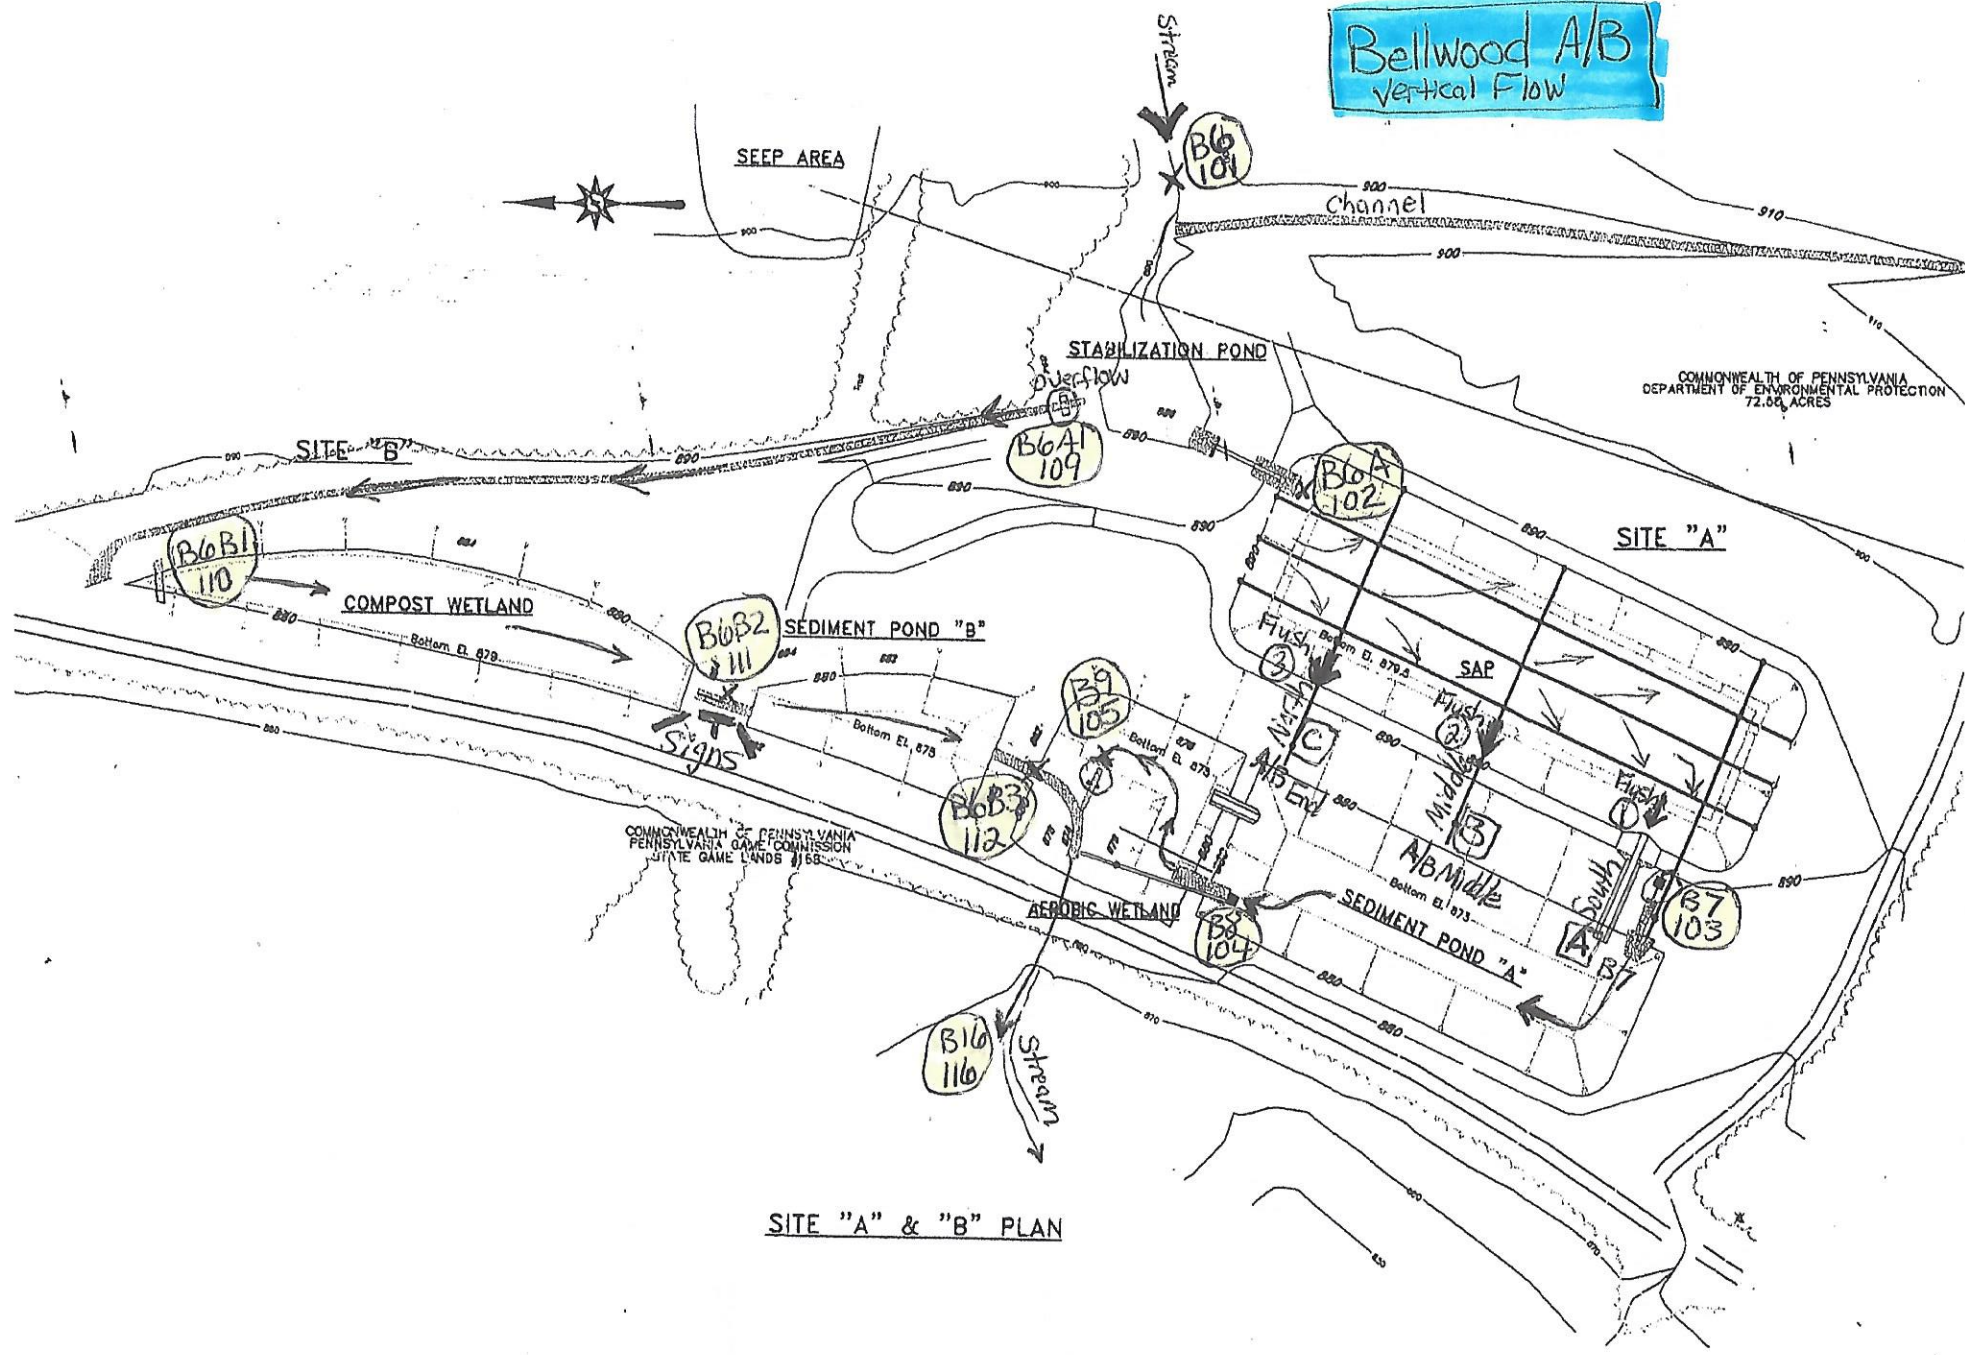

COMMONWEALTH OF PENNSYLVANIA
DEPARTMENT OF ENVIRONMENTAL PROTECTION
72.06 ACRES

COMMONWEALTH OF PENNSYLVANIA
PENNSYLVANIA GAME COMMISSION
JUNTE GAME LANDS #168

SITE "A" & "B" PLAN

BELLWOOD-A/B

Watershed: _____

Weather: _____

Date: _____

Sampler: _____

DEP ID	AWA ID	Time	ID Alias	Point Description :	Field pH:	Temp:	Cond:	Flow gpm:	Notes:
101	B6		ABRAW/STB	Raw Water Influent to Stab. Pond for Sites A/B					Stream
102	B6A		ASTB/SAP	Stabilization Pond Effluent/ Site A SAP Influent					
103	B7		ASAP/SED	Site A SAP Effluent/ Sedimentation Pond Influent					FLOW
104	B8		ASED/WET	Site A Sedimentation Pond Effluent/ Aerobic Wetland Influent					
105	B9		AWETOUT	Site A System Final Effluent From Aerobic Wetland					
109	B6A1		BSTB/OLC	Stabilization Pond Effluent/ Site B Open Limestone Channel Influent					
110	B6B1		BOLC/WET	Site B Open Limestone Channel Effluent/ Compost Wetland Influent					
111	B6B2		BWET/SED	Site B Compost Wetland Effluent/ Sedimentation Pond Influent					
112	B6B3		BSEDOUT	Site B System Final Effluent From Sedimentation Pond					
116	B16		UNTDSTR	UNT Below Sites A&B Down stream of Abandoned Railroad Grade					Stream

