


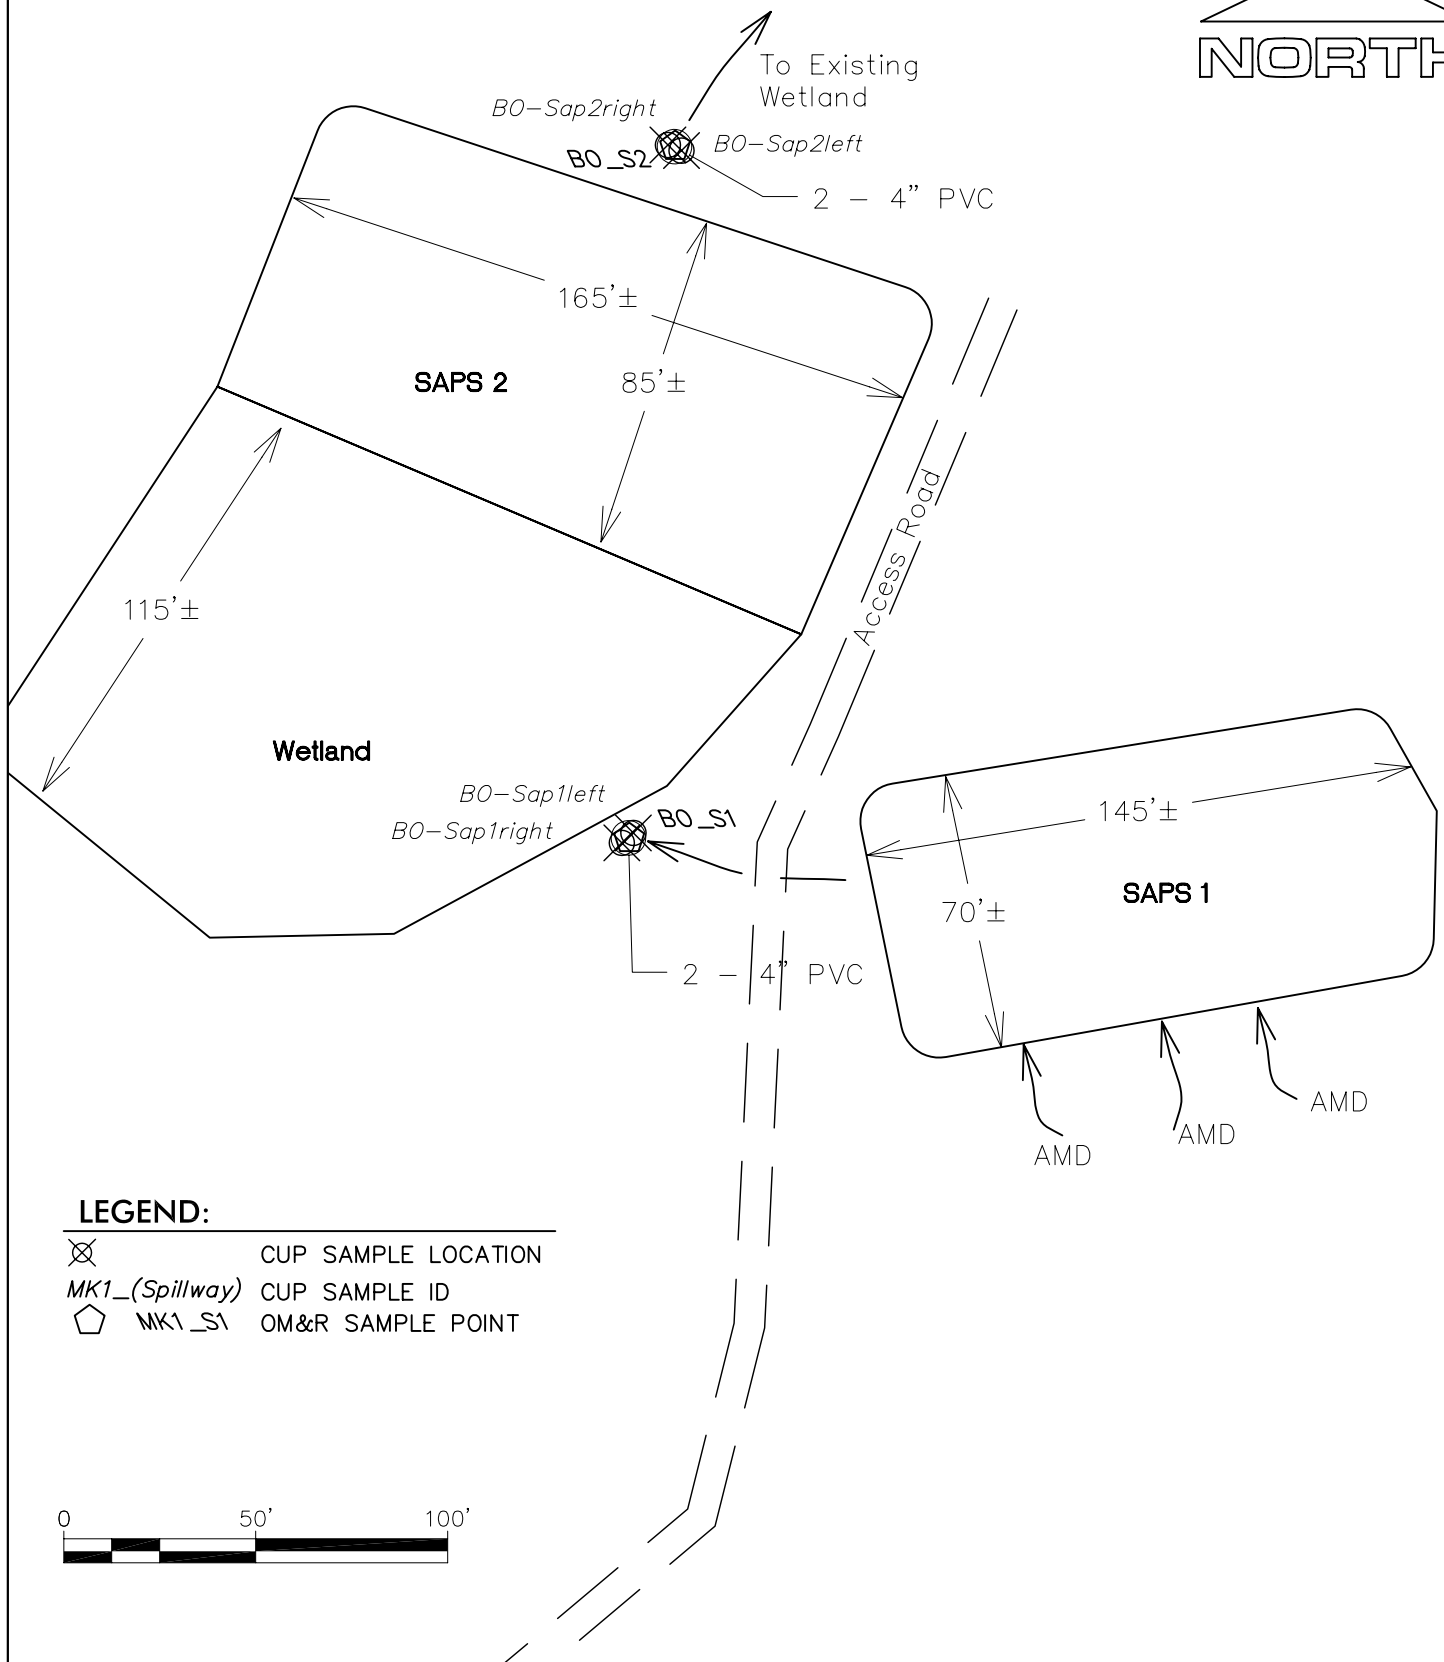

Project No.: 05-009
Drawing No.: 05-001
By: TSG 8/17/05
Chkd: JMD 9/14/05

PREPARED BY:
THE EADS GROUP, INC.
DIETZ-GOURLEY CONSULTING, LLC

Figure Bog-1
Existing Bog Treatment System
& OM&R Sample Points
Union Township Jefferson County, PA