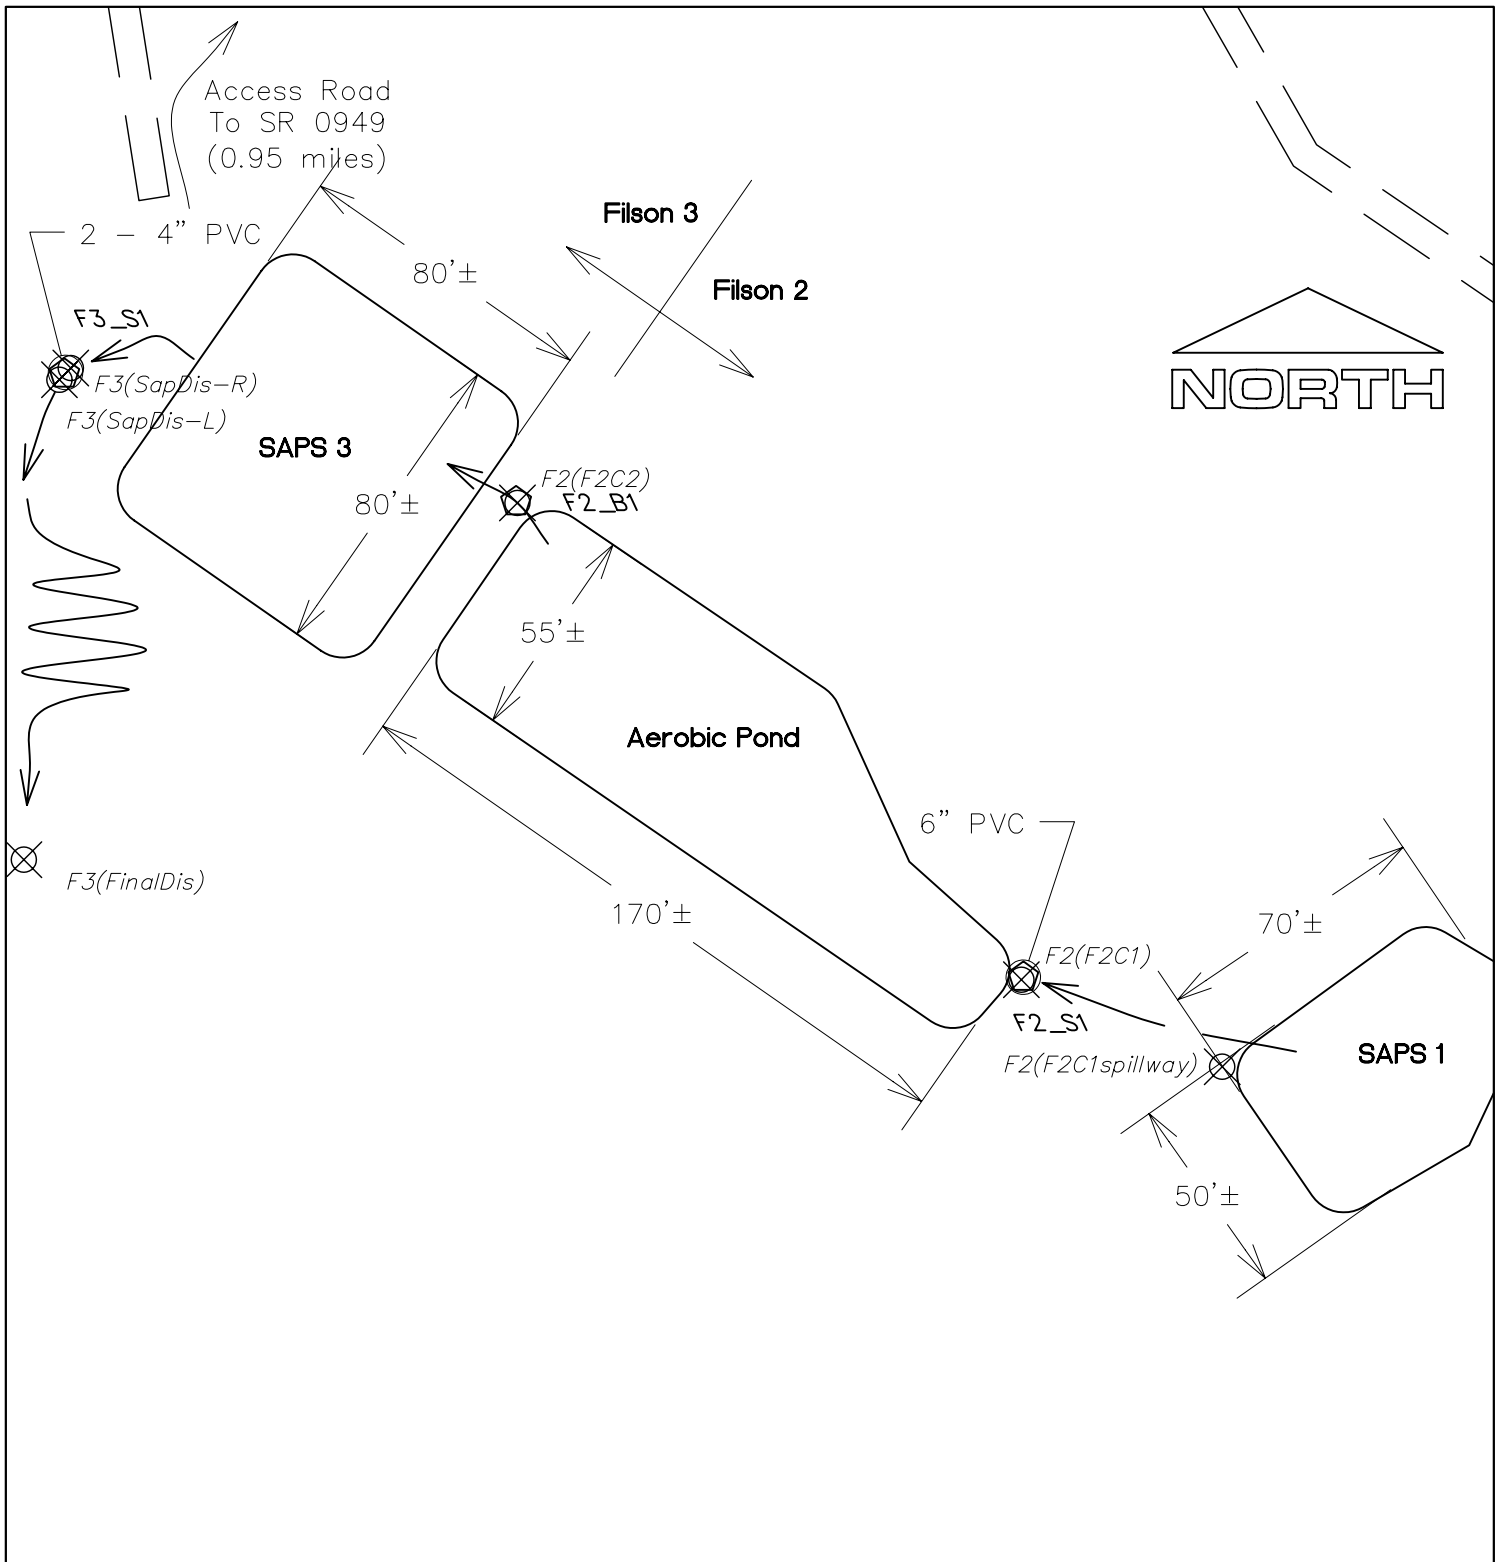


LEGEND:

- CUP SAMPLE LOCATION
- MK1_(Spillway) CUP SAMPLE ID
- MK1_S1 OM&R SAMPLE POINT

Project No.: 05-009
Drawing No.: 05-001
By: TSG 8/17/05
Chkd: JMD 9/14/05

PREPARED BY:
THE EADS GROUP, INC.
DIETZ-GOURLEY CONSULTING, LLC

Figure 1/2/3-1b

**Existing Filson 2 & 3 Treatment System
& OM&R Sample Points**

Union Township Jefferson County, PA