


Adams 7 Somerset County

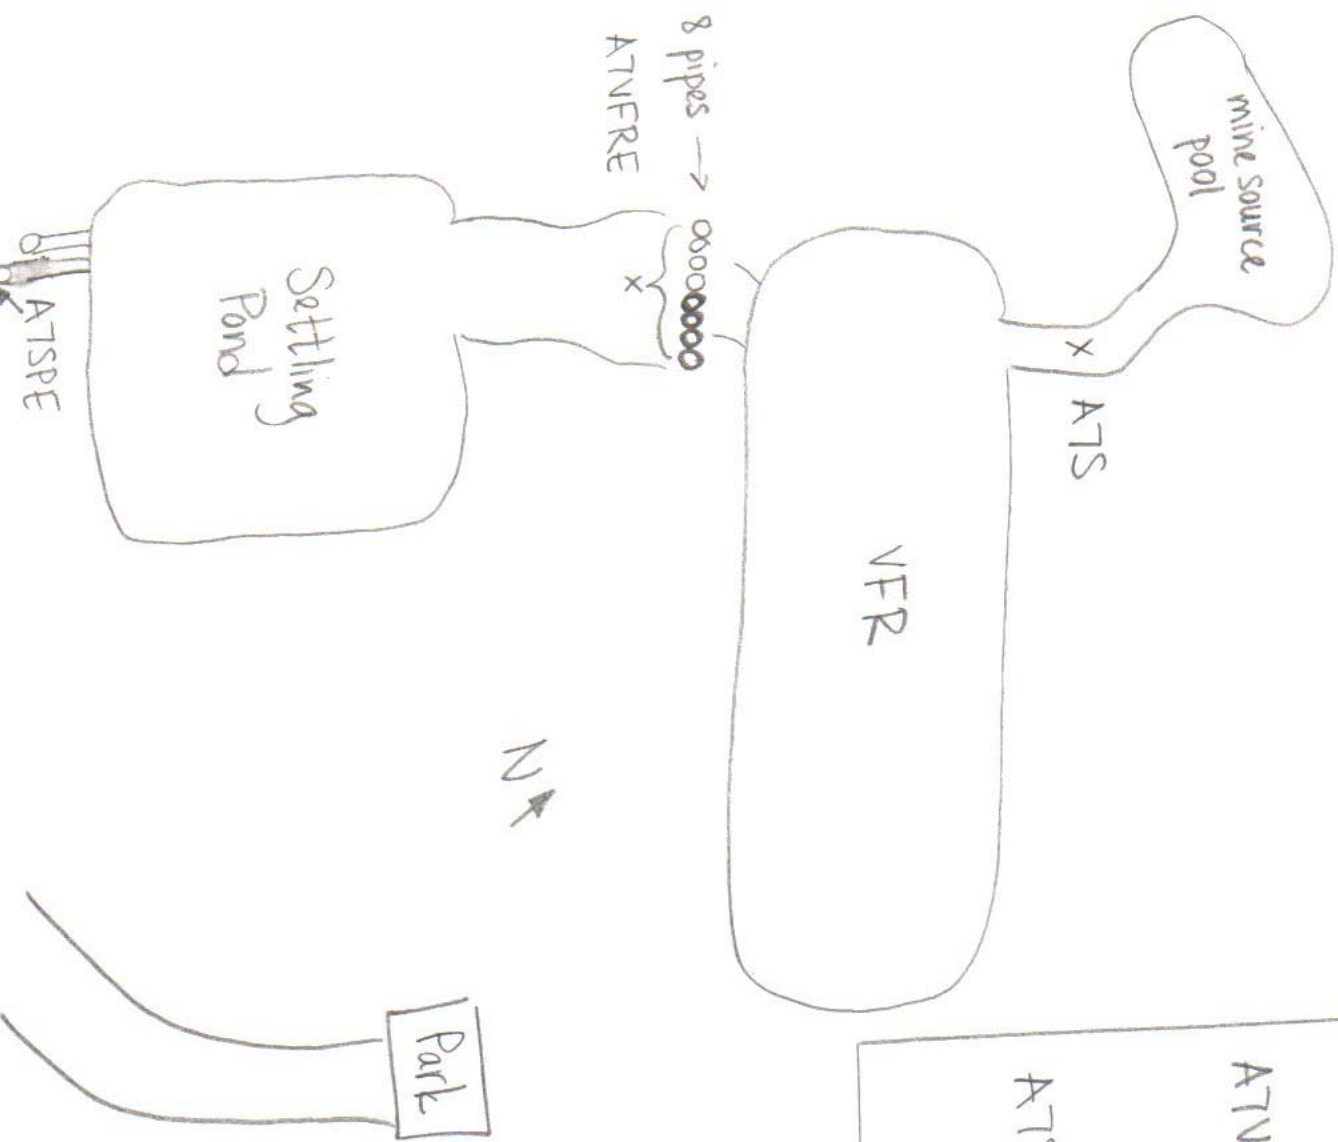

Monitoring Points

- ATS = Adams 7 Treatment System Source
40° 02' 07.2" N ; 78° 59' 29.7" W
- ATVFRE = Adams 7 Treatment System
VFR Effluent
40° 02' 06.8" N ; 78° 59' 30.3" W
- ATSPE = Adams 7 Treatment System
Settling Pond Effluent
40° 02' 11.3" N ; 78° 59' 34.5" W