


MCC
MILL CREEK

5-11-12

Glenn Site 17

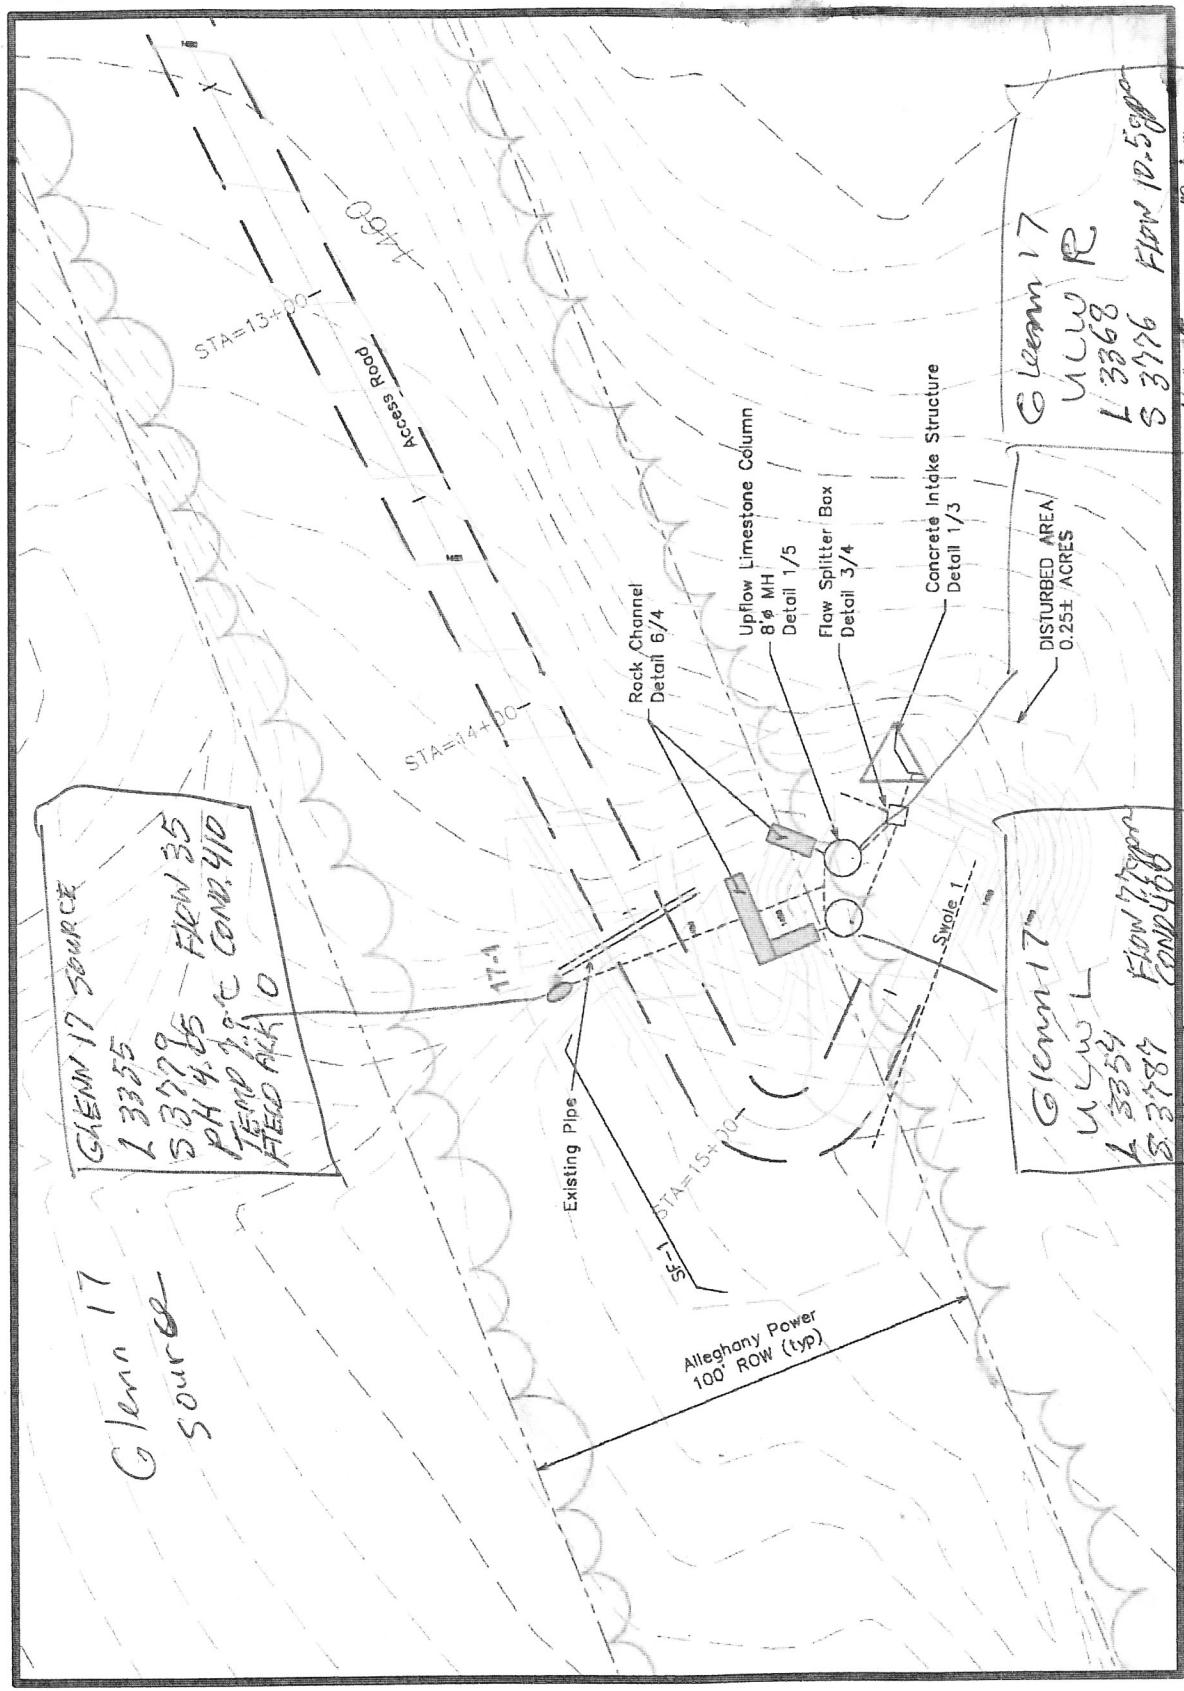

Glenn 17 SOURCE
 L 3355 FLOW 35
 S 3779 PH 4.65 COND 410
 TEMP 78°C FIELD ALK 0

Glenn 17
 SOURCE

Glenn 17
 U L W L
 L 3354 FLOW 75
 S 3784 COND 400
 PH 6.36 TEMP 78°C
 FIELD ALK 26

Glenn 17
 U L W R
 L 3368 FLOW 10.5
 S 3786 COND 38
 PH 6.39 TEMP 79°C
 FIELD ALK 92