




CORRECTED MAP  
CHANGE IN BYPASS  
FLOW PATH

PROJ ID 91

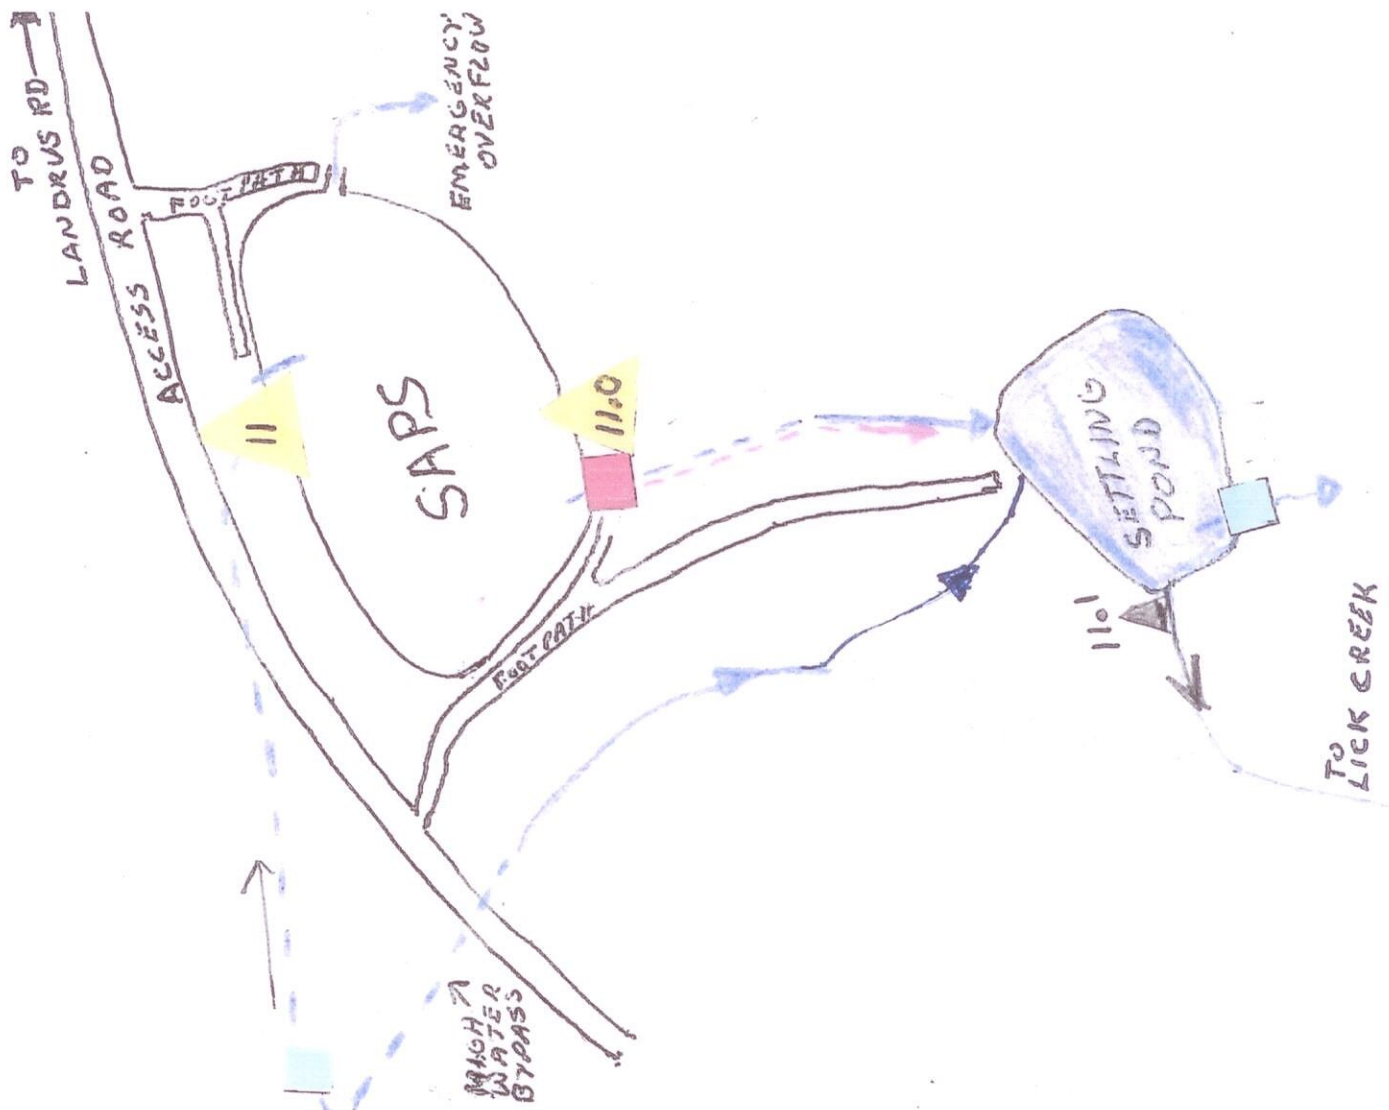

**KLONDIKE AMD TREATMENT SYSTEM**  
Bloss Twp., Tioga Co. Pennsylvania

	Water monitoring point
	Flush/Flow control box
	Valve
	Surface water flow
	Piped water flow
	Flushing path

Scale: 1 inch = 100 feet