


LAMBERT RUN

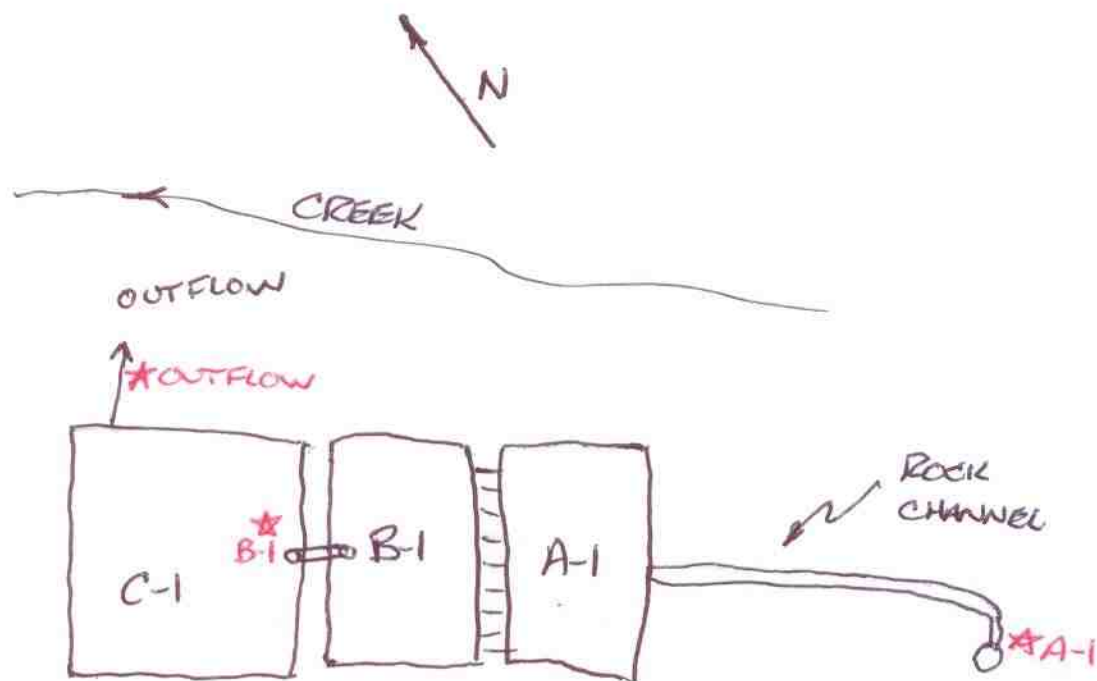

N 40° 4' 7.5"
W 78° 53' 39.1"

AT LAMBERTSVILLE TAKE CEMETERY ROAD TO STAUFFER ROAD. AFTER CROSSING 2ND BRIDGE A GRAVEL ROAD IS ON THE RIGHT. GO THRU IRON GATE ACROSS THE CREEK. GO APPROX. 250 YDS AND TAKE FIRST LANE ON LEFT. A FIELD IS ON THE RIGHT.