


LICK CREEK DIVERSION WEELS

PROJ ID 89

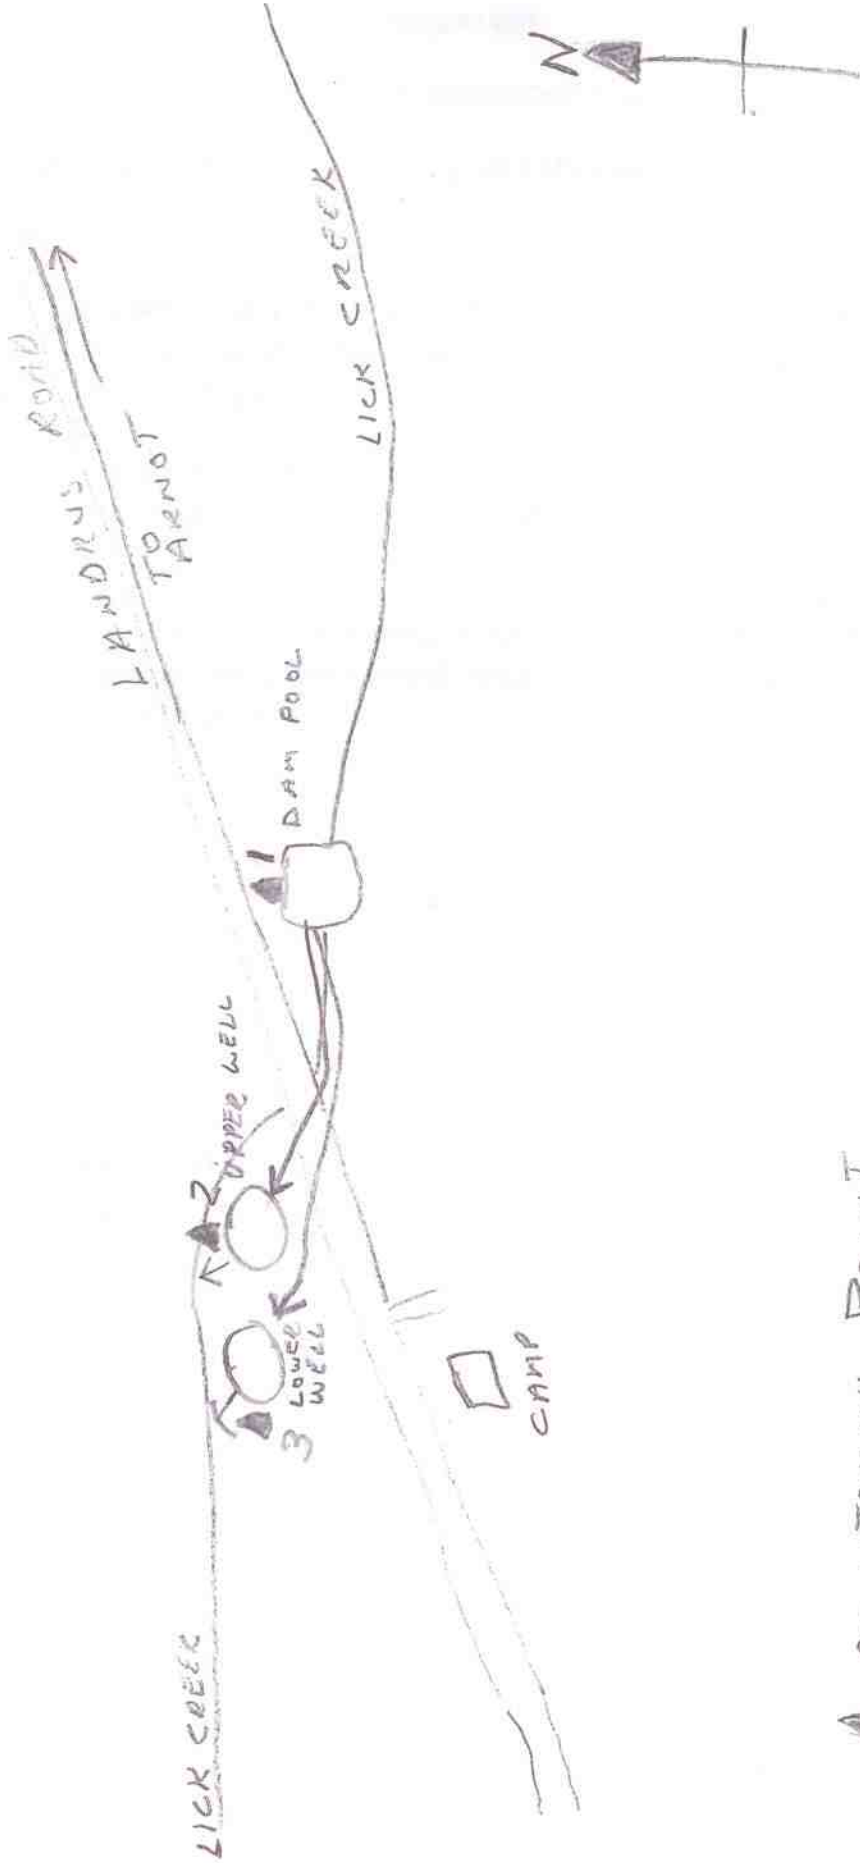

▲ MONITORING POINT
MARKED WITH METAL SIGN