

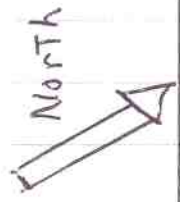





LLRO-D13/15 PA-253

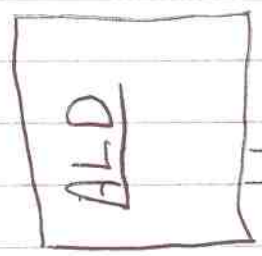

Long Run Road

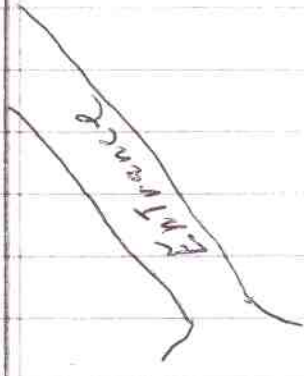

Sample point A

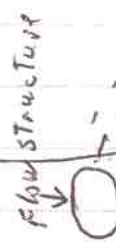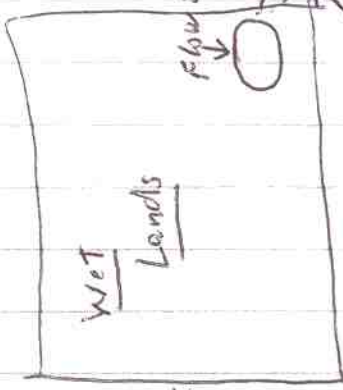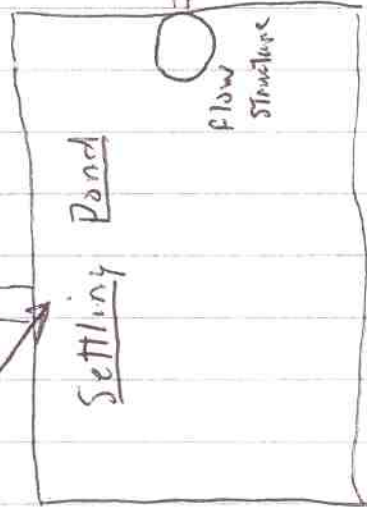

Sample point B

Limestone channel

Longs Run stream