
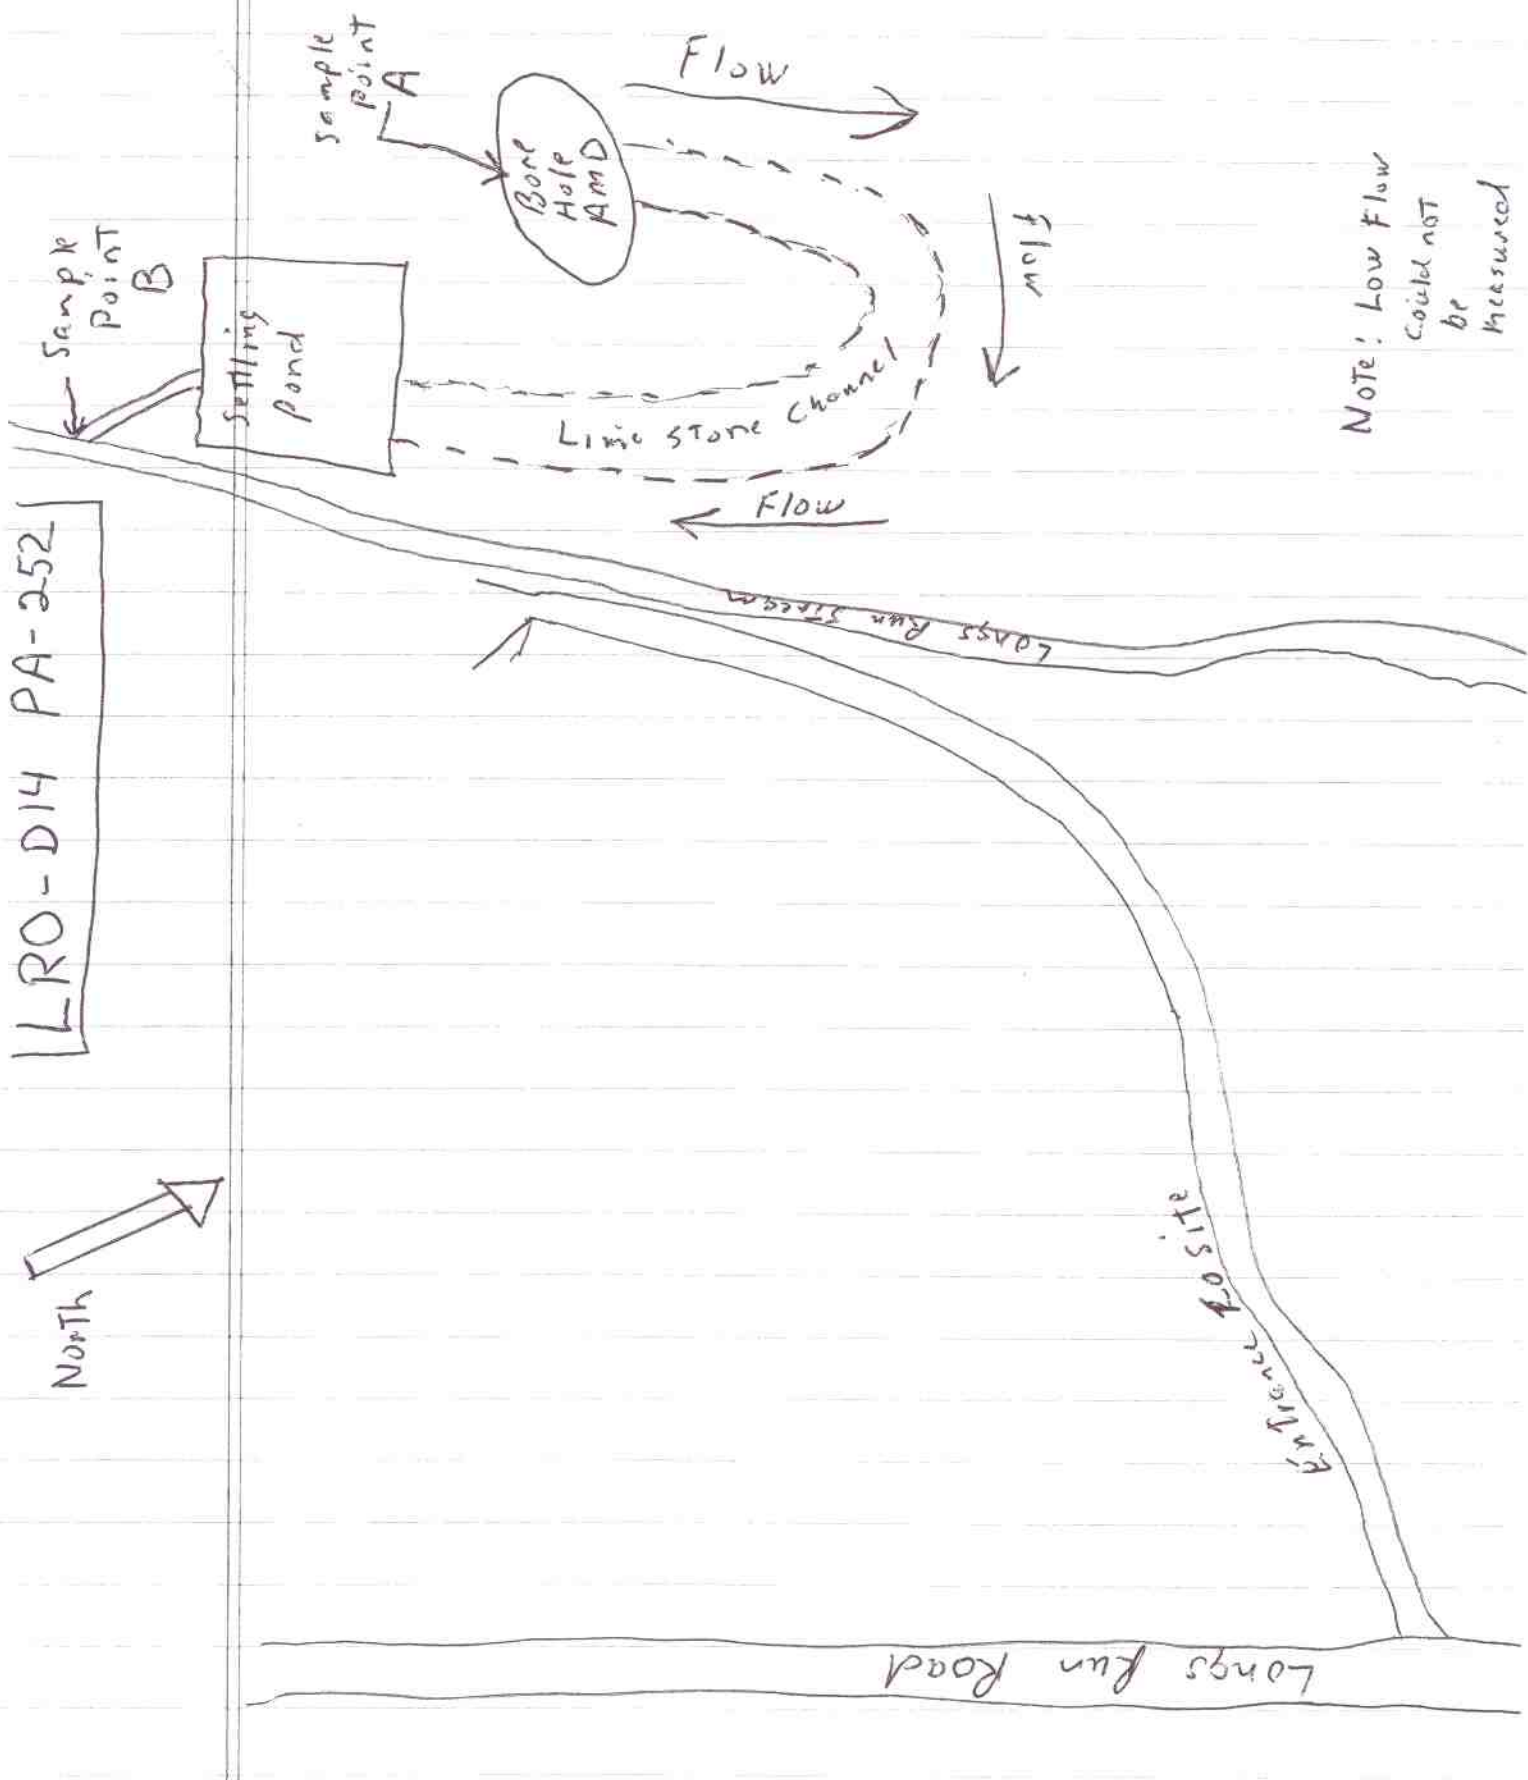


LRO-D14 PA-252

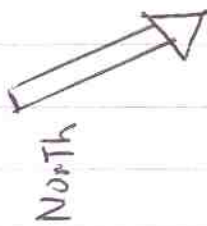

Note: Low Flow
could not
be
measured