


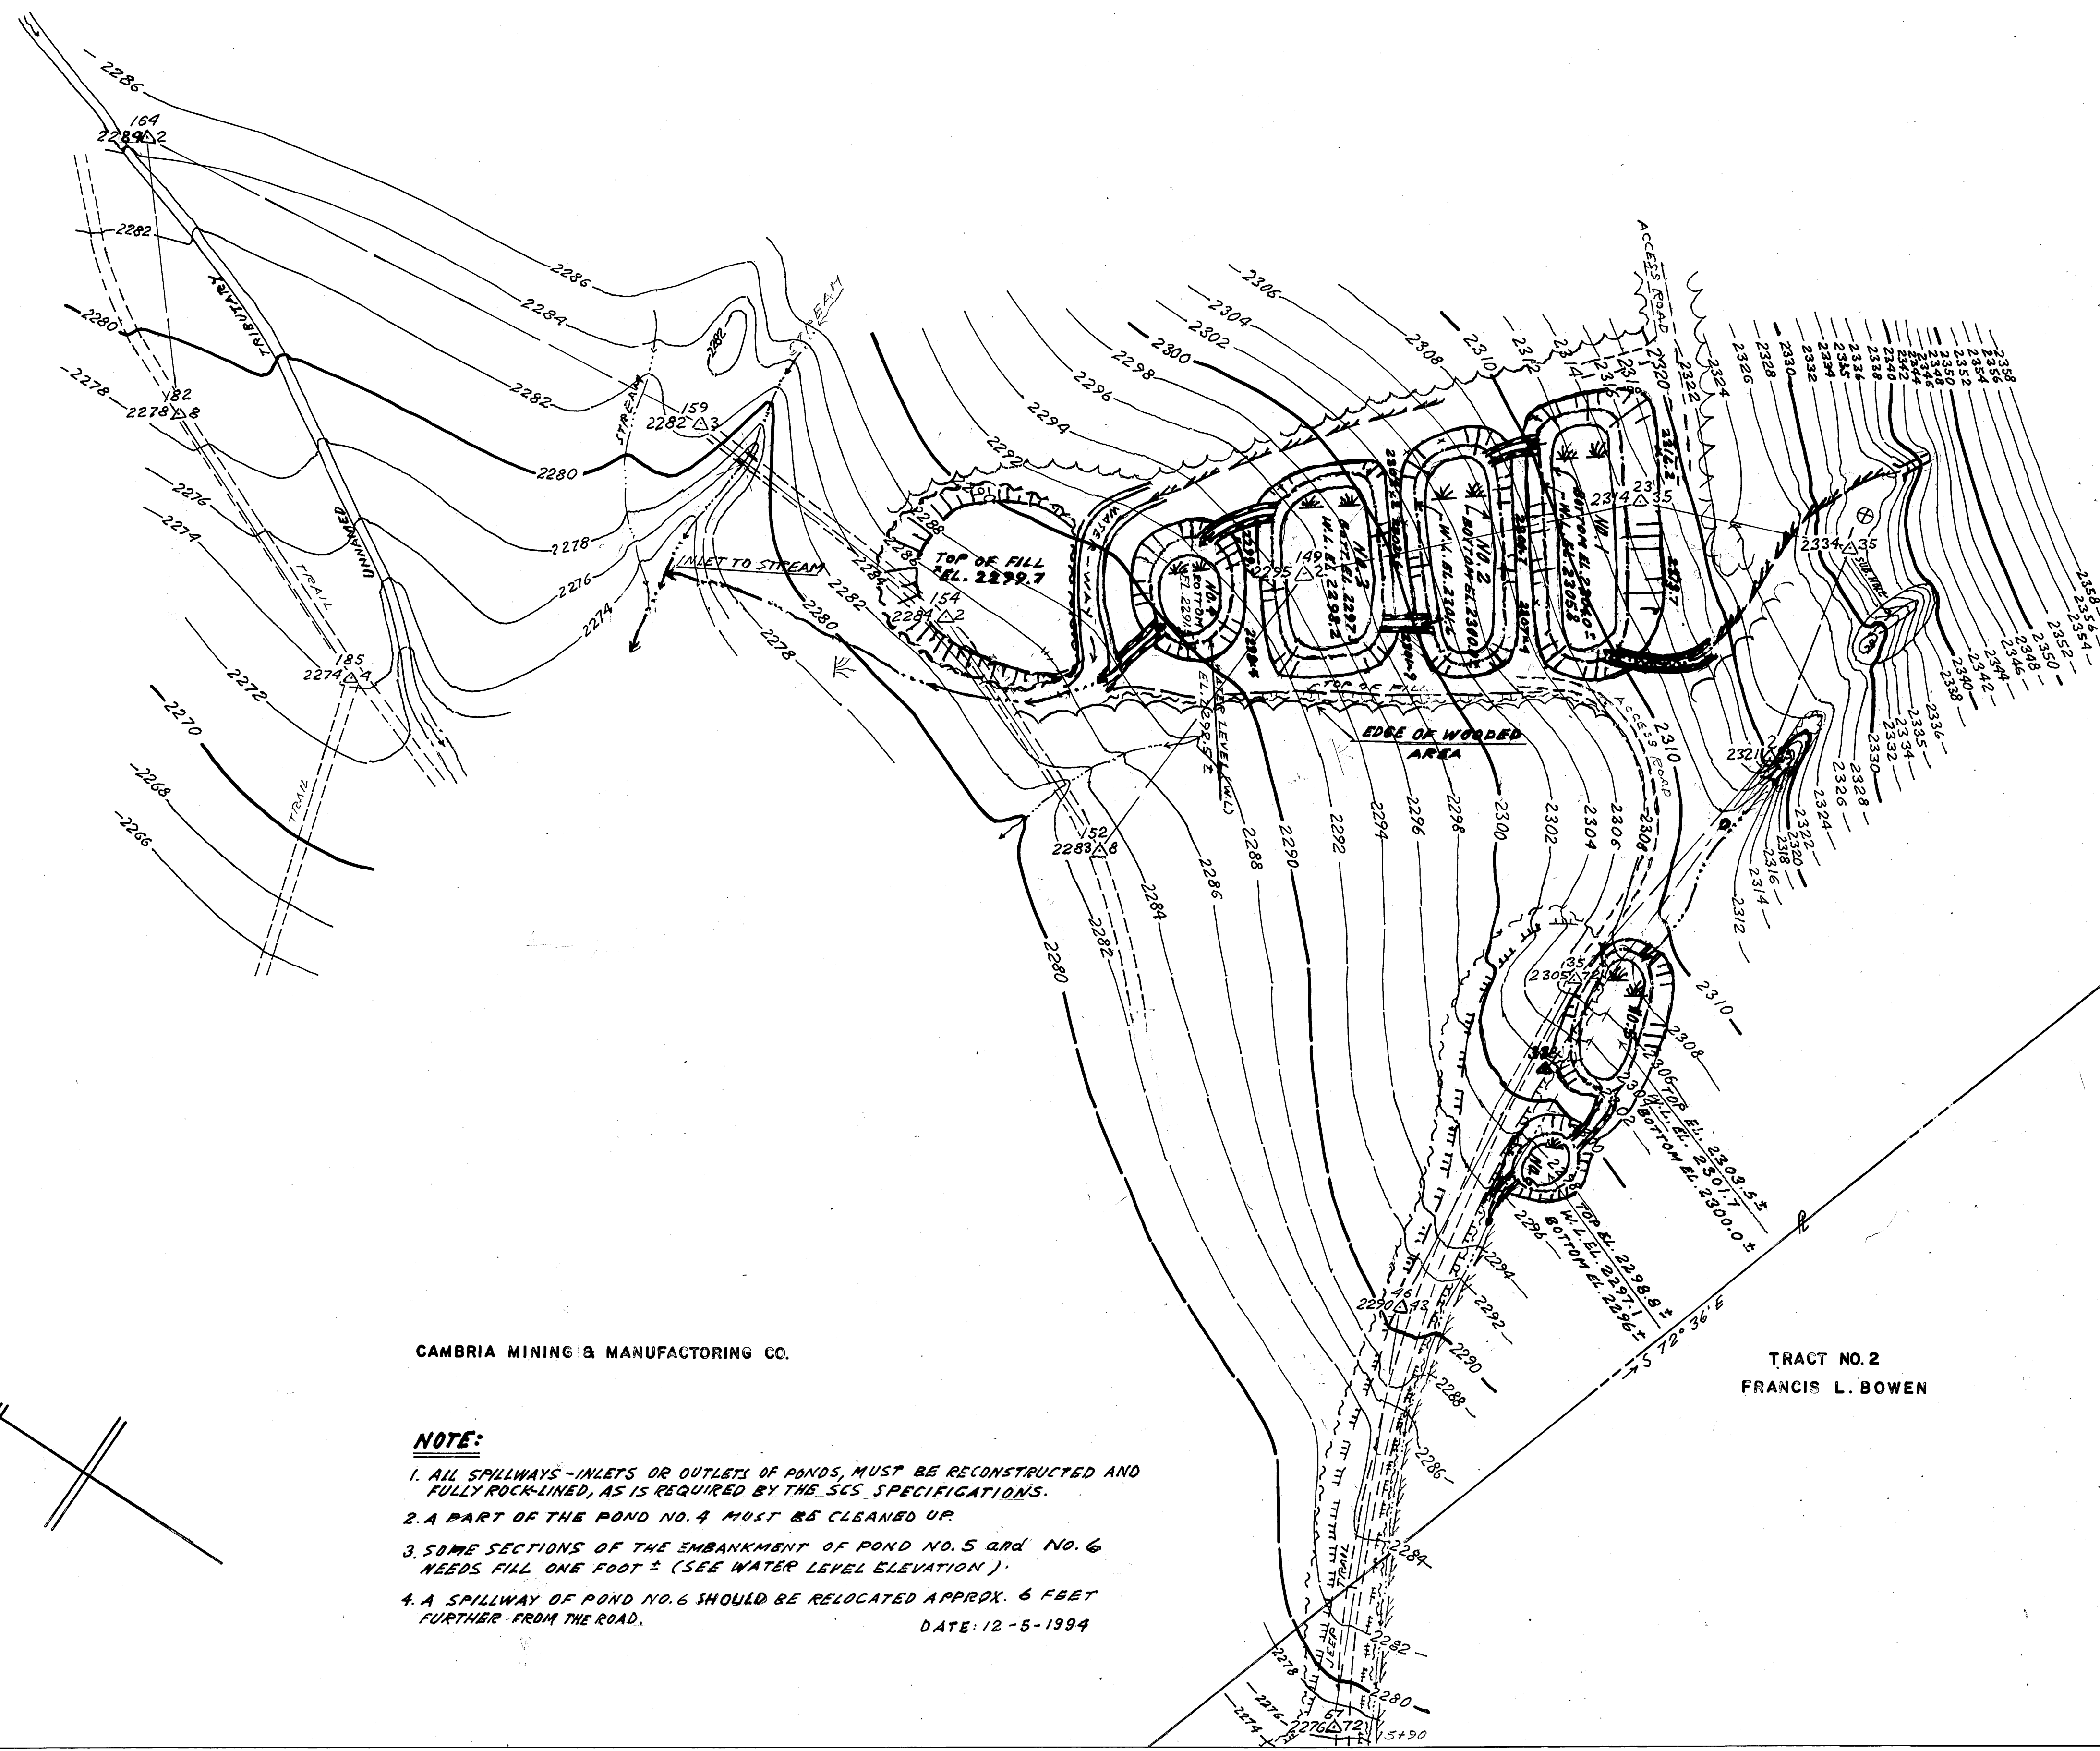

CAMBRIA MINING & MANUFACTURING CO.

TRACT NO. 2
FRANCIS L. BOWEN


NOTE:

1. ALL SPILLWAYS-INLETS OR OUTLETS OF PONDS, MUST BE RECONSTRUCTED AND FULLY ROCK-LINED, AS IS REQUIRED BY THE SCS SPECIFICATIONS.
2. A PART OF THE POND NO. 4 MUST BE CLEANED UP.
3. SOME SECTIONS OF THE EMBANKMENT OF POND NO. 5 AND NO. 6 NEEDS FILL ONE FOOT ± (SEE WATER LEVEL ELEVATION).
4. A SPILLWAY OF POND NO. 6 SHOULD BE RELOCATED APPROX. 6 FEET FURTHER FROM THE ROAD.

DATE: 12-5-1994

LEGEND

1. --- ACCESS ROAD
2. X K EXISTING CULVERT
3. X K PROPOSED CULVERT
4. D# PROPOSED DIVERSION DITCH
5. P APPARENT PROPERTY LINE
6. --- LIMIT OF CONSTRUCTION
7. --- PROPOSED ROCK-LINED CHANNEL
8. No. SURVEY TURNING POINT
9. --- BRIDGE
10. CPP PROP. CORRUGATED PLASTIC PIPE
11. --- WATER LINE
12. --- POWER LINE
13. --- GAS LINE
14. --- TOP OF BONEY PILE
15. --- TOE OF BONEY PILE
16. WET SPOT - SLEEP
17. SPRING
18. WETLAND
19. --- STREAM (PRIMARY)
20. --- STREAM
21. No. SAMPLING POINT
22. --- STREAM-APPROX. LOCATION
23. TEST HOLE - WET
24. TEST HOLE - DRY
25. MINE
26. EL. SURFACE CONTOUR (TWO FEET)
27. LARGE ROCK
28. SUBSURFACE DRAIN
29. PROPOSED WETLAND POND
30. PROPOSED POND

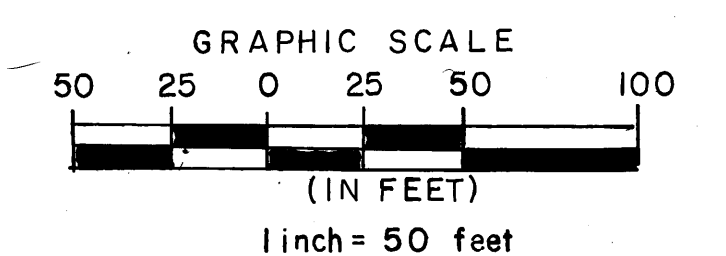

WETLAND PONDS-LOCATION MAP

CHRISTIE HOLLOW RUN & BEAR ROCK RUN -

PROJECT
WASHINGTON TWP, CAMBRIA COUNTY, PENNA
PROJECT CO-ORDINATOR: TERRY KAKTINS, GEOLOGIST
MAP PREPARED BY: ANDY CIOK DATE: JAN 1994
DESIGNED BY: ANDY CIOK DATE: FEB 1994
DRAWN BY: ANDY CIOK DATE: MAY 1995
CHECKED BY: DATE: TITLE: _____
APPROVED BY: DATE: TITLE: _____