

*Copy — Cambria
Office
File*

**SHOUP'S RUN WATERSHED ASSOCIATION
MINERSVILLE PASSIVE TREATMENT SYSTEM
CARBON TWP., HUNTINGDON CO.**

**OPERATION, MAINTENANCE AND
REPLACEMENT PLAN**

**Prepared By:
Musser Engineering, Inc.
7785 Lincoln Highway
Central City, PA 15926-8032
(814) 754-8477**

**RECEIVED
DEPT ENV PROTECTION**

JAN 29 2004

CAMBRIA OFFICE

**Shoup's Run Watershed Association
Minersville Passive Treatment System
Carbon Twp., Huntingdon Co.**

Introduction

The Minersville Passive Treatment System was designed to treat acid mine drainage flowing from 4 separate deep mine openings. During the construction of the system, a refuse pile and abandoned open pit were also reclaimed.

The discharges were treated using a passive system containing collection pipes, a VFS pond, a wetland, a settling pond, and a dewatering pond. As-built plans for the facility are attached.

The only major problem encountered during construction was a groundwater discharge in the base of the VFS pond. The discharge emanated from the base of the highwall adjacent to the VFS pond. The quality of the discharge was good and therefore, the contractor constructed a rock collection drain along the highwall which conveyed the water beneath the VFS pond and into the wetland pond. The contractor covered the rock drain in geotextile and then placed a clay seal over the drain to seal it from the VFS pond. Unfortunately, some water from the VFS pond is leaking from the VFS pond through the clay seal and into the rock drain. This situation should be monitored to determine the effect on system performance before deciding if any remediation is necessary.

The treatment system is designed for a 25-year life span.

Responsible Parties:

Shoup's Run Watershed Association

- overall facility operation
- treatment system maintenance
- replacement - N/A

Pennsylvania State Game Commission

- overall maintenance of vegetation and access roads

RECEIVED
DEPT ENV PROTECTION

JAN 29 2004

CAMBRIA OFFICE

Operation

Shoup's Run Watershed Association is responsible for the overall operation of the Minersville Passive Treatment System.

Water Sampling:

The quality and quantity of the water flowing through the system should be monitored on a quarterly basis. Samples are being analyzed at the Commonwealth of Pennsylvania lab. Quantity of flow into the system is not possible to measure, however, the quantity of discharge exiting the system can be measured at each outflow. The association can use a bucket and stopwatch or install weirs in the outflow channels. Records of all samples must be maintained in order to evaluate system performance.

For more information, please contact the following:

Access Road and Pipe Culverts

Pennsylvania Game Commission

- All access roads and pipe culverts around the site are the responsibility of the P.G.C. and are maintained by the P.G.C. during their normal maintenance schedule.

Maintenance

Removal and Disposal of Precipitate or Sediment:

All the ponds are designed to hold many years worth of sediment before cleaning the facility. They will be monitored to see when cleaning is necessary.

Maintenance of Channels; Industrial Cleaning of Pipes; Repairing Damage After Major Storm Events; and Repairing Cracks or Leaks:

All water conveyance channels must be kept free of all debris which could block the channel or be washed from pond to pond.

The VFS system is equipped with cleanouts which may be used to rotary clean or snake-out any pipes which may need cleaned.

Damage to the ponds and ditches should be identified as soon as possible following damage by storm water. If cracks or leaks are identified, the engineer should be contacted to develop a remediation plan.

Adding Limestone, Compost, Sand, or Gravel:

Compost should be added if the compost layer thins to 12+ inches. Compost generally will only need added every 10-15 years. Funding for compost will be provided by additional grants and/or private funds.

Repairing Vandalism Damage:

In order to keep the system operating properly, any vandalism should be repaired promptly. If the vandalism is severe and threatens the integrity and operation of the system, the chairperson of the Watershed Association will contact DEP personnel to assist in making the necessary repairs.

Adjusting Grades or Outlet Structures:

The VFS outflow pipe elevation may be adjusted by raising or lowering the Fernco adaptor. Adjusting this elevation will control the elevation of the water level in the VFS pond. The pipe is currently set at the correct elevation and should not need adjustment. The water level should be maintained a minimum of 2 feet above the compost layer and 2 feet below the crest of the VFS pond embankment.

System Replacement

The Minersville Passive Treatment System was designed for 25 years. During that time the system must be maintained by removing sludge and adding compost as required and following the suggestions in the approved O.M. & R. Plan. Because the design life is 25 years, responsibility for replacement of the system is beyond the scope of this plan.

RECEIVED
DEPT ENV PROTECTION

JAN 29 2004

CAMBRIA OFFICE

Signature Page

The signing of this Operations, Maintenance and Replacement (O.M. & R) Plan by an authorized representative of the Sponsors indicates that the Sponsors have reviewed the O.M. & R. plan for the Minersville Passive Treatment System and concur with the assigned responsibilities and obligations.

IN WITNESS WHEREOF, the sponsors hereto have hereunto set their hands and seals the day and year written here.

Signing of this plan was completed on _____.

WITNESS:

Shoup's Run Watershed Association

_____ responsible official's name and title

_____ responsible official's name and title

Pennsylvania Game Commission

_____ landowner's or responsible official's name

RECEIVED
DEPT ENV PROTECTION

JAN 29 2004

CAMBRIA OFFICE

**Shoup's Run Watershed Association
Minersville Passive Treatment System
Carbon Twp., Huntingdon Co.**

Maintenance Check List

Date: _____

Inspector: _____

Intake #1

_____ Keep debris and leaves away from intake area.

Comments: _____

Collection Manhole

_____ Check if water is entering from Intake #1 pipe.

_____ Check that water is properly flowing through system.

_____ Make sure cover is secure.

_____ Check outlet pipe.

NEVER ENTER COLLECTION MANHOLE!

Comments: _____

Manifold

_____ Check that flow is being evenly distributed out of manifold.
Adjust/clean discharge holes as necessary.

Comments: _____

VFS Pond

_____ Flush as needed.

_____ Add compost as necessary.

**RECEIVED
DEPT ENV PROTECTION**

JAN 29 2004

CAMBRIA OFFICE

- _____ Check outlet for calcium oxide build-up.
- _____ Maintain proper water level over compost.

Comments: _____

Wetland

- _____ Maintain wetland plants.
- _____ Check inlet and outlet pipes.

Comments: _____

Clarifying Pond/Wetland

- _____ Check inner and outer pond banks for leaks or slumping.
- _____ Maintain wetland plants in wetland area.
- _____ Check outlet pipe. (Look for calcium build-up)
- _____ Check flow patterns through wetlands. I.E. is the water going through the wetlands or around them?


Comments: _____

Diversion Ditches

- _____ Clean debris from diversion channels.

Comments: _____

RECEIVED
DEPT ENV PROTECTION
JAN 29 2004
CAMBRIA OFFICE

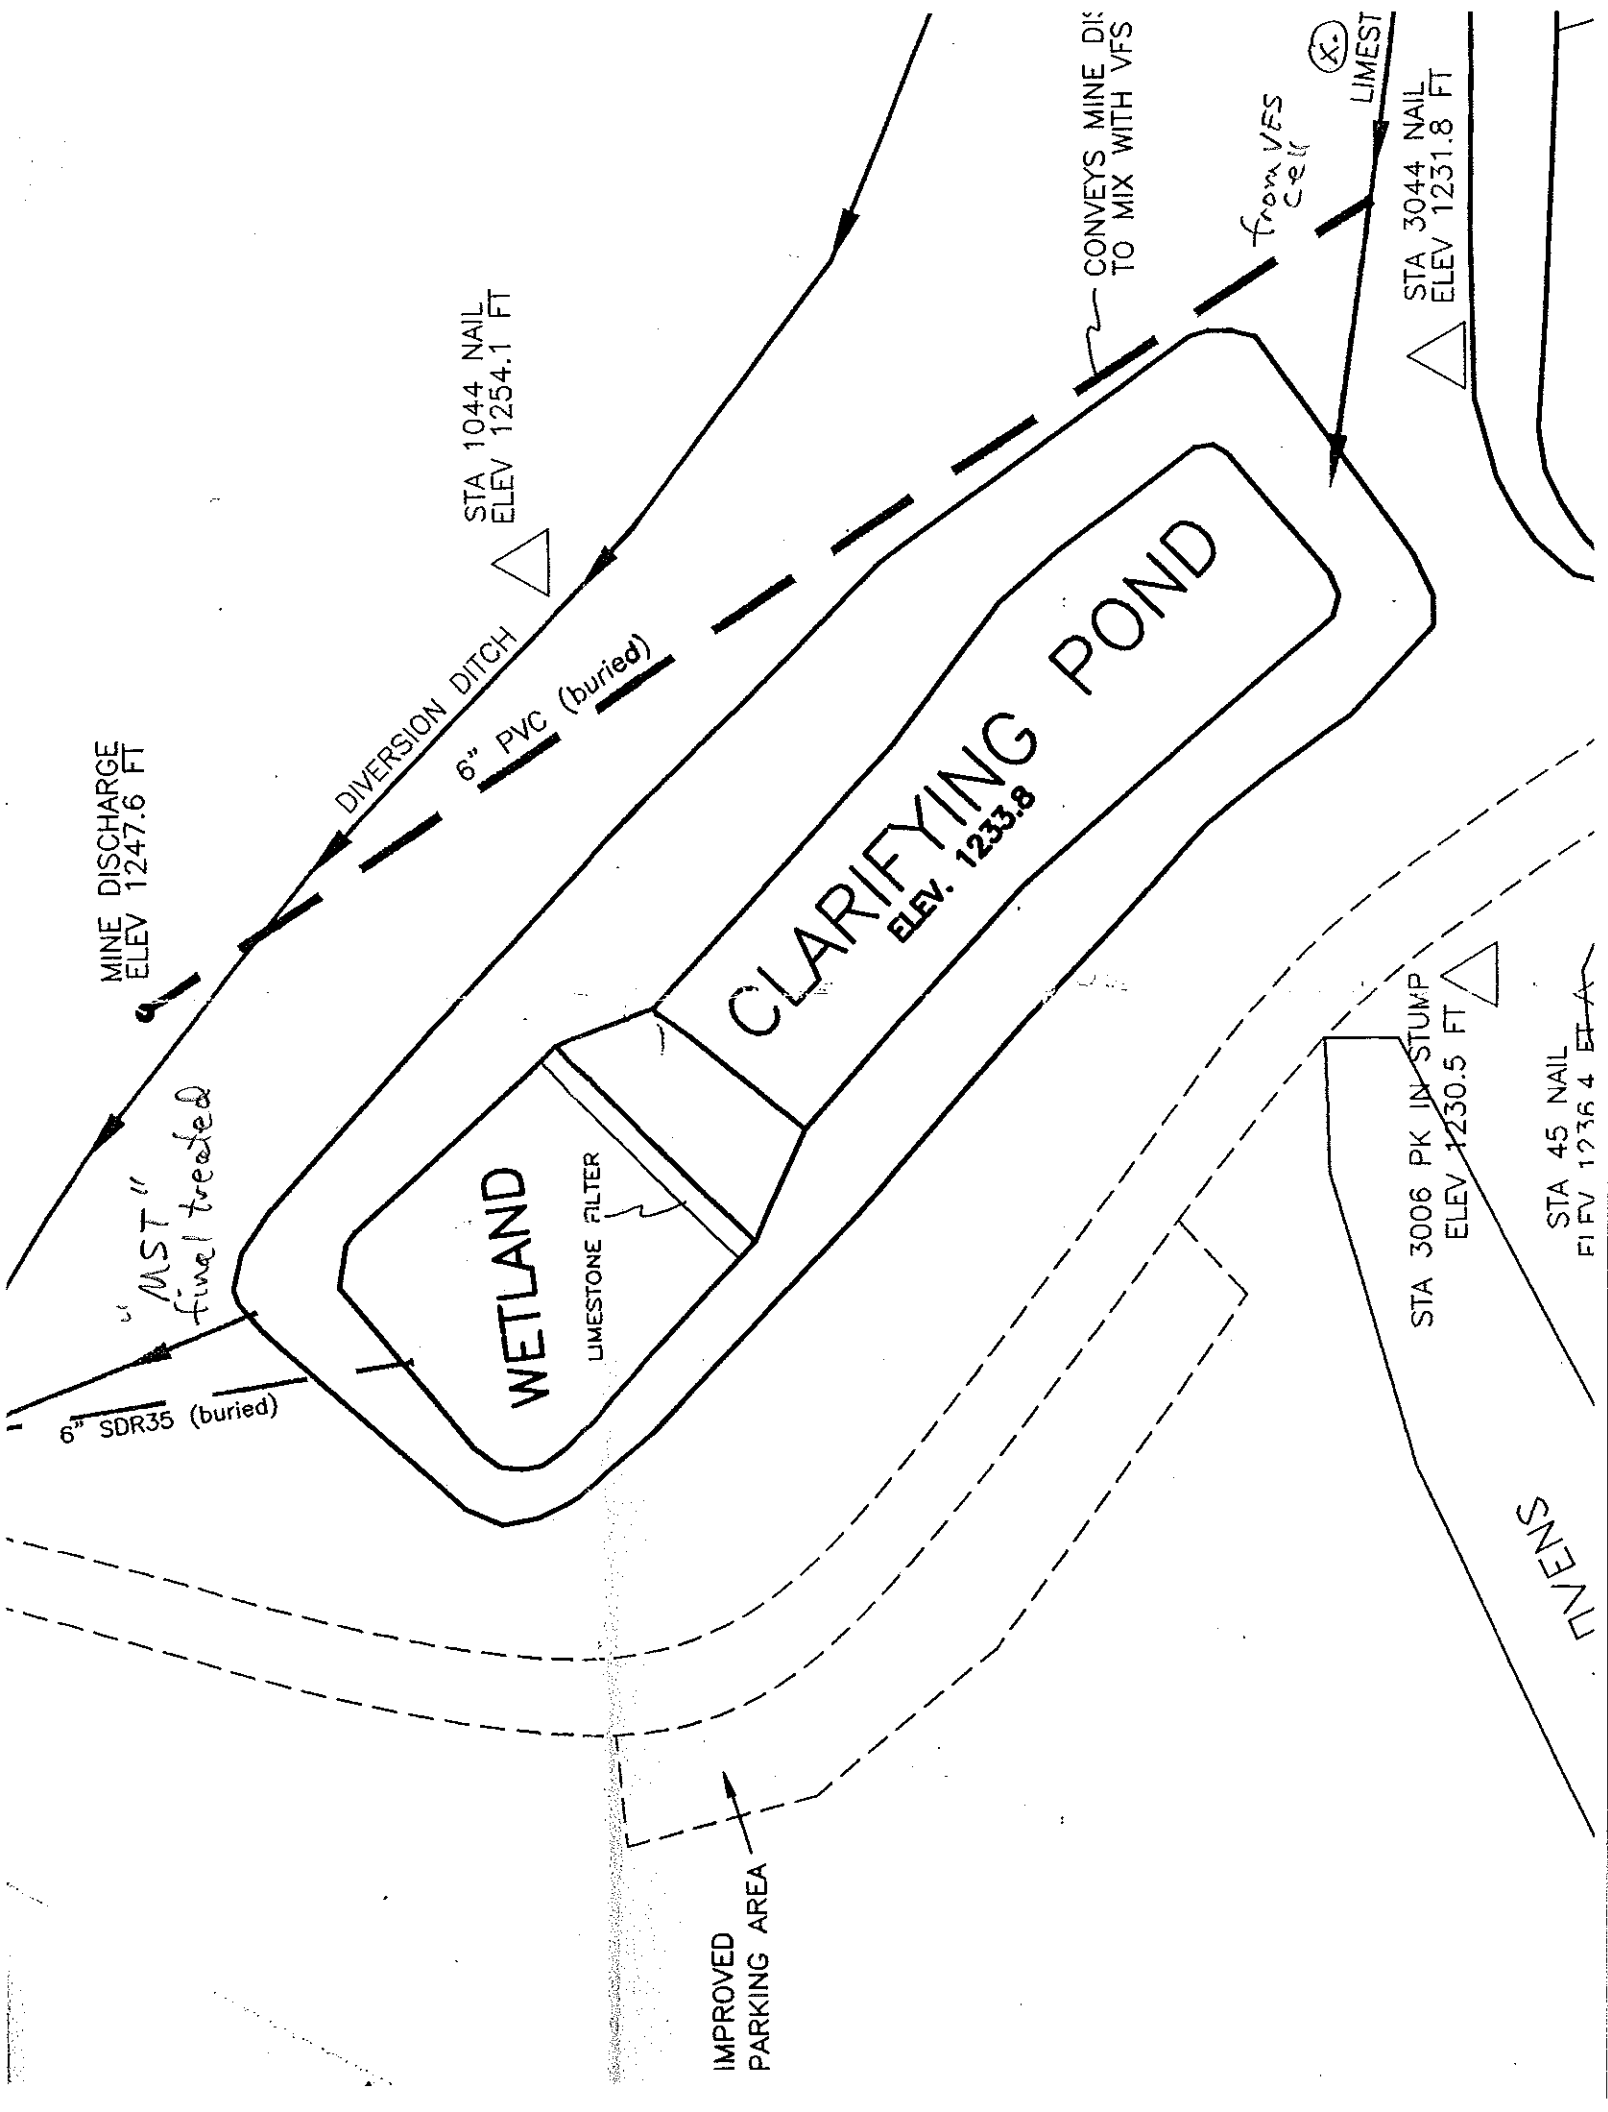

ARIFYING POND
Elev. 1233.8

CONVEYS MINE DISCHARGE
TO MIX WITH VFS OUTFLOW

VFS
CONTROL

OUTFLOW RISER

MINE
DEEP DRAIN

LIMESTONE CHANNEL

STA 3044 NAIL
ELEV 1231.8 FT

LIMESTONE FILTER

UNDERGROUND
PIPE

"RDT"

WETLAND
Elev. 1231

"MTW"

6" SDR 35 FLUSH PIPE

PROJECT
SIGN

SGC CORN.
193

6" SDR35
WETLAND DIS. PIPE

FLUSH PIPE
TO
OPEN VALVE TO
FLUSH VFS POND

MINE OPENING
ELEV 1248.8 FT HIGHWALL UNDER

VFS

CLEAN OUT

STA 1044 NAIL
ELEV 1254.1 FT SG

an FAMILY IN