PA 258- MRTUFF - Sampling as of 5/21/15

System A Normal Flow
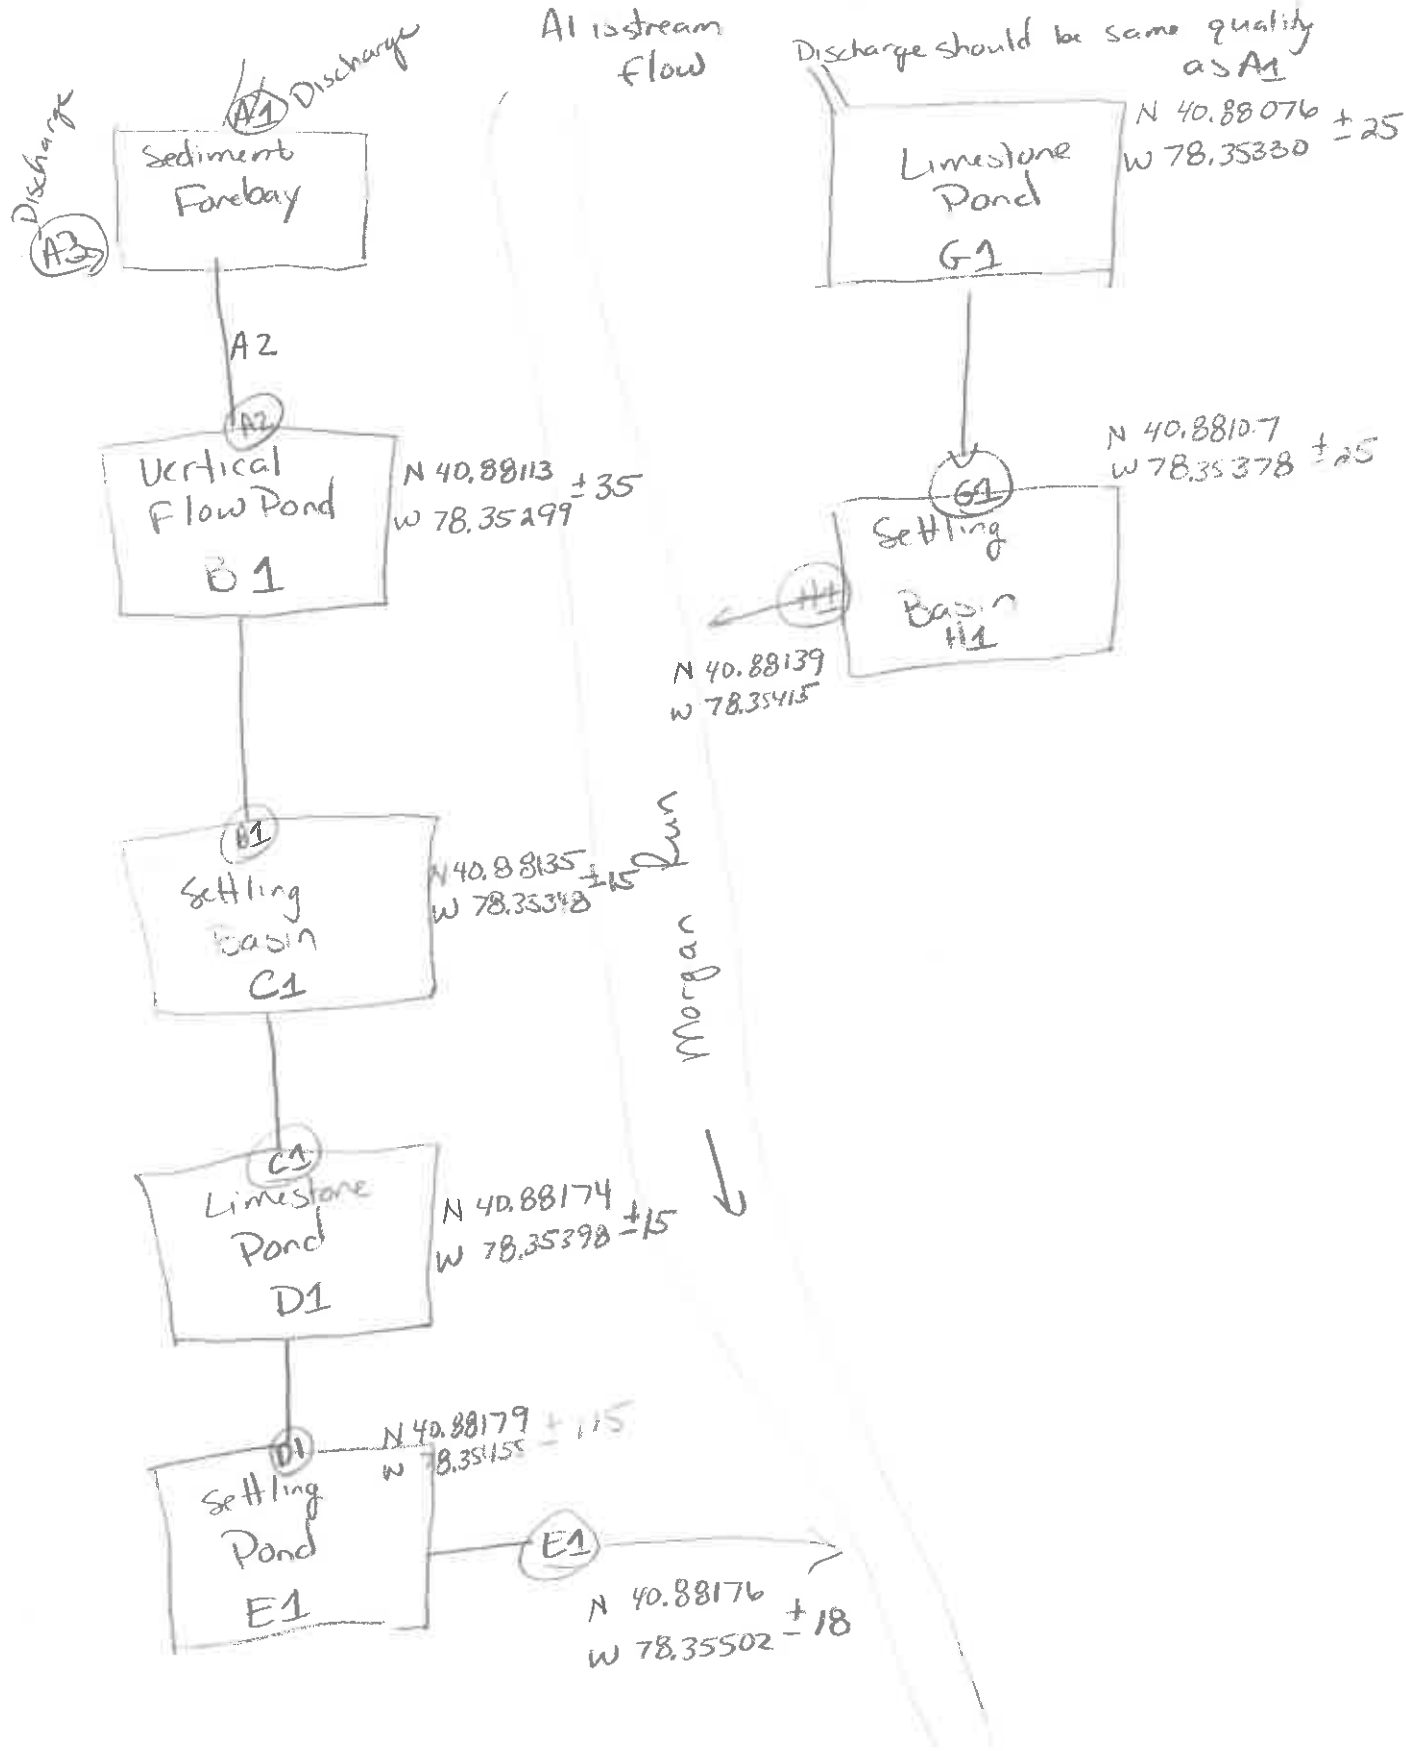
System B High Flow