




Clarion County Park

6-2-20 12 PM

* Not to scale.

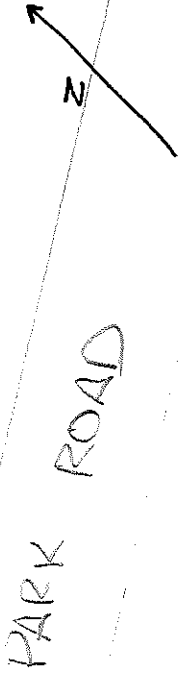

* ALD rebuilt
2019.

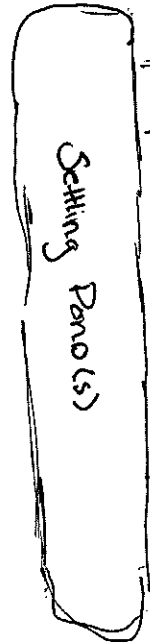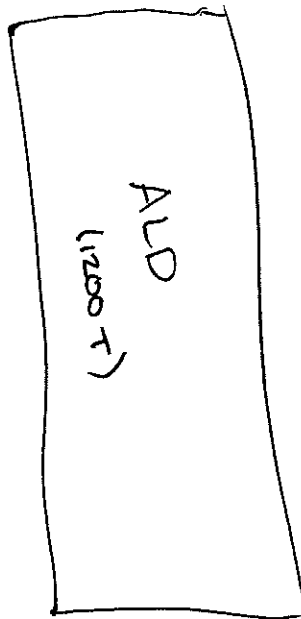

41.19905
-79.4335

84


FINAL DIS

pH 6.94
temp 21.8°C
TK 38
cond 1570
flow

83

ALD Discharge

pH 6.68
temp 13.7°C
TK 272 mg/L
cond 1790
flow 52.5 GPM

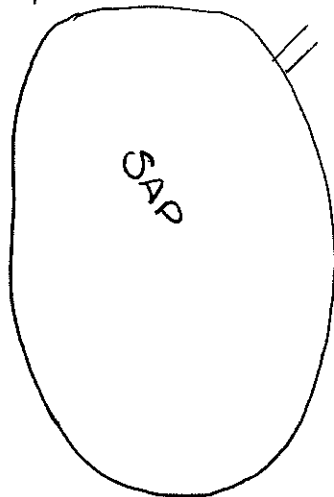

SAP
overflow

not enough
flow to sample