BLACKLICK CREEK WATERSHED ASSOCIATION RICHARDS AMD PASSIVE TREATMENT PROJECT


PHASE II CHERRYHILL TWP. INDIANA CO.


DATE: OCT. 2001


SCALE: 1"=50'


prepared by:




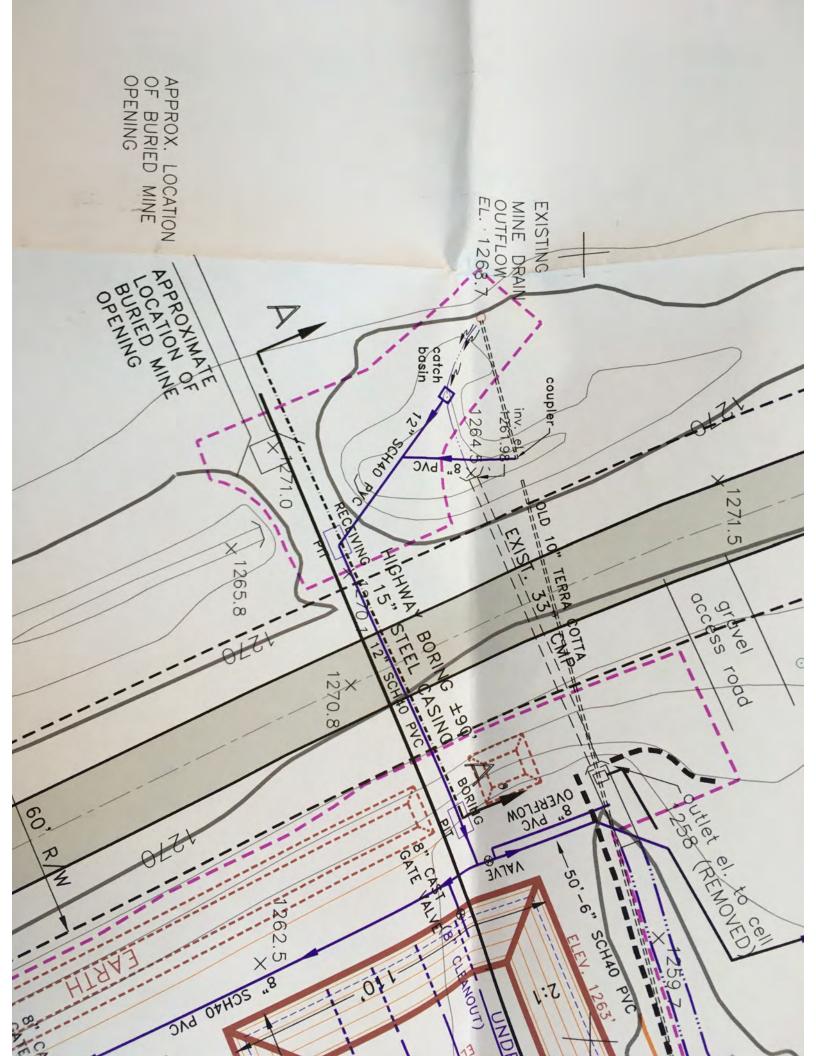


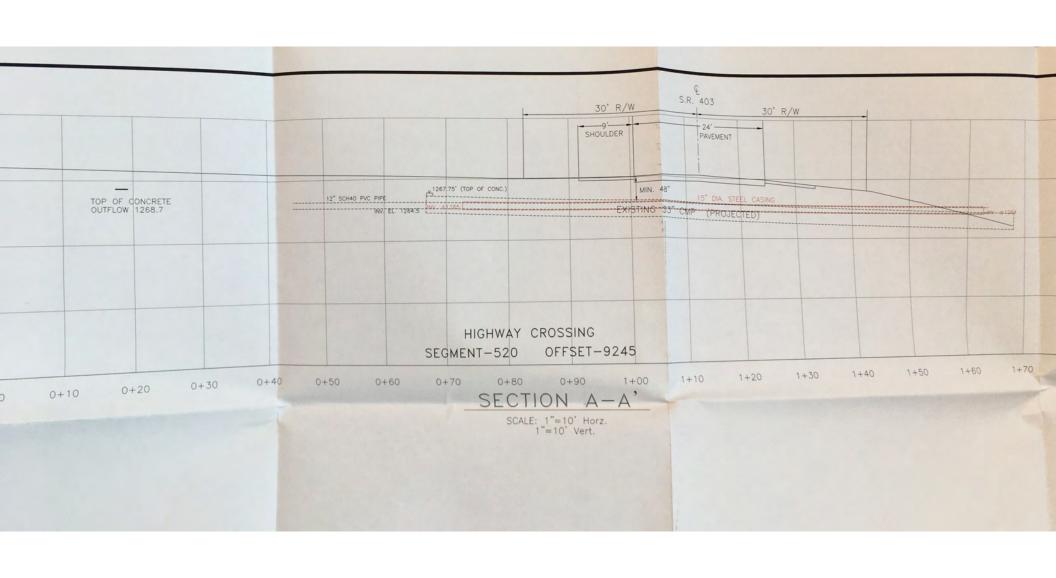


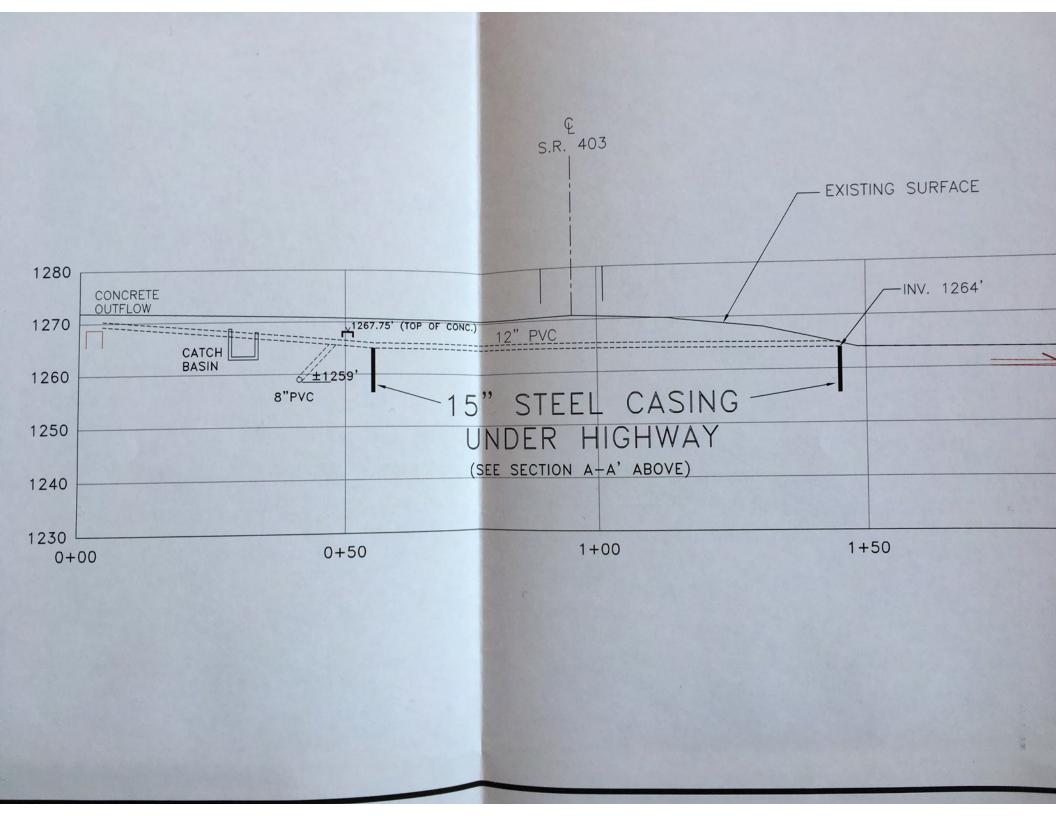


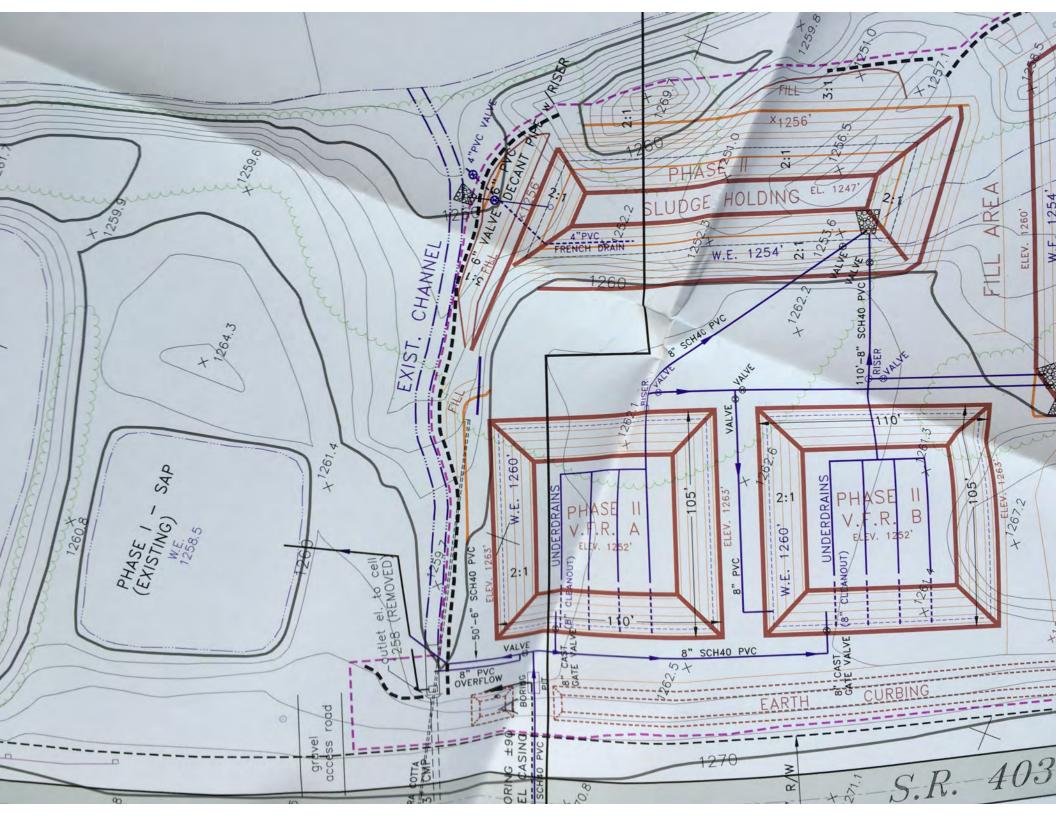


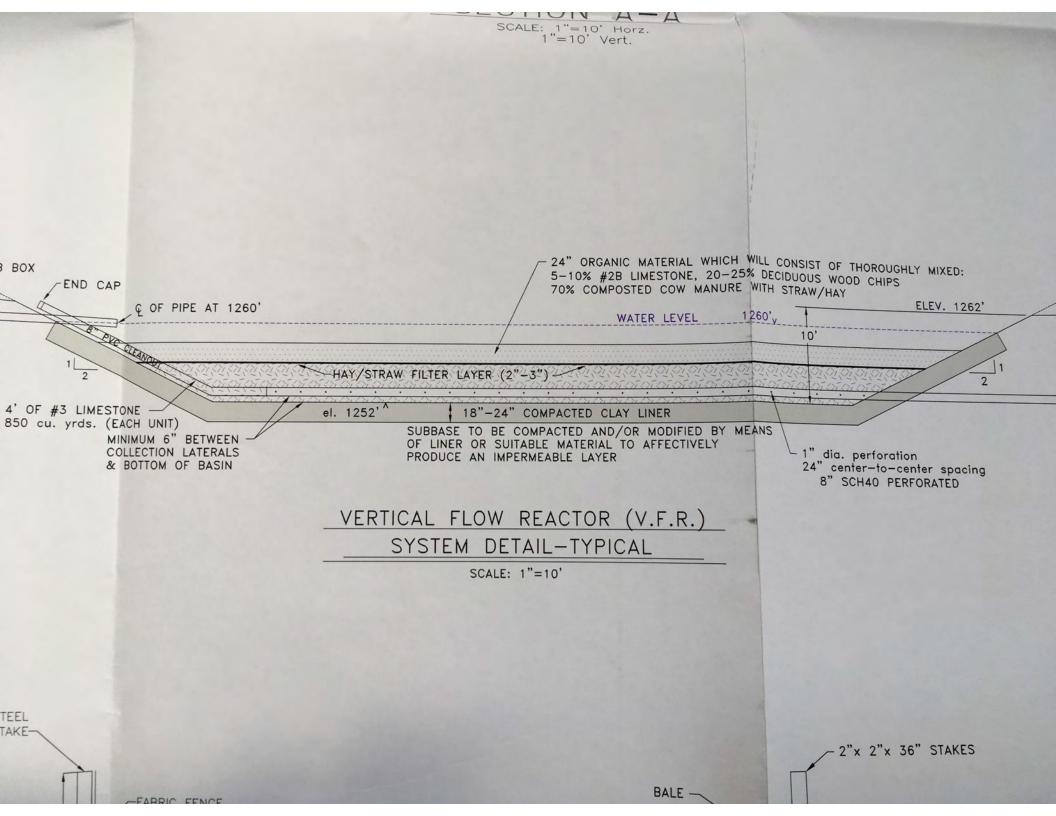

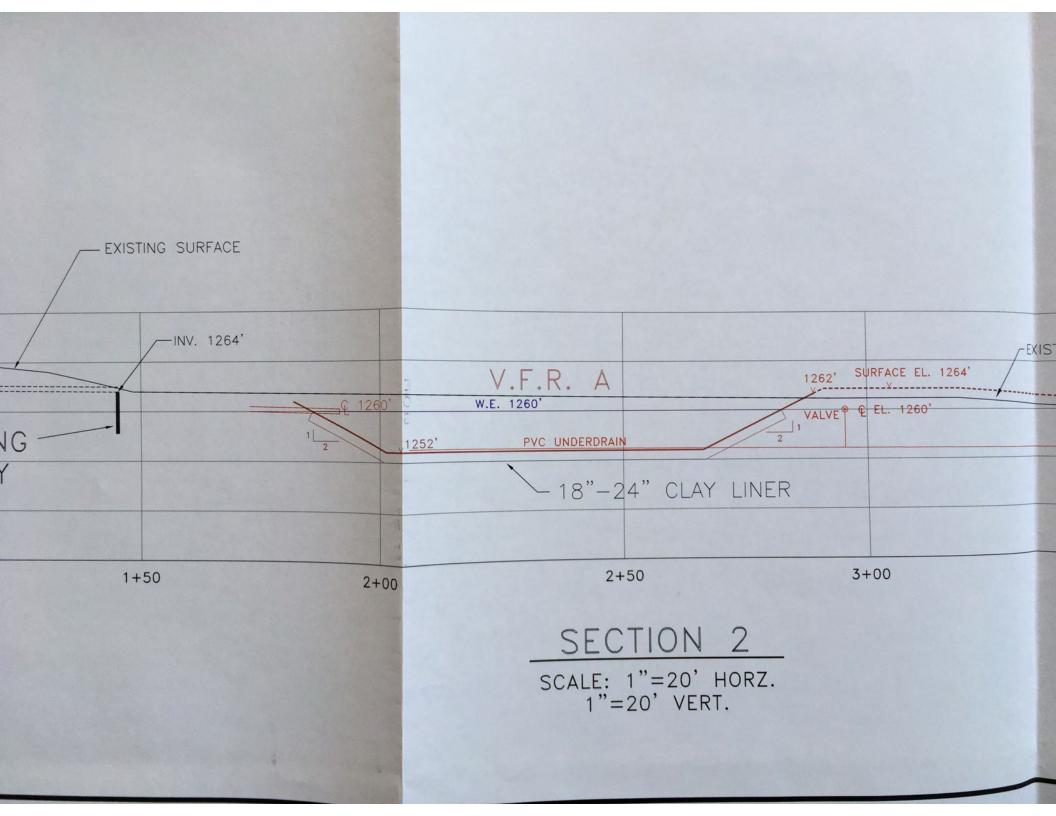


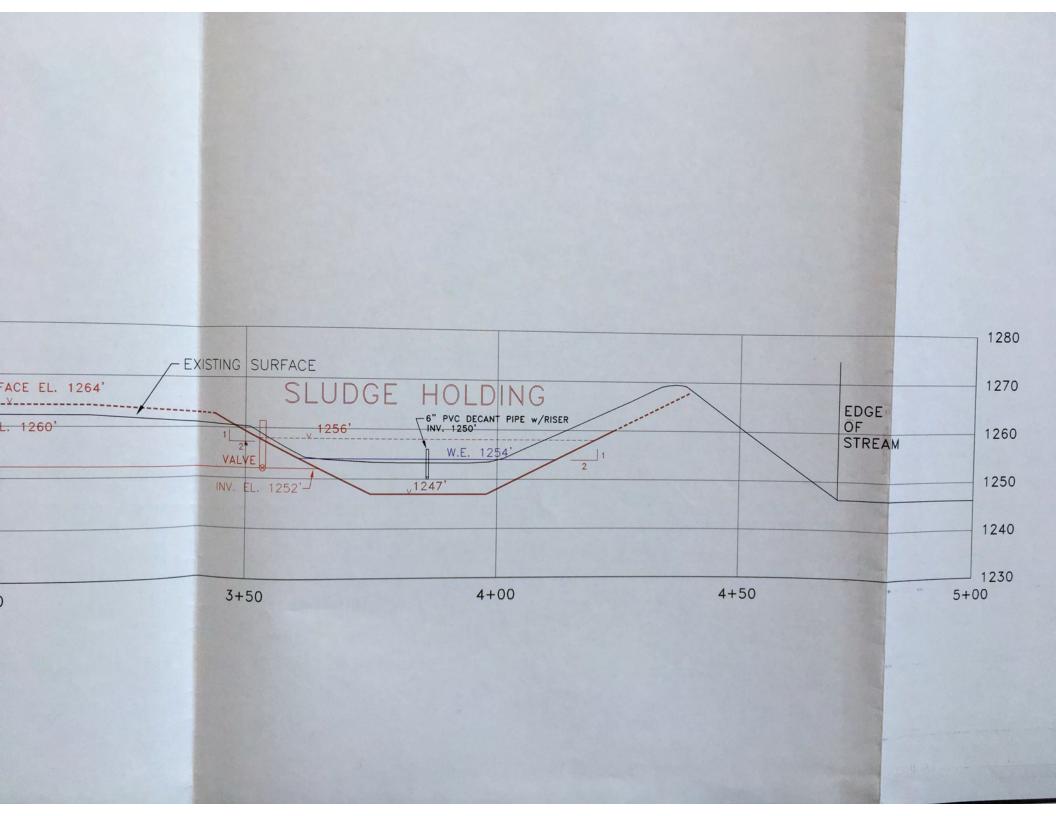

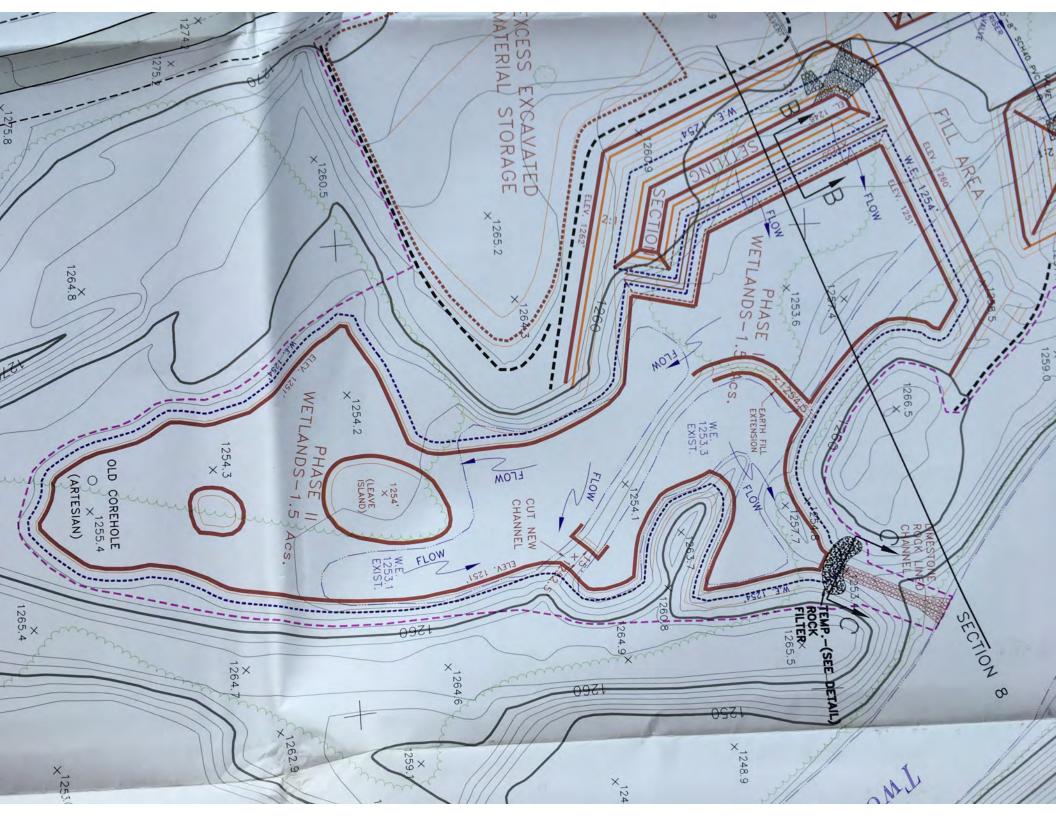

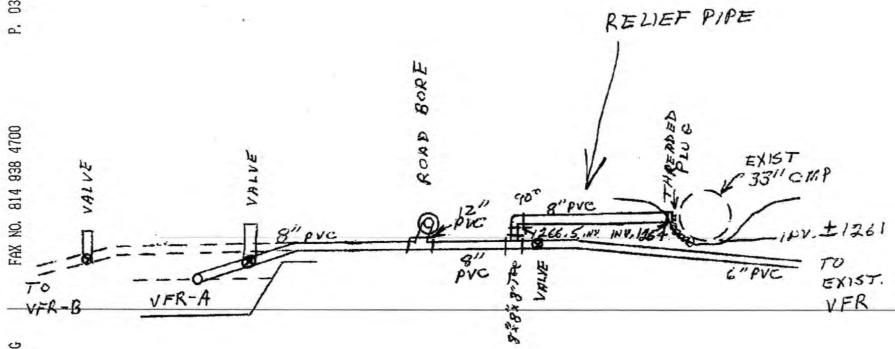

RICHARDS I RELIEF DISCHARGE PIPE (EXTRA WORK)

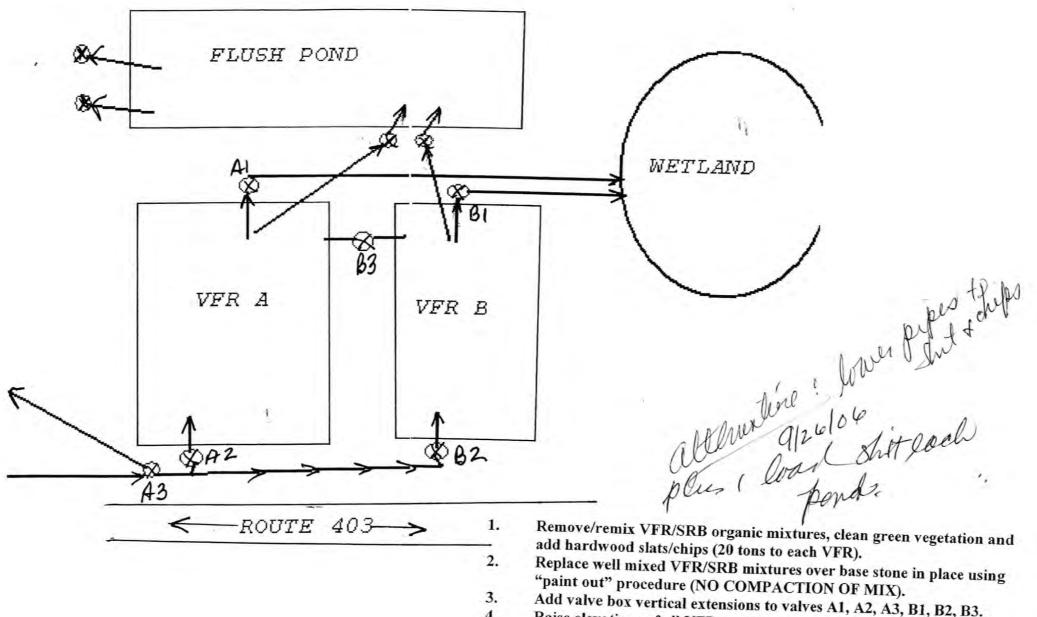

2.

add hardwood slats/chips (20 tons to each VFR).

Replace well mixed VFR/SRB mixtures over base stone in place using "paint out" procedure (NO COMPACTION OF MIX).

3. Add valve box vertical extensions to valves A1, A2, A3, B1, B2, B3. 4.

Raise elevations of all VFR pond berms by 2 feet with clay soils, keyed into present berms with minimum 8 foot wide tops for road access. (approx 750 while yards)

