


SX3-D7, D8 PA-268




North

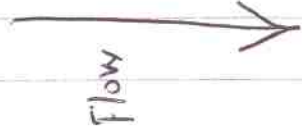

Flow


sample point A1A

AMD SX3-D7

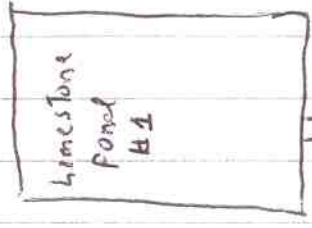

Flow Structure

AMD SX3-D8

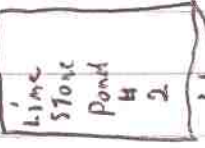

Flow Structure

sample point A2A



Settling Pond

Flow Structure

sample point B

Shavers Run Stream

ENIO Mountain Road

Note: Flow Too Low To Sample AMD Discharges