

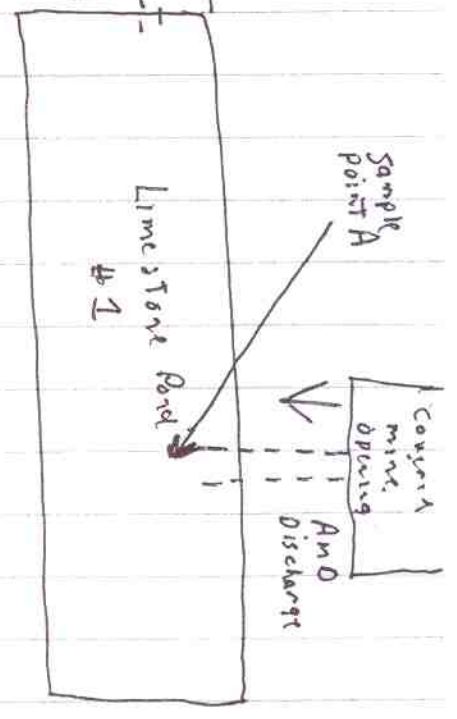


SK3-D9/SX0-D16 PA-262

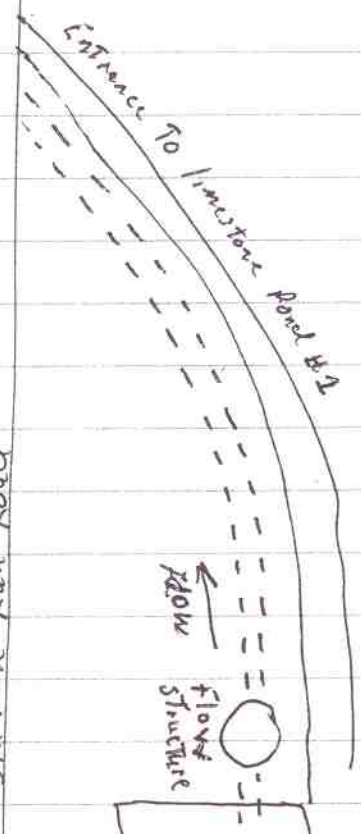

road and river x15

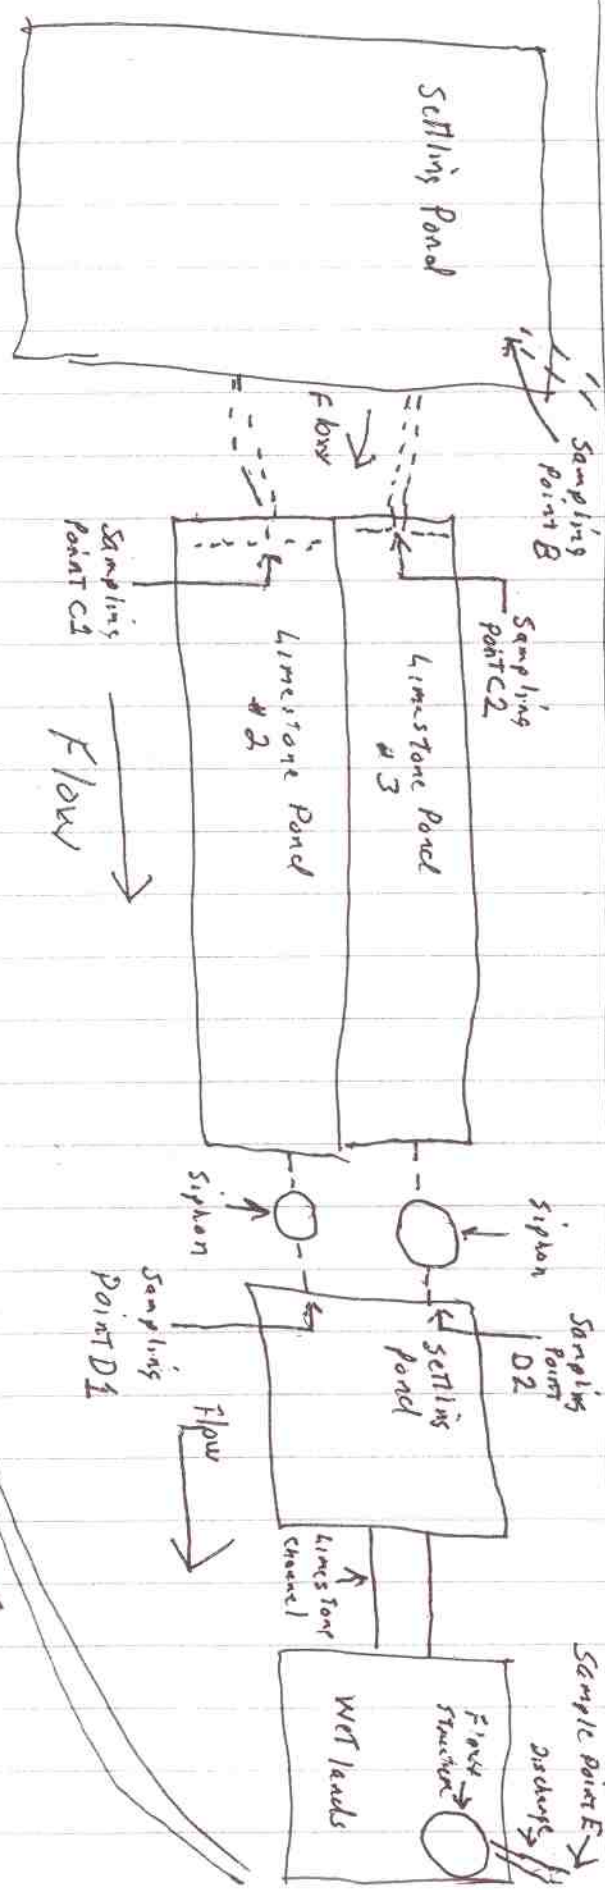

Six Mile Run Stream

