

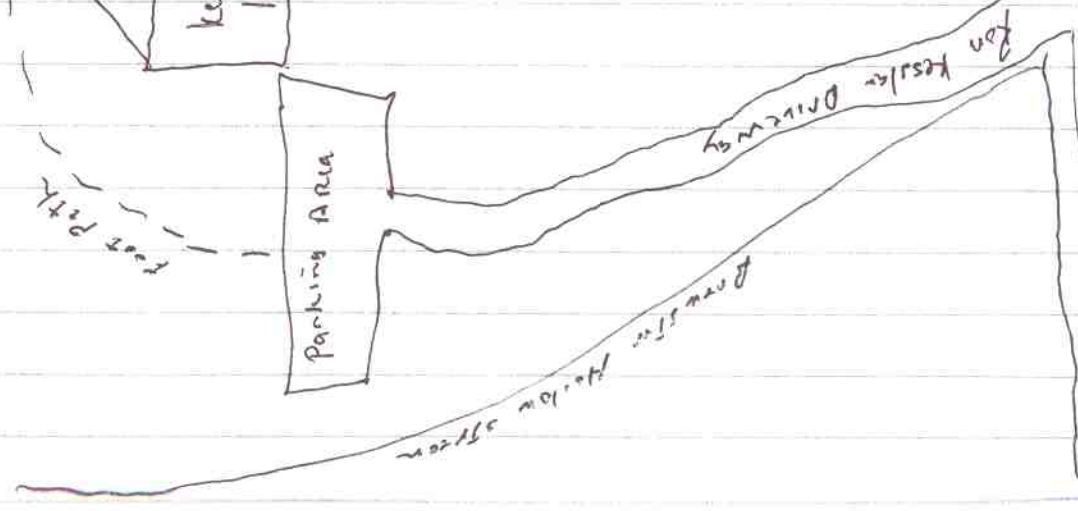
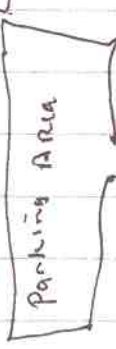
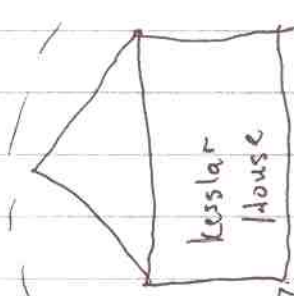
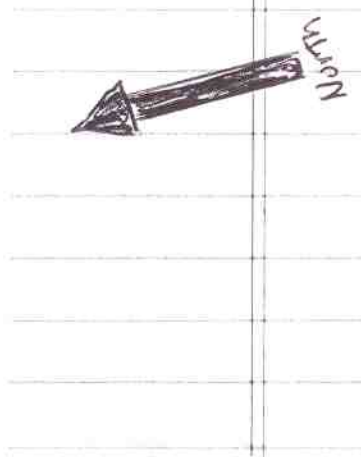
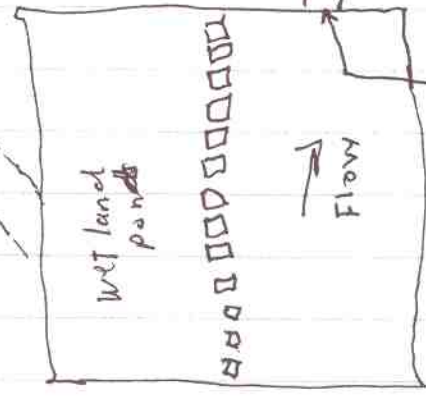


SX8A-D2 PA-2257

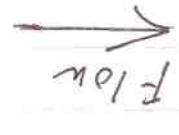

Hickory Hill Road

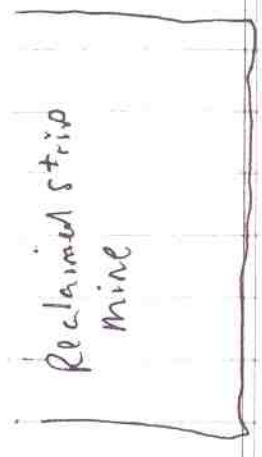

Sample point A

sample point B

Weir to stream

Stream

Brewster Hollow